




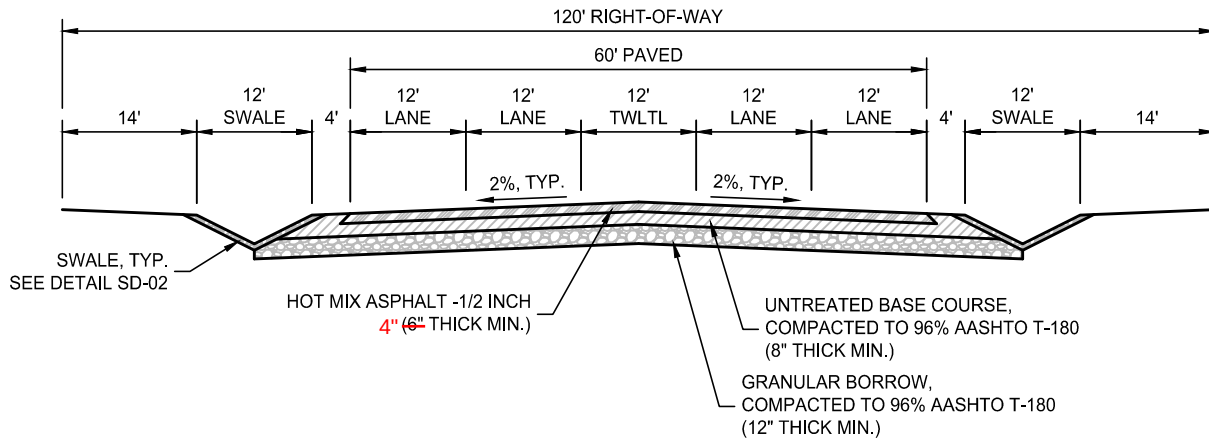

ARTERIAL

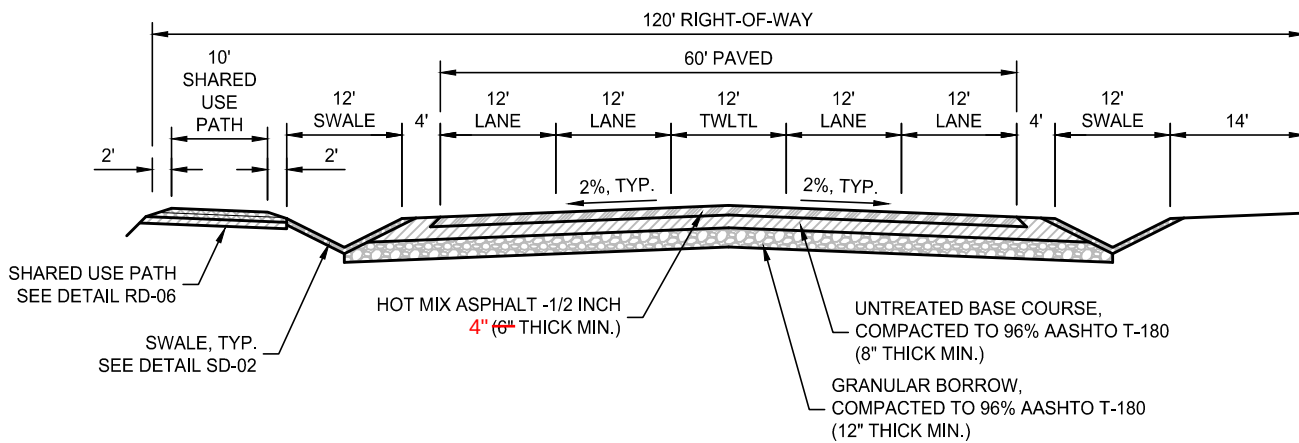

ARTERIAL with DIRT PATH

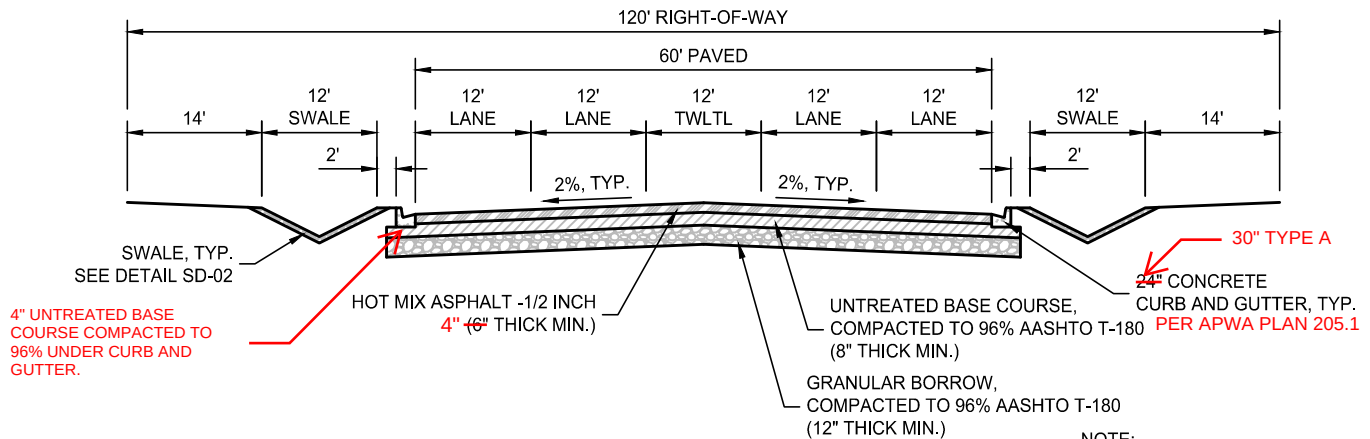

COMMERCIAL ARTERIAL

NOTE:

~~THICKNESSES MAY BE ADJUSTED PER GEOTECHNICAL REPORT.~~

DEPTHS MAY VARY CONTINGENT ON AASHTO PAVEMENT DESIGN. ALL PAVEMENT DESIGNS SHALL BE STAMPED BY PROFESSIONAL ENGINEER.

DRAWING NOT TO SCALE

PREPARED BY: JONES AND DEMILLE ENGINEERING, INC.

LAKE POINT STANDARD DRAWING



LAKE POINT
1528 SUNSET RD.,
LAKE POINT UTAH 84074
801-725-5096
lakepoint.gov

ARTERIAL ROAD SECTIONS


UPDATED: 1/25/2024

STANDARD DRAWING No.


RD-01

APPROVED:

DATE: 01-24 BY: M.L.

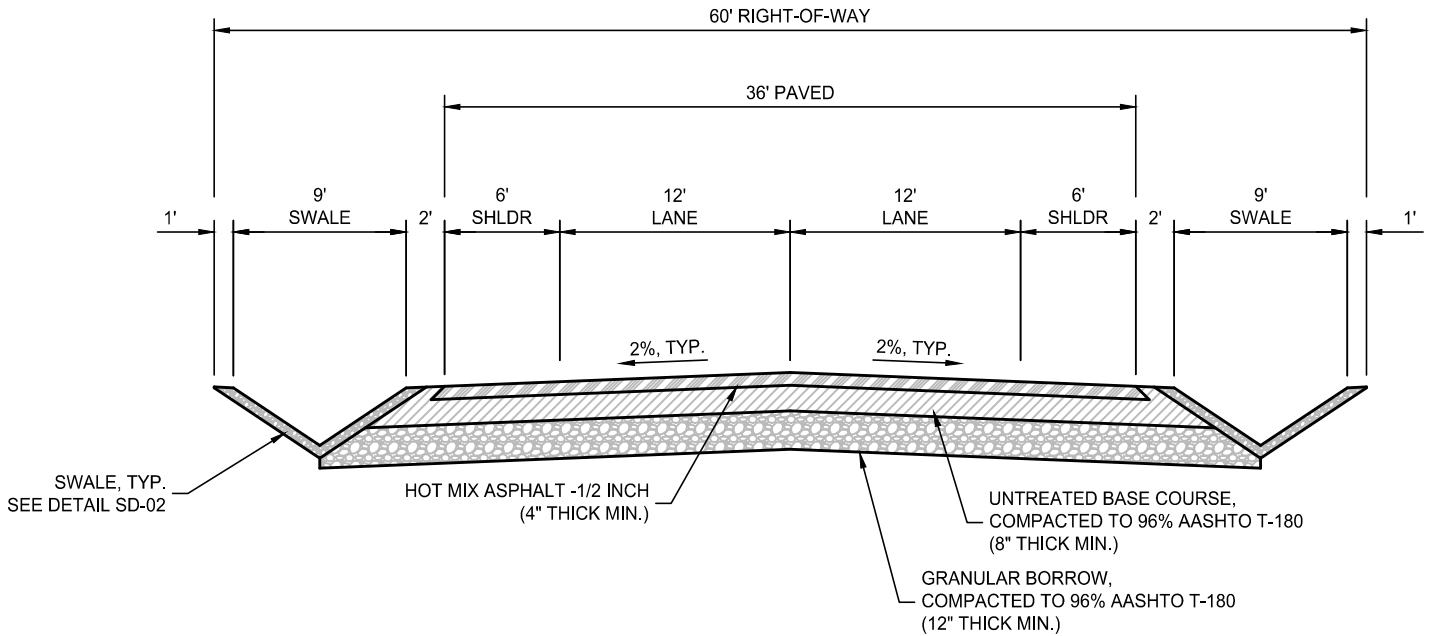

RESIDENTIAL COLLECTOR

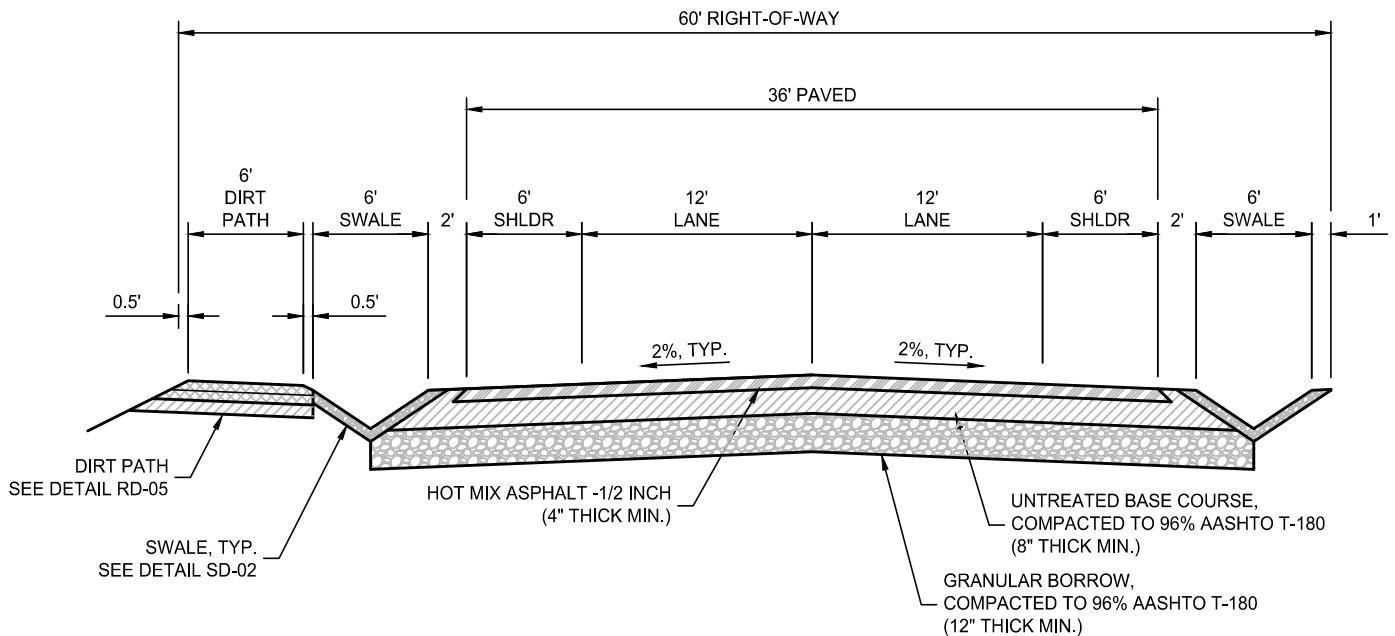

RESIDENTIAL COLLECTOR with DIRT PATH

NOTE:
~~THICKNESSES MAY BE ADJUSTED PER~~
~~GEOTECHNICAL REPORT.~~
 DEPTHS MAY VARY CONTINGENT ON AASHTO
 PAVEMENT DESIGN. ALL PAVEMENT DESIGNS
 SHALL BE STAMPED BY PROFESSIONAL ENGINEER.

DRAWING NOT TO SCALE

PREPARED BY: JONES AND DEMILLE ENGINEERING, INC.

LAKE POINT STANDARD DRAWING



LAKE POINT
 1528 SUNSET RD.,
 LAKE POINT UTAH 84074
 801-725-5096
 lakepoint.gov

COLLECTOR ROAD SECTIONS


UPDATED: 1/25/2024

STANDARD DRAWING No.

RD-02

APPROVED:

DATE: 01-24 BY: M.L.

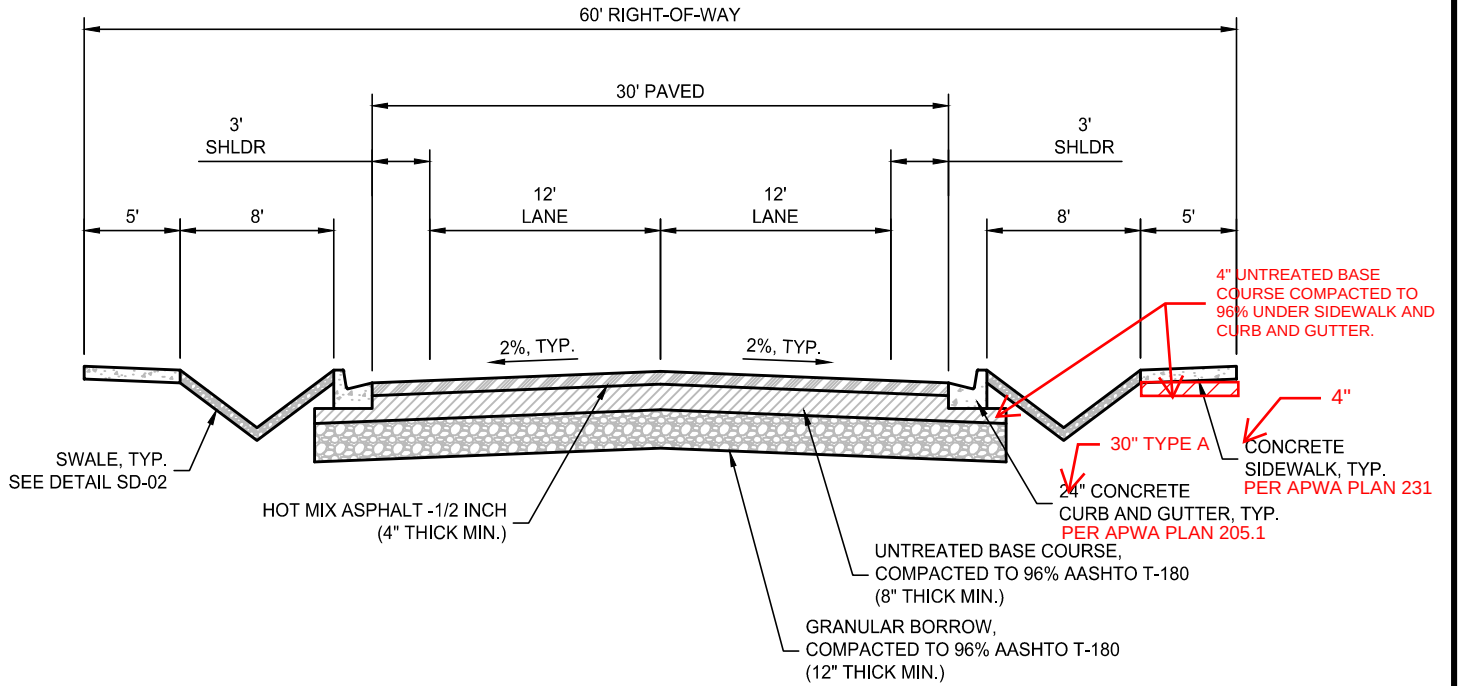

COMMERCIAL COLLECTOR with SIDEWALK

NOTE:
~~THICKNESSES MAY BE ADJUSTED PER~~
~~GEOTECHNICAL REPORT.~~
 DEPTHS MAY VARY CONTINGENT ON AASHTO
 PAVEMENT DESIGN. ALL PAVEMENT DESIGNS
 SHALL BE STAMPED BY PROFESSIONAL ENGINEER.

DRAWING NOT TO SCALE

PREPARED BY: JONES AND DEMILLE ENGINEERING, INC.

LAKE POINT STANDARD DRAWING



LAKE POINT
 1528 SUNSET RD.,
 LAKE POINT UTAH 84074
 801-725-5096
 lakepoint.gov

COMMERCIAL COLLECTOR ROAD SECTION


UPDATED: 1/25/2024

STANDARD DRAWING No.


RD-03

APPROVED:

DATE: 01-24 BY: M.L.

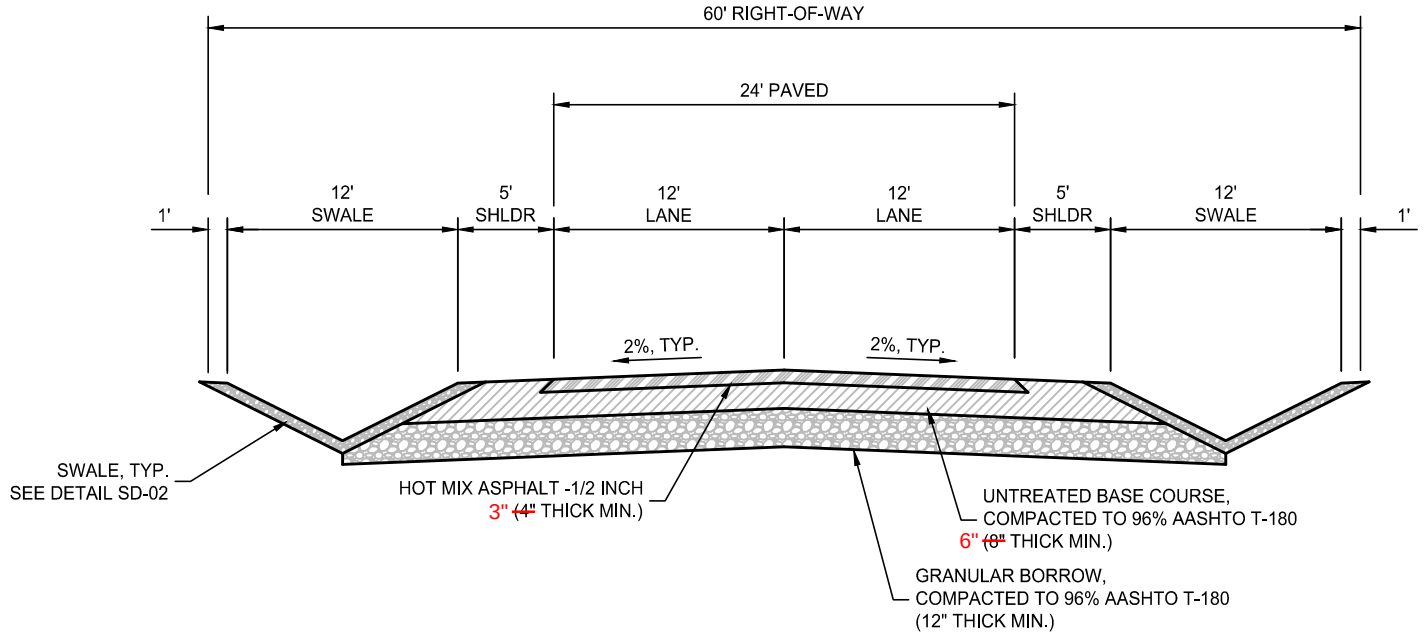

LOCAL ROAD

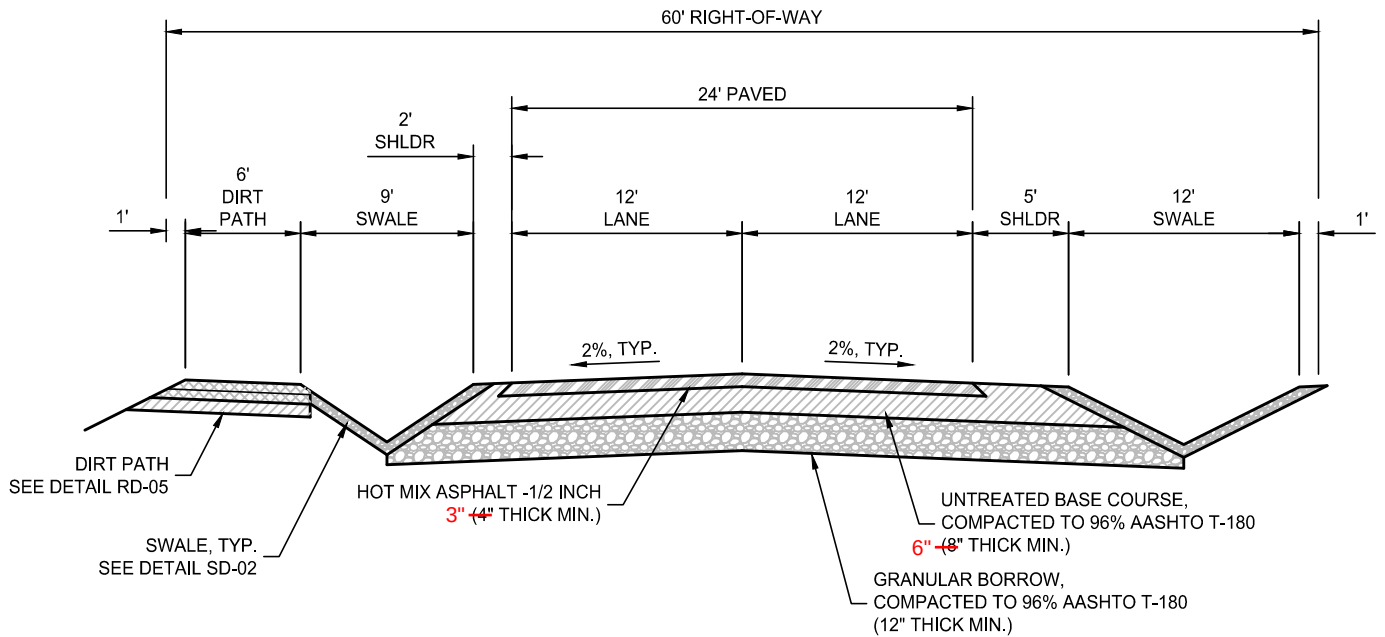

LOCAL ROAD with DIRT PATH

NOTE:
THICKNESSES MAY BE ADJUSTED PER
~~GEOTECHNICAL REPORT.~~
DEPTHS MAY VARY CONTINGENT ON AASHTO
PAVEMENT DESIGN. ALL PAVEMENT DESIGNS
SHALL BE STAMPED BY PROFESSIONAL ENGINEER.
PREPARED BY: JONES AND DEMILLE ENGINEERING, INC.

DRAWING NOT TO SCALE

LAKE POINT STANDARD DRAWING



LAKE POINT
1528 SUNSET RD.,
LAKE POINT UTAH 84074
801-725-5096
lakepoint.gov

LOCAL ROAD SECTIONS


UPDATED: 1/25/2024

STANDARD DRAWING No.

RD-04

APPROVED:

DATE: 01-24 BY: M.L.

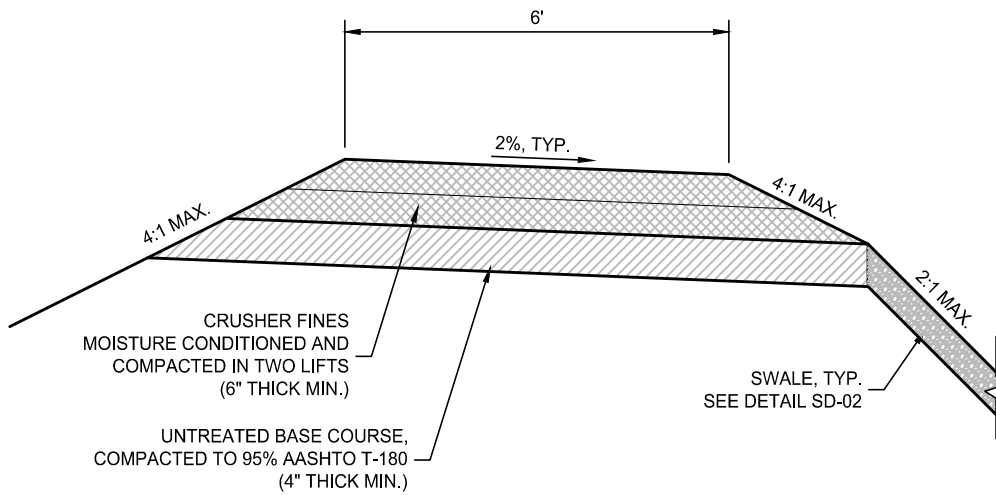

DRAWING NOT TO SCALE

PREPARED BY: JONES AND DEMILLE ENGINEERING, INC.

LAKE POINT STANDARD DRAWING



LAKE POINT
1528 SUNSET RD.,
LAKE POINT UTAH 84074
801-725-5096
lakepoint.gov

DIRT PATH SECTION


UPDATED: 1/25/2024

STANDARD DRAWING No.

RD-05

APPROVED:

DATE: 01-24 BY: M.L.

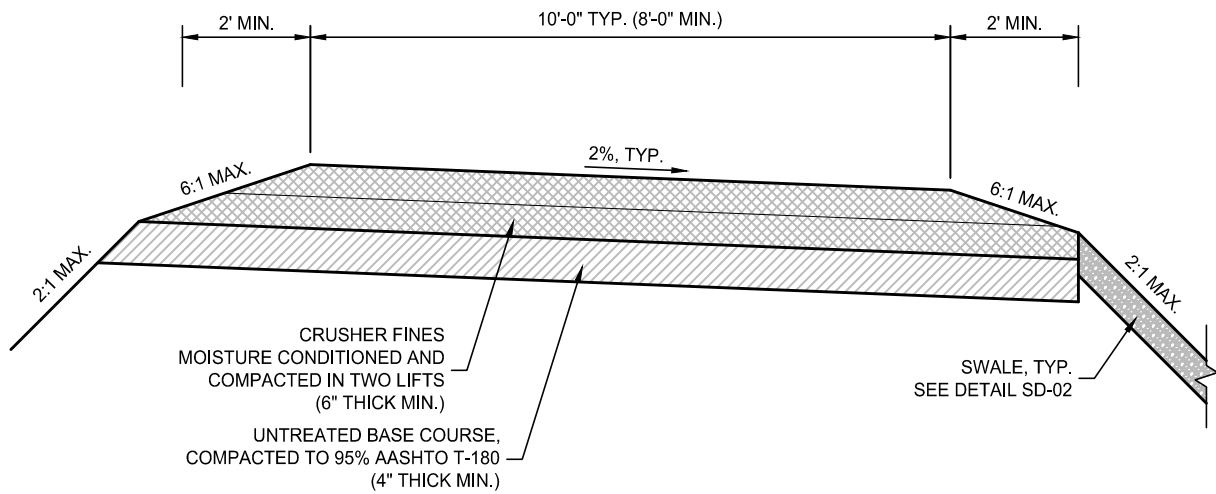

DRAWING NOT TO SCALE

PREPARED BY: JONES AND DEMILLE ENGINEERING, INC.

LAKE POINT STANDARD DRAWING



LAKE POINT
1528 SUNSET RD.,
LAKE POINT UTAH 84074
801-725-5096
lakepoint.gov

SHARED USE PATH SECTION


UPDATED: 1/25/2024

STANDARD DRAWING No.


RD-06

APPROVED:

DATE: 01-24 BY: M.L.

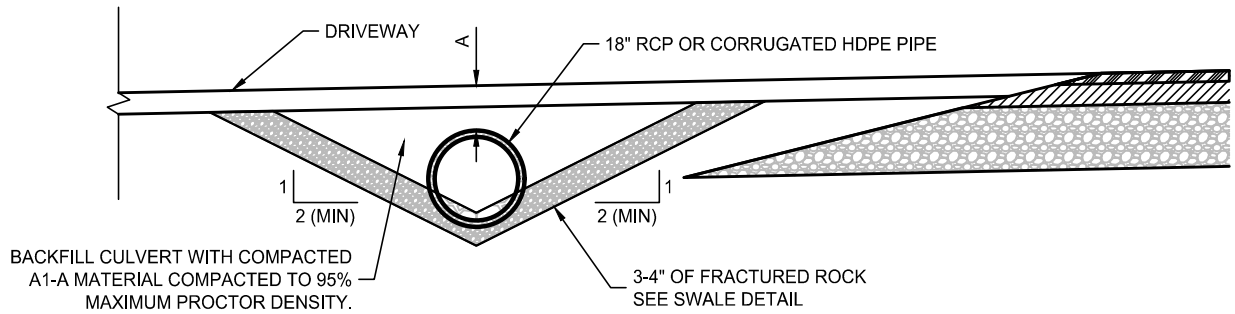

DRIVEWAY CROSS SECTION

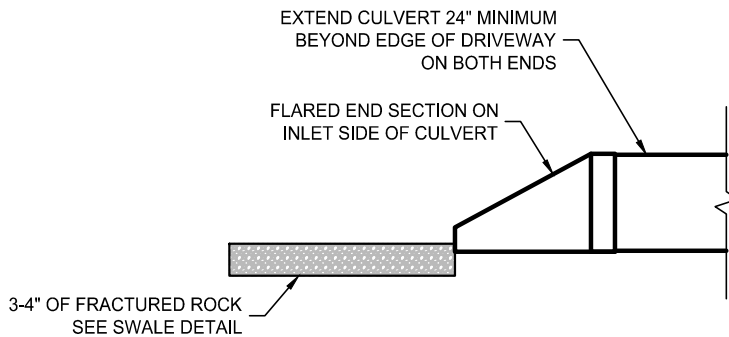

CULVERT CROSS SECTION

TABLE		
PIPE	PAVEMENT	A
HDPE	CONCRETE ASPHALT GRAVEL	12" 12" + ASPHALT THICKNESS 15"
RCP	CONCRETE ASPHALT GRAVEL	12" 12" 12"

NOTES:

1. HDPE PIPE SHALL BE CORRUGATED DUAL WALL PIPE.
2. RCP SHALL BE CLASS III. COVER SHALL BE MEASURED FROM THE OUTSIDE OF THE MAIN BARREL, NOT THE BELL END.

DRAWING NOT TO SCALE

PREPARED BY: JONES AND DEMILLE ENGINEERING, INC.


LAKE POINT STANDARD DRAWING

 LAKE POINT 1528 SUNSET RD., LAKE POINT UTAH 84074 801-725-5096 lakepoint.gov	DRIVEWAY CULVERT CROSSING UPDATED: 1/25/2024	STANDARD DRAWING No.
		SD-01
		APPROVED:
		DATE: 01-24 BY: M.L.

NOTHING CHANGED SINCE THESE DATES AND
THESE WERE WHEN THEY WERE APPROVED

11/8/2023

10/25/23

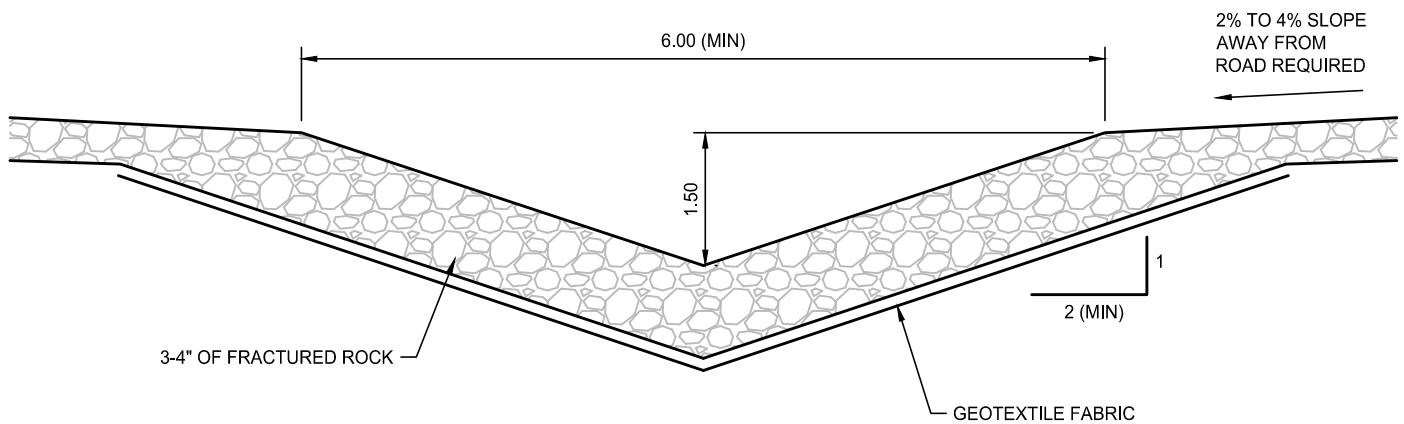

NOTES:

1. ROCK LINED DITCHES MAY BE REQUIRED TO BE DEEPER AT DRIVEWAY CULVERT CROSSINGS. REFER TO STANDARD DETAIL SD-01 FOR REQUIRED CULVERT SIZES AND REQUIREMENTS UNDER DRIVEWAYS.

DRAWING NOT TO SCALE

PREPARED BY: JONES AND DEMILLE ENGINEERING, INC.

LAKE POINT STANDARD DRAWING



LAKE POINT
1528 SUNSET RD.,
LAKE POINT UTAH 84074
801-725-5096
lakepoint.gov

SWALE DETAIL

UPDATED: 1/25/2024

STANDARD DRAWING No.

SD-02

APPROVED:

DATE: 01-24 BY: M.L.

1/12/2024

1/10/24

NOTHING CHANGED SINCE THESE DATES AND THESE WERE WHEN THEY WERE APPROVED