

REQUEST FOR COUNCIL ACTION

SUBJECT: Sierra Newbold Playground Monument

SUMMARY: City Council previously approved naming the new playground at Ron Wood Park the Sierra Newbold Playground. This request is for Council approval of the design, construction and location of the monument sign for the playground.


FISCAL IMPACT: Funding for this project is available in the Parks Open Space account and from citizen donations.

STAFF RECOMMENDATION:
Staff recommends approval of the design, construction, the location of the monument sign for the Sierra Newbold Playground at Ron Wood Park.

MOTION RECOMMENDED:
"I move to adopt Resolution No. 14-81 approving the design, construction, and the location of the monument sign for the Sierra Newbold Playground at Ron Wood Park.


Roll Call vote required.

Prepared by:

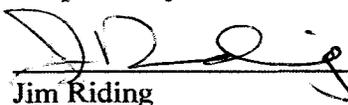


Jim Riding
CIP/Facilities/Fleet Project Manager

Reviewed by:

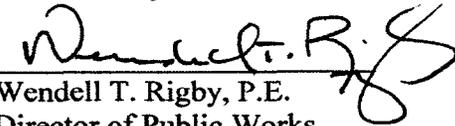

Wendell T. Rigby, P.E.
Director of Public Works

Reviewed as to Legal Sufficiency:

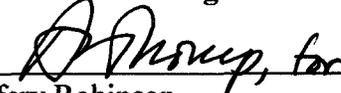

Jeffery Robinson
City Attorney

Recommended by:



Richard L. Davis
City Manager

BACKGROUND DISCUSSION:

City Council previously approved the naming of the playground at Ron Wood Park the Sierra Newbold Playground and gave Staff direction to complete a design for a memorial monument at the playground. The monument is designed to place metallic balloons on the wall to recognize donors that contributed funds for the construction of the playground. Attached you will find the recommended design and placement of the monument, which is on the perimeter of the playground. The dimensions of this sign meet the Public Works-Memorials, Monument and Naming of Public Places and Facilities code (Title 8, Chapter 15 in the 2009 City Code).

Attachments:

- Resolution
- Design
- Monument location plan

THE CITY OF WEST JORDAN, UTAH

A Municipal Corporation

RESOLUTION NO. 14-81

**A RESOLUTION APPROVING THE DESIGN, CONSTRUCTION AND PLACEMENT
OF A MEMORIAL MONUMENT TO BE PLACED AT THE
SIERRA NEWBOLD PLAYGROUND AT RON WOOD PARK**

WHEREAS, the City Council of the City of West Jordan has reviewed the attached design and location of the monument for the Sierra Newbold Playground; and,

WHEREAS, the City Council of the City of West Jordan desires to approve the design, construction and location of the memorial monument for the Sierra Newbold Playground, as required by Title 8, Chapter 15 of the 2009 City Code.

NOW, THEREFORE, IT IS RESOLVED BY THE CITY COUNCIL OF WEST JORDAN, UTAH, THAT:

Section 1. Staff is directed to proceed with the design, construction and placement of the memorial monument for the Sierra Newbold Playground.

Section 2. This Resolution shall take effect immediately upon passage.

Adopted by the City Council of West Jordan, Utah this 7th day of May, 2014.

Kim V. Rolfe
Mayor

ATTEST:

MELANIE S. BRIGGS
City Recorder


Voting by the City Council	"AYE"	"NAY"
Jeff Haaga	_____	_____
Judy Hansen	_____	_____
Chris McConnehey	_____	_____
Chad Nichols	_____	_____
Ben Southworth	_____	_____
Justin D. Stoker	_____	_____
Mayor Kim V. Rolfe	_____	_____

User: Mar 10, 2014 - 12:50pm
 P:\PROJECTS\LA_CURRENT\RON_WOODS_PARK_DEC_2013\RECORD DRAWINGS\p-rwp-playground wall.dwg

Construction Limit Line

Construction Limit Line

Construction Limit Line

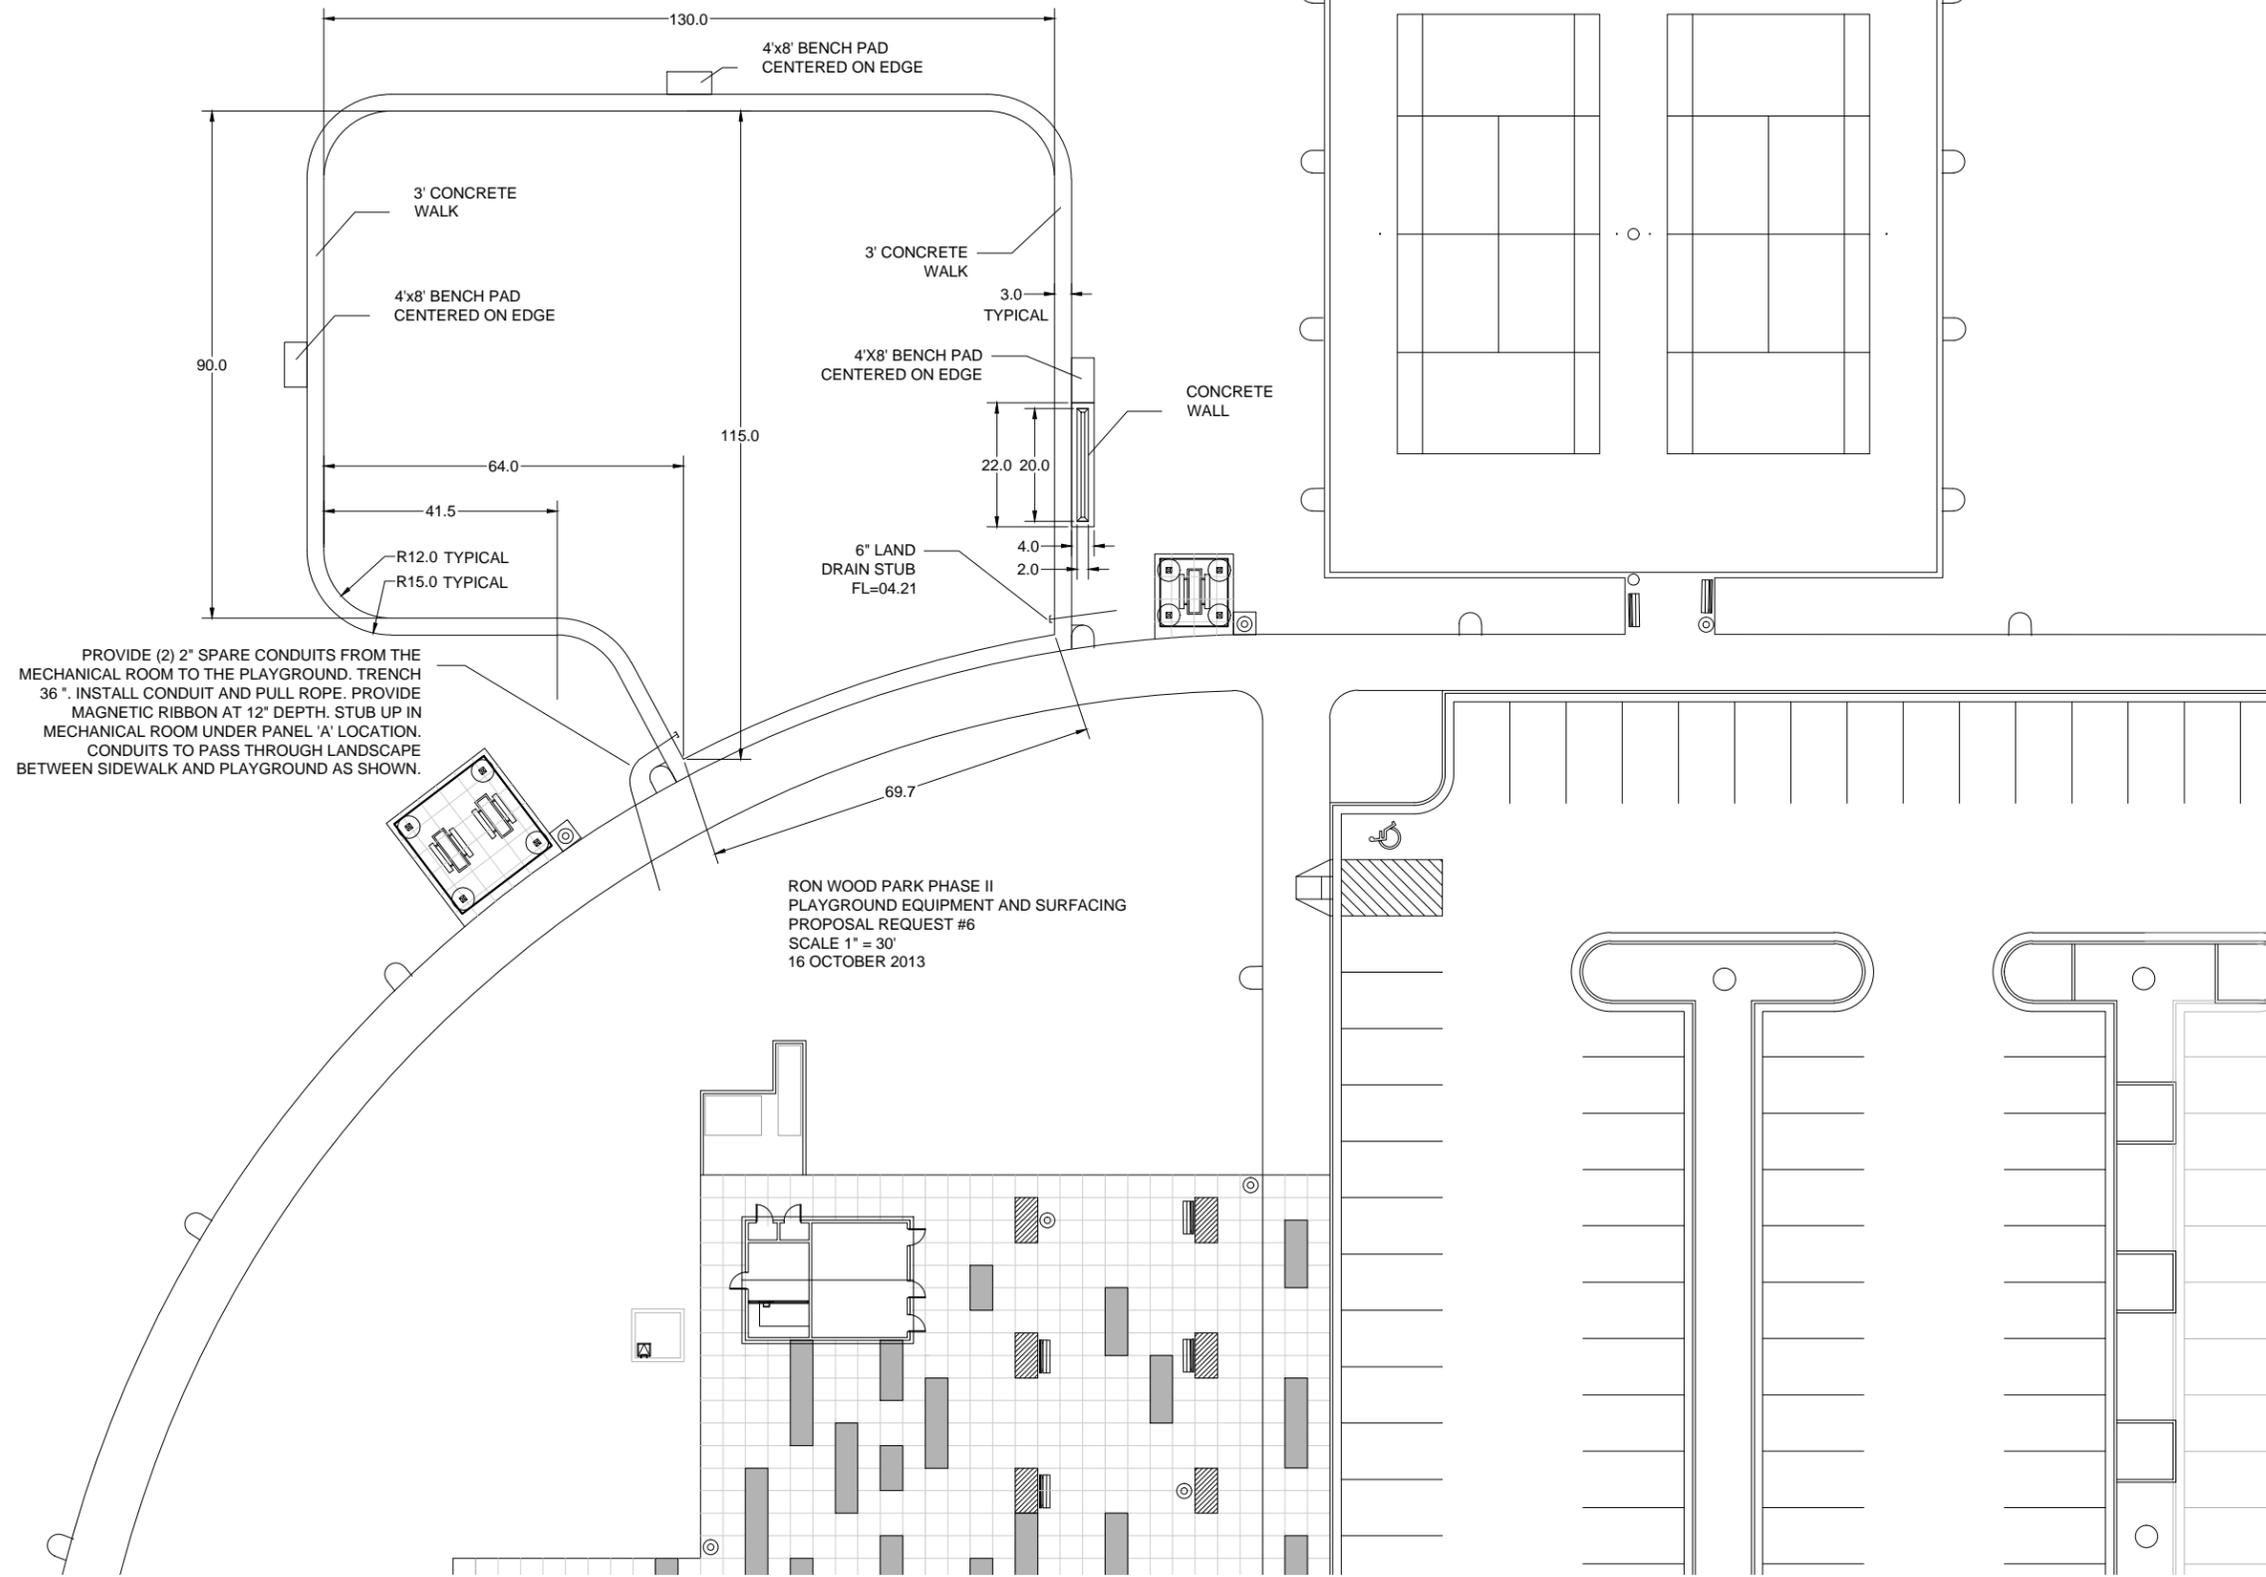

PROVIDE (2) 2" SPARE CONDUITS FROM THE MECHANICAL ROOM TO THE PLAYGROUND. TRENCH 36". INSTALL CONDUIT AND PULL ROPE. PROVIDE MAGNETIC RIBBON AT 12" DEPTH. STUB UP IN MECHANICAL ROOM UNDER PANEL 'A' LOCATION. CONDUITS TO PASS THROUGH LANDSCAPE BETWEEN SIDEWALK AND PLAYGROUND AS SHOWN.

RON WOOD PARK PHASE II
 PLAYGROUND EQUIPMENT AND SURFACING
 PROPOSAL REQUEST #6
 SCALE 1" = 30'
 16 OCTOBER 2013

CONSULTANTS

LANDMARK
 DESIGN
 INCORPORATED
 LANDSCAPE ARCHITECTURE
 AND LAND PLANNING

2834 Highland Drive
 Salt Lake City
 Utah 84106
 (801) 474-3300
 Fax (801) 474-3303



NOTICE

ALL RIGHTS RESERVED ©
 LANDMARK DESIGN, INC.
 These documents are protected under the United States 1978 copyright act. It is an exclusive work of original authorship. None of the pictorial, graphic, or technical charts or drawings depicted may be reproduced by any method, mechanical, electronic, or otherwise; nor may they be used or re-used for any purpose without the express prior written permission of LANDMARK DESIGN, INC.

This design indicates relationships based on data obtained from other parties and has been interpolated or combined by Landmark Design, Inc. to meet the requirements of this project. The subsequent accuracy of this document while considered reliable is not warranted or guaranteed.

Although this document is intended for use during construction, the actual conditions encountered on site may require the modification of information contained herein. Any modification of the information contained herein will be subject to approval of Landmark Design, Inc.


PROJECT NAME & ADDRESS

**RON WOOD PARK
 PHASE II**

**8620 SOUTH
 RON WOOD PARK ROAD
 WEST JORDAN, UTAH 84081**

MARK	DATE	REVISION

PROJECT MANAGER:
 MV
 DRAWN BY:
 HH
 CHECKED BY:
 MV
 DATE:
 03/10/2014
 JOB NO:
 WJ# PK 13-2
 SHEET TITLE

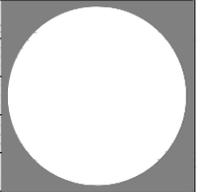

**PLAYGROUND
 SIGN SITE LAYOUT**

SHEET NO.
LX-103

CONSULTANTS

LANDMARK
DESIGN
INCORPORATED
LANDSCAPE ARCHITECTURE
AND LAND PLANNING

2834 Highland Drive
Salt Lake City
Utah 84106
(801) 474-3300
Fax (801) 474-3303



NOTICE

ALL RIGHTS RESERVED ©
LANDMARK DESIGN, INC.
These documents are protected under the United States 1978 copyright act. It is an exclusive work of original authorship. None of the pictorial, graphic, or technical charts or drawings depicted may be reproduced by any method, mechanical, electronic, or otherwise; nor may they be used or re-used for any purpose without the express prior written permission of LANDMARK DESIGN, INC.

This design indicates relationships based on data obtained from other parties and has been interpolated or combined by Landmark Design, Inc. to meet the requirements of this project. The subsequent accuracy of this document while considered reliable is not warranted or guaranteed.

Although this document is intended for use during construction, the actual conditions encountered on site may require the modification of information contained herein. Any modification of the information contained herein will be subject to approval of Landmark Design, Inc.

PROJECT NAME & ADDRESS

**RON WOOD PARK
PHASE II**


**8620 SOUTH
RON WOOD PARK ROAD
WEST JORDAN, UTAH 84081**

MARK	DATE	REVISION


PROJECT MANAGER:
MV
DRAWN BY:
HH
CHECKED BY:
MV
DATE:
03/10/2014
JOB NO:
WJ# PK 13-2
SHEET TITLE

**PLAYGROUND
SIGN A**

SHEET NO.
LX-101

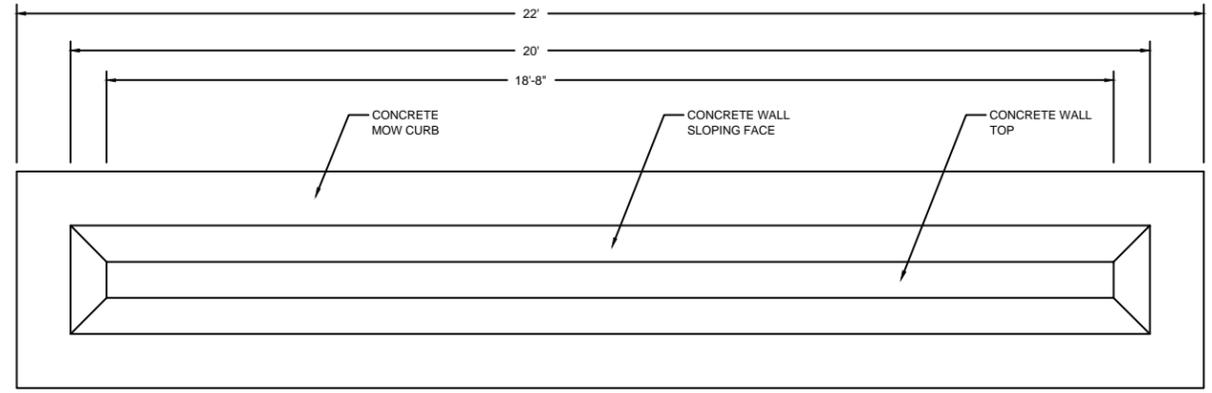


PLAN VIEW

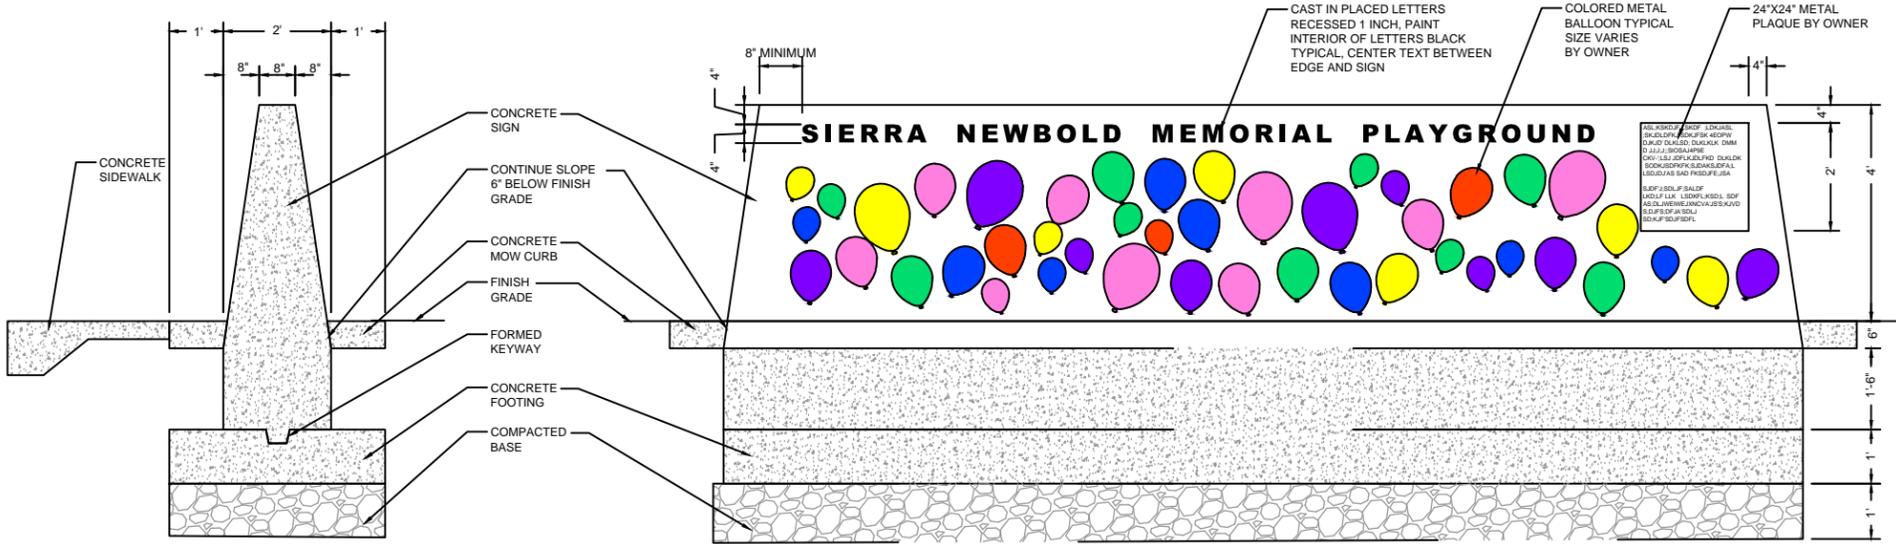

SIDE / SECTION VIEW

FRONT VIEW

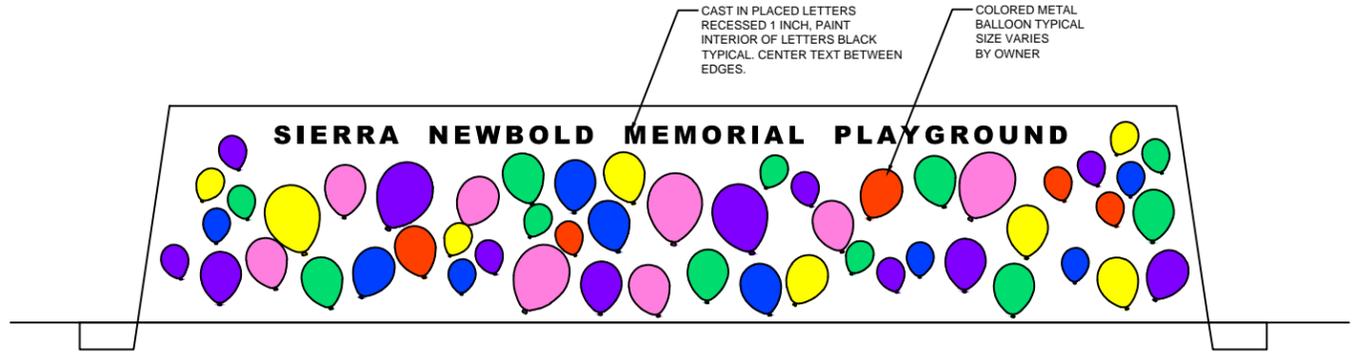

BACK VIEW

00 CONCRETE SIGN (RON WOOD PARK)
3/4" = 1'-0"

324123-17

User: Mar 10, 2014 - 12:52pm P:\PROJECTS\LA_CURRENT\RON_WOODS_PARK_DEC_2013\RECORD DRAWINGS\P-RMF-playground wall.dwg