AMERICAN FORK CITY
DEVELOPMENT REVIEW COMMITTEE AGENDA

Regular Session
December 2, 2024
Monday 10:00 AM

American Fork City Public Works Building

275 East 200 North

American Fork City, UT 84003

https://www.americanfork.gov/AgendaCenter

Development Review Committee Members

Patrick O'Brien, Dev. Services Director **Aaron Brems, Fire Chief**

Sam Kelly, Public Works Director

Notice is hereby given that the American Fork City Development Review Committee will meet in regular session on December 2, 2024, at the American Fork City Public Works building, 275 East 200 North commencing at 10:00 AM. The agenda shall be as follows:

1. **Regular Session**
    a. Roll Call

2. **Common Consent Agenda** (Common Consent is that class of DRC action that requires no further discussion or which is routine in nature. All items on the Common Consent Agenda are adopted by a single motion unless removed from the Common Consent Agenda).
    a. Approval of the November 25, 2024, Development Review Committee minutes.

3. **Action Items** (Action Items is that class of DRC action that requires further discussion on Preliminary Plans, Final Plats, and Site Plans. The Development Review Committee Board will have authority to approve Preliminary Plans and Final Plats but make a recommending action on Site Plans.)
    a. Review and action on an application for a Preliminary Plat, known as Holmes Gunther Preliminary Plan for the proposed Ellen's 2 Subdivision, located at 490 N Mary Pulley Dr. (900 E), American Fork City, UT 84003. The Preliminary Plat will be on approximately 5.16 acres and will be in the R1-9000 zoning designation.

4. **Other Business**
    a. Upcoming Projects

5. **Adjournment**

Dated this 26th day of November 2024

Patrick O'Brien

Development Services Director

**The order of agenda items may change at the discretion of the Development Review Committee*

AMERICAN FORK CITY

DEVELOPMENT REVIEW COMMITEE REGULAR SESSION

NOVEMBER 25th, 2024

The American Fork City Development Review Committee met in a regular session on November 25th, 2024, at the American Fork Public Works Building, 275 East 200 North, commencing at 10:00 a.m.

Development Review Committee:

Development Services Director: Patrick O'Brien

Public Works Director: Sam Kelly

Fire Chief: Aaron Brems

Staff Present:

Ben Hunter	City Engineer
Travis Van Ekelenburg	Senior Planner
Angie McKee	Administrative Assistant I

Others Present:

REGULAR SESSION

Roll Call

COMMON CONSENT AGENDA

Minutes of the November 18th, 2024, Development Review Committee Regular Session.

Mr. O'Brien noted that the date was wrong in one place in the meeting minutes that were included in the DRC packet, so that correction will be made.

Patrick O'Brien motioned to approve the Common Consent agenda

Chief Brems seconded the motion

Voting was as follows:

Patrick O'Brien	**AYE**
Sam Kelly	**AYE**
Aaron Brems	**AYE**

The motion passed

ACTION ITEMS

a. **Review and recommendation on an application for a Commercial Site Plan, known as AT&T Upgrade, located at approximately 1584 S 500 E, American Fork City, UT 84003. The Commercial Site Plan will be on approximately 3.32 acres and will be in the I-1 Industrial zone.**

Travis Van Ekelenburg reviewed the background information for action item letter a: The applicant has applied for a Commercial Site Plan for an existing wireless facility upgrade for AT& T wireless. The upgrade is a standard equipment upgrade that will not increase the height of the tower and will not expand on the existing footprint. This is a pretty standard upgrade, and the only condition of approval is updating the address, as it is Mr. Van Ekelenburg's understanding that the location is actually 580 East.

Patrick O'Brien moved to recommend approval for the proposed Commercial Site Plan, located at approximately 1584 S 500 E, American Fork City, UT 84003, in the I-1, subject to the condition that the correct address be updated.

Sam Kelly seconded the motion.

Voting was as follows:

Patrick O'Brien	**AYE**
Sam Kelly	**AYE**
Aaron Brems	**AYE**

The motion passed

Other Business

Adjournment

Sam Kelly motioned to adjourn the meeting.

Patrick O'Brien seconded the motion.

Meeting adjourned at 10:06 AM

Angie McKee

Administrative Assistant I

The order of agenda items may change to accommodate the needs of the committee, public and staff.

Development Review Committee Staff Report
Meeting Date: December 2, 2024

Agenda Topic

Review and action on an application for a Preliminary Plat, known as Holmes Gunther Preliminary Plan for the proposed Ellen's 2 Subdivision, located at 490 N Mary Pulley Dr. (900 E), American Fork City, UT 84003. The Preliminary Plat will be on approximately 5.16 acres and will be in the R1-9000 zoning designation.

BACKGROUND INFORMATION		
Location:		490 Mary Pulley Dr.
Project Type:		Preliminary Plan
Applicants:		Daniel Herzog
Existing Land Use:		Residential Low Density
Surrounding Land Use:	North	Residential Low Density
	South	Residential Low Density
	East	Residential Low Density
	West	Residential Low Density
Existing Zoning:		R1-9000
Surrounding Zoning:	North	R1-9000
	South	R1-9000
	East	R1-9000
	West	R1-9000
Square Footage (By Use)		224,770
Total Number of Units		15
Parking Requirement		30

Background

The applicant has applied for a Preliminary Plat to develop a 15-lot subdivision. The project looks to establish 15 residential lots that range from approximately 9,000 to 24,000 square feet in area.

The proposed subdivision would create connectivity from Mary Pulley Drive to 490 N Street to the East, and the additional street in the subdivision is 950 East that will dead end to the south for future development.

Sec 17.8.201 Subdivider Confers With Development Review Committee

A. The subdivider may meet with the Development Review Committee in a pre-application meeting to discuss the basic concept of the proposed subdivision and to obtain information pertaining to the general plan and zoning classification of the area proposed for subdivision, city requirements and standards for design and construction of streets, utilities and other requirements affecting the land proposed to be subdivided.

B. The purpose of the conference(s) is to provide informal assistance to the subdivider in the preparation of the plans early in the process. The Development Review Committee may suggest changes in the proposed layout so the project is more fully consistent with the city's general plan and also with the city's development regulations and policies. The recommendations from the Development Review Committee prior to the subdivision application shall be purely advisory and in no way shall the conference be construed to constitute approval of the plan.

Sec 17.8.202 Subdivider Prepares And Submits Preliminary Plat And Supporting Materials

After the pre-submittal conference, if applicable, the subdivider shall prepare and submit to the Development Services Department a preliminary plat submittal packet containing the following:

A. An application for approval of the subdivision project, together with copies of plans and materials showing the layout of the proposed project, including the location, size and dimensions of all lots; the placement and cross-section of all proposed streets; the location of all public utility easements; the intended treatment of drainage; and the intended treatment of any other essential features of the proposed subdivision.
B. A geotechnical report for the subdivision area.
C. Evidence of payment of the required review fee.
D. Evidence of water right proposed to be conveyed to the city.
E. Evidence of review of the proposed subdivision of required public utility agencies.
F. Other materials deemed by city staff to be essential for an adequate understanding of the proposed project.

Sec 17.8.203 DRC Reviews Preliminary Plans, Documents, And Statements

Upon receipt of the preliminary plan submittal packet from the subdivider the Development Services Director or assignee shall review the plans, documents, and materials for completeness and for conformance with city requirements and standards and the general plan, and submit said

plans, documents and statements or portions thereof to the Development Review Committee for their review and recommendation.

Sec 17.8.204 Development Review Committee Reports Results Of Review Of Preliminary Plans, Documents, And Statements To Subdivider

A. The Development Review Committee shall conduct a Development Review Conference to review and discuss the materials submitted by the subdivider.
B. Upon completion of review, the Development Review Committee shall provide the results of the review and comments to the Development Services Director or assignee. The results and comments shall be compiled and provided to the subdivider.
C. The Development Review Committee may suggest changes in order for the preliminary plan materials to be more consistent with the objectives of the general plan and development regulations and policies.

Sec 17.8.206 Development Review Committee Takes Action On Preliminary Plans And Supporting Materials

A. After considering the recommendation of all Development Review Committee members, the DRC, acting as the administrative land use authority, may table the matter, deny, or grant approval, including granting approval upon conditions stated.
B. Approval of the Preliminary Plan by DRC shall not constitute final approval of the project, but shall be deemed as approval to proceed with preparation of a final plat, detailed engineering and supporting materials.

Project Conditions of Approval


1. Address all comments and requirements from staff.
2. Add double inlet catch basins, modify storm drain storage system to one acceptable by the city easily maintainable and accessible, add line stops on water line, correct line type errors, identify to bury overhead power or confirm it's been removed, update details.

Findings of Fact

1. The Preliminary Plat does not meet the requirements of Section 17.8 (see redlines on plan set), Section 15.01.100.E.1.a for sag conditions, and Section 13.94 for adequate storm water management and discharge.

Project Map

Development Review Committee Staff Report
Meeting Date: December 2, 2024

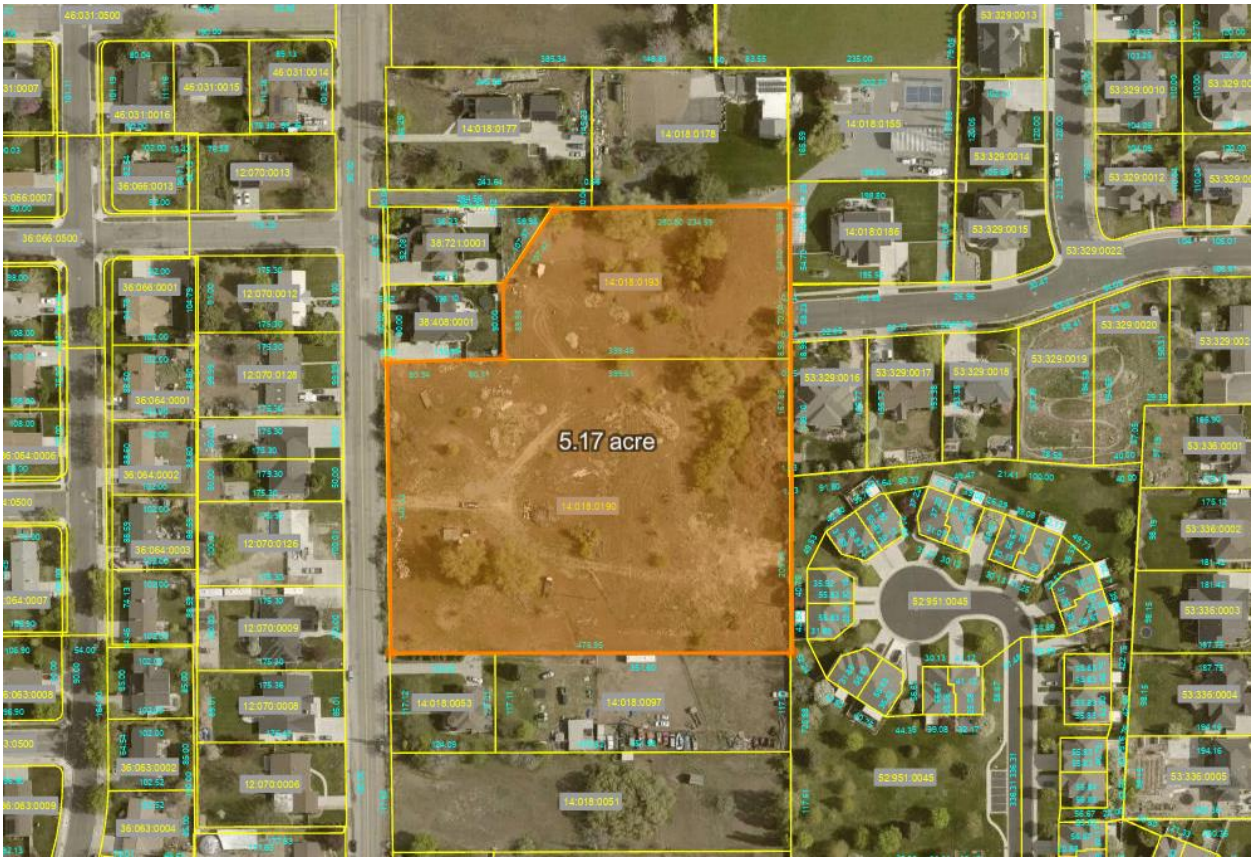

Standards Conditions of Approval

APPLICANT is responsible and shall submit/post/obtain all necessary documentation and evidence to comply with these Standard Conditions of Approval prior to any platting, permitting, or any other form of authorization by the City including plat recording or other property conveyance to the City and prior to scheduling a pre-construction meeting. All recording shall take place at the Utah County Recorder's Office.

1. **Title Report:** Submit an updated Title Report not older than 30 days or other type of appropriate verification that shows all dedications to the City are free and clear of encumbrances, taxes, or other assessments.
2. **Property Taxes and Liens:** Submit evidence that all the property taxes, for the current and/or previous years, liens, and agricultural land use roll over fees have been paid in full.
3. **Water Rights:** Submit evidence that all the required water rights have been conveyed to American Fork City.
4. **Performance Guarantee:** Post a performance guarantee for all required public and essential common improvements.

5. **Easements and Agreements:** Submit/record a long-term Storm Water Pollution Prevention Maintenance Agreement signed and dated by the property owner and any required easement documentation.
6. **Land Disturbance Permit:** Obtain a Land Disturbance Permit.
7. **Compliance with the Plan Review Comments:** All plans and documents shall comply with all the Technical Review Committee comments and the City Engineer's final review.
8. **Commercial Structure:** Record an Owner Acknowledgment and Utility Liability Indemnification if the proposed building is a multi-unit commercial structure served by a single utility service.
9. **Sensitive Lands:** Record all applicable documents required for compliance with the City's Sensitive Lands Ordinance.
10. **Utility Notification Form:** Submit a Subdivision Utility Notification Form.
11. **Professional Verification:** Submit final stamped construction documentation by all appropriate professionals.
12. **Fees:** Payment of all development, inspection, recording, streetlight, and other project related fees.
13. **Mylar:** Submit a Mylar. All plats will receive final verification of all formats, notes, conveyances, and other items contained on the plat by City staff (recorder, legal, engineer, GIS, planning).

Staff Recommendation

The Preliminary Plat does not meet the requirements of Section 17.7.206. Staff recommends DENYING.

Potential Motions – Preliminary Plat

Approval

I move to approve the proposed Preliminary Plat, located at approximately 490 E Mary Pulley Drive, American Fork City, UT 84003, in the R1-9000 zone, subject to any conditions found in the staff report.

Denial

I move to deny the proposed Preliminary Plat, located at approximately 490 E Mary Pulley Drive, American Fork City, UT 84003, in the R1-9000 zone.

Table

I move to table action for the proposed Preliminary Plat, located at approximately 490 E Mary Pulley Drive, American Fork City, UT 84003, in the R1-9000 zone and instruct staff/developer to…

American Fork City Development Review Committee	
Streets Division Reviewed ehyde 11/26/2024	Planning and Zoning Reviewed tvanekelenburg 11/20/2024
EC/LID Reviewed tmezenen 11/27/2024	Fire Department Reviewed M. Sacco 11/18/2024
	Engineering Division Reviewed rburkhill 11/20/2024
	Sewer/Storm Drain Division Reviewed ascott 11/26/2024
Water/PI Division Reviewed jbrems 11/26/2024	Public Infrastructure Reviewed dhoward 11/26/2024

Address comments

see comments on sheet 6

Next Step

Proceed to the Development Review Committee 12.02.2024

Comments from the Plat - Planning Comments/Recommendations
1. Adjust all lots as called out in the initial review for R1-9000 zoning lot requirements.
2. Please add building envelopes for all lots. As there are irregular lots in this sub, we need to be able to see that the front lot width requirement is met at the front setback for all lots.
3. Please add perimeter fencing for the project.
4. Please show lot frontage that the direction of the front elevation of the home is aligned with the width requirement of the lots, starting with lots 1, 3, 7, 12, and 14.
5. Please revise lot 8 to show min width and depth requirements are met at the front setback.

DRC Plan Review Meetings

These meetings are available with staff on Tuesdays from 9:00 AM-12:00 PM in 30 minute appointments.

Meetings can be scheduled with Melissa White at mwhite@americanfork.gov or through 801-854-5932


Re-Submittal Acknowledgment Statement

The Applicant is responsible for reviewing all documents to ensure all comments have been addressed.

_____ [Applicant Initial] I understand that a Review Cycle is not complete unless and until the applicant replies to all of the required modifications and requests for additional information noted on the previous submittal.

_____ [Applicant Initial] I hereby acknowledge that this re-submittal addresses all required modifications and requests for additional information noted on the previous submittal.

_____ [Applicant Initial] This is the _____ [Ex: 1st] complete re-submittal of the subdivision constituting the start of the _____ [Same Number] Review Cycle.

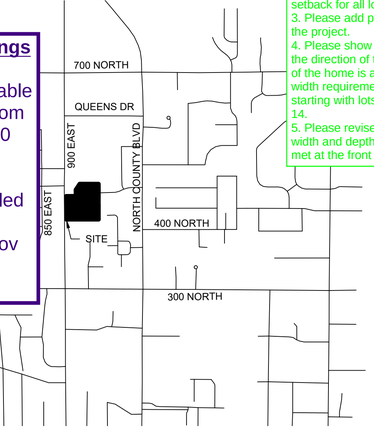

VICINITY MAP
NTS

ELLEN'S 2 SUBDIVISION

RESIDENTIAL DEVELOPMENT


900 E ST & 540 N ST, AMERICAN FORK, UT 84003-1321

CONSTRUCTION DRAWINGS

13 NOV 2024

Provide project perimeter fencing.

FEMA FLOODPLAIN: ZONE X (AREA OF MINIMAL FLOOD HAZARD) PER FLOOD INSURANCE RATE MAP (FIRMETTE) PANEL 49049C0169F DATED 19 JUNE 2020.
IMPERVIOUS AREA RATIO: 32.32%
LANDSCAPE AREA RATIO: 64.68%
BASIS OF BEARING: NORTH 0°25'21" WEST BETWEEN THE WEST QUARTER CORNER AND THE NORTHWEST CORNER OF SECTION 18, TOWNSHIP 5 SOUTH, RANGE 2 EAST, SALT LAKE BASE & MERIDIAN
BENCHMARK: 4640.055' BEING THE WEST QUARTER CORNER OF THE NORTHWEST CORNER OF SECTION 18, TOWNSHIP 5 SOUTH, RANGE 2 EAST, SALT LAKE BASE & MERIDIAN NAVD88

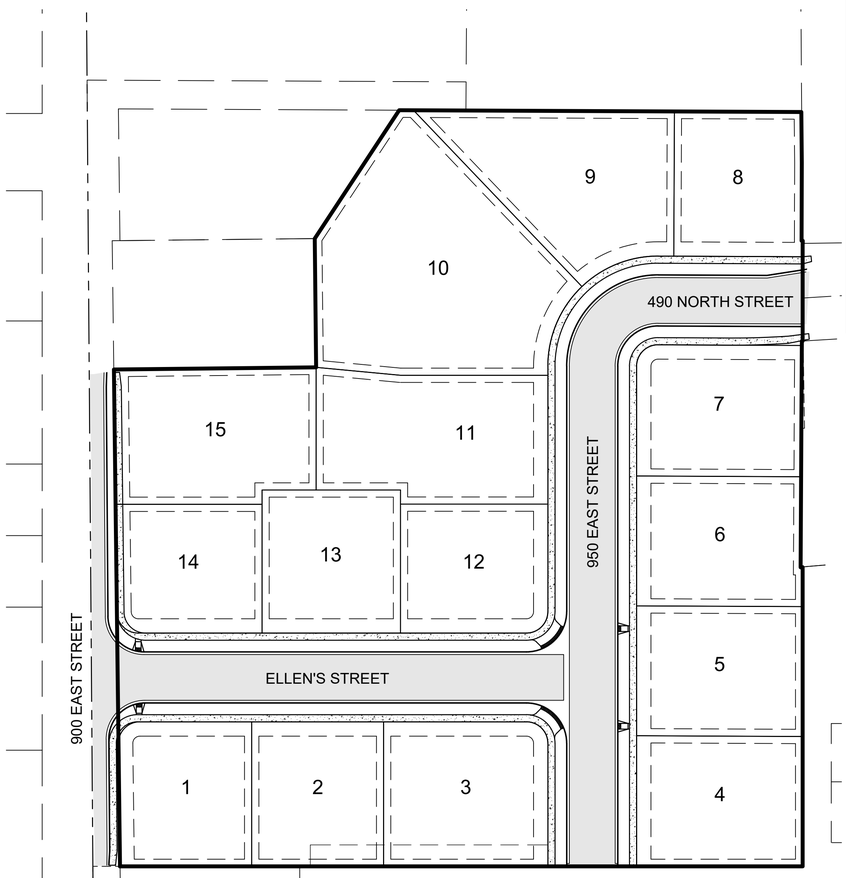


SHEET LIST TABLE

SHEET NUMBER	SHEET TITLE	SHEET NAME
01	TC01	COVER SHEET
02	GN01	GENERAL NOTES
03	GN02	GENERAL NOTES
04	DM01	DEMOLITION PLAN
05	SP01	SITE PLAN
06	UT01	UTILITY PLAN
07	GR01	GRADING PLAN
08	PP01	PLAN & PROFILE – N 900 E ST
09	PP02	PLAN & PROFILE – ELLENS ST
10	PP03	PLAN & PROFILE – 950 E ST
11	PP04	PLAN & PROFILE – STORM DRAIN GALLERY
12	EC01	EROSION CONTROL PLAN
13	DT01	AMERICAN FORK STANDARD DETAILS
14	DT02	AMERICAN FORK STANDARD DETAILS
15	DT03	AMERICAN FORK STANDARD DETAILS
16	DT04	AMERICAN FORK STANDARD DETAILS
17	DT05	AMERICAN FORK STANDARD DETAILS
18	DT06	AMERICAN FORK STANDARD DETAILS
19	DT07	AMERICAN FORK STANDARD DETAILS
20	DT08	CONTECH DETAILS
21	COVER	ALTA COVER SHEET
22	ALTA	ALTA/NSPS LAND TITLE SURVEY

PROJECT CONTACTS TABLE:

COMPANY OR AGENCY	CONTACT	PHONE NUMBER
AF PUBLIC WORKS		
CULINARY WATER/PI	JAY BREMS	(801) 763-3060
SEWER/STORM DRAIN	ASHTON HARDY	(801) 763-3060
CITY INSPECTOR	DEE HOWARD	(801) 763-3060
SWMP MANAGER	TYLER MEZENEN	(385) 304-0150
AF FIBER	WILL DAVIS	(801) 897-9826
AF FIRE MARSHALL	MAT SACCO	(801) 763-3045
AF IRRIGATION COMPANY	ERNIE JOHN	(801) 471-6576
BLUE STAKES OF UT 811	—	(801) 662-4111
COMCAST	ELYSIA VALDEZ	(801) 401-3017
CENTURY LINK	BILL WESTFALL	(435) 623-4252
DOMINION ENERGY	TRENT JOHNSON	(801) 853-6548
TSSD	DAVID BARLOW	(801) 756-5231
MITCHELL HOLLOW IRRIGATION CO	DALE JONES	(801) 768-8150
ROCKY MOUNTAIN POWER	TERIA WALKER	(801) 756-1310

SYMBOL LEGEND:

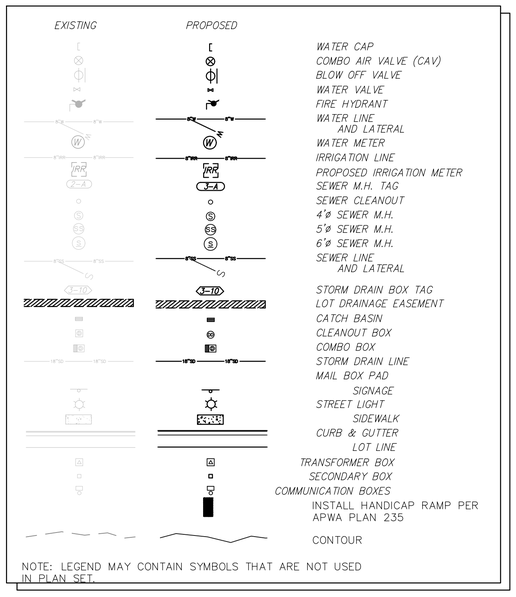

NOTE: LEGEND MAY CONTAIN SYMBOLS THAT ARE NOT USED IN PLAN SET.

PERIGEE CONSULTING
CIVIL • STRUCTURAL • SURVEY
8089 SOUTH 1300 WEST, SUITE 160
WEST JORDAN, UT 84088
801.628.6004 TEL 801.590.0911 FAX
WWW.PERIGEECIVIL.COM

LICENSED PROFESSIONAL ENGINEER
No. 13937226
AUSTIN EARL WEAVER
15 NOV 2024
STATE OF UTAH

AMERICAN FORK CITY

CITY ENGINEER DATE

REV.	DATE	DESCRIPTION	APPR.

DESIGNED BY:	AEW
DRAWN BY:	AEW
CHKD BY:	TVW
SUBMITTED BY:	
DATE:	13 NOV 2024
SOLICITATION NO:	
CONTRACT NO:	01041
FILE NAME:	N:\01041 Holmes Gunther American Fork\Cadd\UP\01 T001
SIZE:	ANSI D
PLOT DATE:	11/14/2024 12:45:34 PM
PLOTTED BY:	

ELLEN'S 2 SUBDIVISION
HOLMES HOMES
COVER SHEET

SHEET NUMBER
01
OF 20 SHEETS
DRAWING NAME
TC01

Blue Stakes of UTAH 811
Bluestakes.org

GENERAL NOTES

1. THIS PROJECT IS LOCATED WITHIN THE SENSITIVE LANDS AREA OF THE CITY. A DETAILED ENGINEERING SOILS REPORT TITLED "GEOTECHNICAL STUDY GUNTHER PROPERTY 490 NORTH MARY PULLEY DRIVE AMERICAN FORK, UTAH" PROJECT NUMBER 240090G. DATED: 02 AUG 2024. GIVES SPECIFIC RECOMMENDATIONS THAT SHALL BE FOLLOWED CONCERNING: SITE GRADING, FOUNDATIONS, CONCRETE SLAB ON GRADE, SUBSURFACE DRAINS, PAVEMENT, BACKFILL AND UTILITY TRENCHING.

2. CITY OF AMERICAN FORK, A.P.W.A, UTAH CHAPTER AND UTAH DEPARTMENT OF TRANSPORTATION CONSTRUCTION AND MATERIAL SPECIFICATIONS, CURRENT EDITIONS, AND ANY SUPPLEMENTS THERETO (HEREAFTER REFERRED TO AS STANDARD SPECIFICATIONS), SHALL GOVERN ALL CONSTRUCTION ITEMS UNLESS OTHERWISE NOTED. IF A CONFLICT BETWEEN SPECIFICATIONS IS FOUND, THE MORE STRICT SPECIFICATION WILL APPLY AS DECIDED BY THE CITY ENGINEER. ITEM NUMBERS LISTED REFER TO CITY OF AMERICAN FORK ITEM NUMBERS UNLESS OTHERWISE NOTED.

3. CITY ENGINEER WILL NOT BE RESPONSIBLE FOR MEANS, METHODS, PROCEDURES, TECHNIQUES, OR SEQUENCED OF CONSTRUCTION THAT ARE NOT SPECIFIED HEREIN. THE CITY ENGINEER WILL NOT BE RESPONSIBLE FOR SAFETY ON THE WORK SITE, OR FOR FAILURE BY THE CONTRACTOR TO PERFORM WORK ACCORDING TO CONTRACT DOCUMENTS.

4. THE DEVELOPER OR CONTRACTOR SHALL BE RESPONSIBLE TO OBTAIN ALL NECESSARY PERMITS INCLUDING BUT NOT LIMITED TO ROAD CUT PERMITS AND NOTICES OF INTENT (NOI), BUILDING PERMITS, ETC.

5. THE CONTRACTOR SHALL NOTIFY THE CITY OF AMERICAN FORK, PUBLIC WORKS DEPARTMENT IN WRITING AT LEAST 7 WORKING DAYS PRIOR TO BEGINNING CONSTRUCTION AND REQUEST A PRE-CONSTRUCTION MEETING. BOND FOR PUBLIC IMPROVEMENTS AND INSPECTION FEES MUST BE PAID IN FULL PRIOR TO REQUESTING A PRE-CONSTRUCTION MEETING.

6. THE CONTRACTOR SHALL BE SOLELY RESPONSIBLE FOR COMPLYING WITH ALL FEDERAL, STATE AND LOCAL SAFETY REQUIREMENTS INCLUDING THE OCCUPATIONAL SAFETY AND HEALTH ACT OF 1970. THE CONTRACTOR SHALL EXERCISE PRECAUTION, ALWAYS FOR THE PROTECTION OF PERSONS (INCLUDING EMPLOYEES) AND PROPERTY. IT SHALL ALSO BE THE SOLE RESPONSIBILITY OF THE CONTRACTOR TO INITIATE, MAINTAIN AND SUPERVISE ALL SAFETY REQUIREMENTS, PRECAUTIONS AND PROGRAMS IN CONNECTION WITH THE WORK, INCLUDING THE REQUIREMENTS FOR CONFINED SPACES PER 29 CFR 1910.146.

7. FOLLOWING COMPLETION OF CONSTRUCTION OF THE SITE IMPROVEMENTS AND BEFORE REQUESTING OCCUPANCY, A PROOF SURVEY SHALL BE PROVIDED TO THE CITY OF AMERICAN FORK, PUBLIC WORKS DEPARTMENT, THAT DOCUMENTS "AS-BUILT" ELEVATIONS, DIMENSIONS, SLOPES AND ALIGNMENTS OF ALL ELEMENTS OF THIS PROJECT. THE PROOF SURVEY SHALL BE PREPARED, SIGNED AND SUBMITTED BY THE PROFESSIONAL ENGINEER WHO SEALED THE CONSTRUCTION DRAWINGS.

8. THE CONTRACTOR SHALL RESTRICT CONSTRUCTION ACTIVITY TO PUBLIC RIGHT-OF-WAY AND AREAS DEFINED AS PERMANENT AND/OR TEMPORARY CONSTRUCTION EASEMENTS, UNLESS OTHERWISE AUTHORIZED BY THE CITY ENGINEER.

9. THE CONTRACTOR SHALL CAREFULLY PRESERVE BENCHMARKS, PROPERTY CORNERS, REFERENCE POINTS, STAKES AND OTHER SURVEY REFERENCE MONUMENTS OR MARKERS. IN CASES OF WILLFUL OR CARELESS DESTRUCTION, THE CONTRACTOR SHALL BE RESPONSIBLE FOR RESTORATIONS. RESETTING OF MARKERS SHALL BE PERFORMED BY A LICENSED UTAH PROFESSIONAL SURVEYOR AS APPROVED BY THE CITY ENGINEER.

10. NON-RUBBER TIRED VEHICLES SHALL NOT BE MOVED ON OR ACROSS PUBLIC STREETS OR HIGHWAYS WITHOUT THE WRITTEN PERMISSION OF THE CITY ENGINEER.

11. THE CONTRACTOR SHALL RESTORE ALL DISTURBED AREAS TO EQUAL OR BETTER CONDITION THAN EXISTED BEFORE CONSTRUCTION. DRAINAGE DITCHES OR WATERCOURSES THAT ARE DISTURBED BY CONSTRUCTION SHALL BE RESTORED TO THE GRADES AND CROSS-SECTIONS THAT EXISTED BEFORE CONSTRUCTION.

12. TRACKING OR SPILLING MUD, DIRT OR DEBRIS UPON STREETS, RESIDENTIAL OR COMMERCIAL DRIVES, SIDEWALKS OR BIKE PATHS IS PROHIBITED. ANY SUCH OCCURRENCE SHALL BE CLEANED UP IMMEDIATELY BY THE CONTRACTION AT NO COST TO THE CITY. IF THE CONTRACTOR FAILS TO REMOVE SAID MUD, DIRT, DEBRIS, OR SPILLAGE, THE CITY RESERVES THE RIGHT TO REMOVE THESE MATERIALS AND CLEAN AFFECTED AREAS, THE COST OF WHICH SHALL BE THE RESPONSIBILITY OF THE CONTRACTOR.

13. DISPOSAL OF EXCESS EXCAVATION WITHIN SPECIAL FLOOD HAZARD AREAS (100-YEAR FLOODPLAIN) MUST BE APPROVED BY THE CITY ENGINEER.

14. ALL SIGNS, LANDSCAPING, STRUCTURES OR OTHER APPURTENANCES WITHIN RIGHT-OF-WAY DISTURBED OR DAMAGED DURING CONSTRUCTION SHALL BE REPLACED OR REPAIRED TO THE SATISFACTION OF THE CITY ENGINEER. THE COST OF THIS WORK SHALL BE THE RESPONSIBILITY OF THE CONTRACTOR.

15. ALL FIELD TILE BROKEN OR ENCOUNTERED DURING EXCAVATION SHALL BE REPLACED OR REPAIRED AND CONNECTED TO THE PUBLIC STORM SEWER SYSTEM AS DIRECTED BY THE CITY ENGINEER. THE COST OF THIS WORK SHALL BE THE RESPONSIBILITY OF THE CONTRACTOR.

16. ALL PRECAST CONCRETE PRODUCTS SHALL BE INSPECTED AT THE LOCATION OF MANUFACTURE. APPROVED PRECAST CONCRETE PRODUCTS WILL BE STAMPED OR HAVE SUCH IDENTIFICATION NOTING THAT INSPECTION HAS BEEN CONDUCTED BY THE CITY OF AMERICAN FORK. PRECAST CONCRETE PRODUCTS WITHOUT PROOF OF INSPECTION SHALL NOT BE APPROVED FOR INSTALLATION.

17. ALL TRENCHES WITHIN PUBLIC RIGHT-OF-WAY SHALL BE BACKFILLED ACCORDING TO THE APPROVED CONSTRUCTION DRAWINGS OR SECURELY PLATED DURING NONWORKING HOURS.

18. TRENCHES OUTSIDE THESE AREAS SHALL BE BACKFILLED OR SHALL BE PROTECTED BY APPROVED TEMPORARY FENCING OR BARRICADES DURING NONWORKING HOURS. CLEAN UP SHALL FOLLOW CLOSELY BEHIND THE TRENCHING OPERATION.

19. ALL TREES WITHIN THE CONSTRUCTION AREA NOT SPECIFICALLY DESIGNATED FOR REMOVAL SHALL BE PRESERVED, WHETHER SHOWN OR NOT SHOWN ON THE APPROVED CONSTRUCTION DRAWINGS. TREES TO BE PRESERVED SHALL BE PROTECTED WITH HIGH VISIBILITY FENCING PLACED A MINIMUM OF 15 FEET FROM THE TREE TRUNK. TREES 6-INCHES OR GREATER AT DBH (DIAMETER BREAST HEIGHT) MUST BE PROTECTED WITH FENCING PLACED AT THE CRITICAL ROOT ZONE OR 15 FEET, WHICHEVER IS GREATER.

20. TREES NOT INDICATED ON THE APPROVED CONSTRUCTION DRAWINGS FOR REMOVAL MAY NOT BE REMOVED WITHOUT PRIOR APPROVAL OF THE DIVISION OF ENGINEERING.

21. PERMITS TO CONSTRUCT IN THE RIGHT-OF-WAY OF EXISTING STREETS MUST BE OBTAINED FROM THE CITY OF AMERICAN FORK, PUBLIC WORKS DEPARTMENT BEFORE COMMENCING CONSTRUCTION.

22. THE CONTRACTOR SHALL BE RESPONSIBLE FOR THE CONDITION OF TRENCHES WITHIN THE RIGHT-OF-WAY AND PUBLIC EASEMENTS FOR A PERIOD OF ONE YEAR FROM THE FINAL ACCEPTANCE OF THE WORK, AND SHALL MAKE ANY NECESSARY REPAIRS AT NO COST TO THE CITY.

23. PAVEMENTS SHALL BE CUT IN NEAT, STRAIGHT LINES THE FULL DEPTH OF THE EXISTING PAVEMENT, OR AS REQUIRED BY THE CITY ENGINEER.

24. THE REPLACEMENT OF DRIVEWAYS, HANDICAPPED RAMPS, SIDEWALKS, BIKE PATHS, PARKING LOT PAVEMENT, ETC. SHALL BE PROVIDED ACCORDING TO THE APPROVED CONSTRUCTION DRAWINGS AND THE CITY OF AMERICAN FORK STANDARD CONSTRUCTION DRAWINGS.

25. ANY MODIFICATION TO THE WORK SHOWN ON DRAWINGS MUST HAVE PRIOR WRITTEN APPROVAL BY THE CITY ENGINEER.

26. TRAFFIC CONTROL AND OTHER REGULATORY SIGNS SHALL COMPLY WITH THE UTAH DEPARTMENT OF TRANSPORTATION TRAFFIC CONTROL GUIDELINES AND MUTCD MANUAL, CURRENT EDITION.

27. PUBLIC STREET SIGNS SHALL MEET ALL CITY OF AMERICAN FORK SPECIFICATIONS WITH LETTERING COLORED IN WHITE DISPLAYED OVER A GREEN BACKGROUND.

28. PRIVATE STREET SIGNS SHALL MEET ALL CITY OF AMERICAN FORK SPECIFICATIONS WITH LETTERING COLORED IN WHITE DISPLAYED OVER A BLUE BACKGROUND.

TRAFFIC CONTROL

1. TRAFFIC CONTROL SHALL BE FURNISHED, ERECTED, MAINTAINED, AND REMOVED BY THE CONTRACTOR ACCORDING TO UTAH DEPARTMENT OF TRANSPORTATION, TRAFFIC CONTROL GUIDELINES OR MANUAL OF UNIFORM TRAFFIC CONTROL DEVICES, CURRENT EDITION.

2. ALL TRAFFIC LANES OF PUBLIC ROADWAYS SHALL BE FULLY OPEN TO TRAFFIC FROM 7:00 AM TO 9:00 AM AND FROM 4:00 PM TO 6:00 PM UNLESS AUTHORIZED DIFFERENTLY BY THE CITY ENGINEER.

3. AT ALL OTHER HOURS THE CONTRACTOR SHALL MAINTAIN MINIMUM ONE-LANE TWO-WAY TRAFFIC. TRAFFIC CIRCULATION MUST BE SUPERVISED BY A CERTIFIED FLAGGER.

4. STEADY – BURNING, TYPE "C" LIGHTS SHALL BE REQUIRED ON ALL BARRICADES, DRUMS, AND SIMILAR TRAFFIC CONTROL DEVICES IN USE AT NIGHT.

5. ACCESS FROM PUBLIC ROADWAYS TO ALL ADJOINING PROPERTIES FOR EXISTING RESIDENTS OR BUSINESSES SHALL BE MAINTAINED THROUGHOUT THE DURATION OF THE PROJECT FOR MAIL, PUBLIC WATER AND SANITARY SEWER SERVICE, AND EMERGENCY VEHICLES.

6. THE CONTRACTOR SHALL PROVIDE A TRAFFIC CONTROL PLAN DETAINING THE PROPOSED MAINTENANCE OF TRAFFIC PROCEDURES. THE TRAFFIC CONTROL PLAN MUST INCORPORATE ANY TRAFFIC CONTROL DETAILS CONTAINED HEREIN.

7. THE TRAFFIC CONTROL PLAN PROPOSED BY THE CONTRACTOR MUST BY APPROVED BY THE CITY ENGINEER PRIOR TO CONSTRUCTION.

8. TRAFFIC CONTROL REQUIRING ROAD CLOSURES AND/OR DETOURING MUST BE APPROVED BY THE CITY COUNCIL.

UTILITIES

1. THE CONTRACTOR SHALL GIVE NOTICE OF INTENT TO CONSTRUCT TO BLUE STAKE (TELEPHONE NUMBER 800-662-4111) AT LEAST 2 WORKING DAYS BEFORE START OF CONSTRUCTION.

2. THE IDENTITY AND LOCATIONS OF EXISTING UNDERGROUND UTILITIES IN THE CONSTRUCTION AREA HAVE BEEN SHOWN ON THE APPROVED CONSTRUCTION DRAWINGS AS ACCURATELY AS PROVIDED BY THE OWNER OF THE UNDERGROUND UTILITY. THE CITY OF AMERICAN FORK AND THE CITY ENGINEER ASSUMES NO RESPONSIBILITY FOR THE ACCURACY OR DEPTHS OF UNDERGROUND FACILITIES SHOWN ON THE APPROVED CONSTRUCTION DRAWINGS. IF DAMAGE IS CAUSED, THE CONTRACTOR SHALL BE RESPONSIBLE FOR REPAIR OF THE SAME AND FOR ANY RESULTING CONTINGENT DAMAGE.

3. LOCATION, SUPPORT, PROTECTION AND RESTORATION OF ALL EXISTING UTILITIES AND APPURTENANCES, WHETHER SHOWN OR NOT SHOWN ON THE APPROVED CONSTRUCTION DRAWINGS SHALL BE THE RESPONSIBILITY OF THE CONTRACTOR.

4. WHEN UNKNOWN OR INCORRECTLY LOCATED UNDERGROUND UTILITIES ARE ENCOUNTERED DURING CONSTRUCTION, THE CONTRACTOR SHALL IMMEDIATELY NOTIFY THE OWNER AND THE CITY ENGINEER.

STRIPING AND SIGNING

1. ALL STRIPING MUST BE DONE FOLLOWING UTAH DEPARTMENT OF TRANSPORTATION GUIDELINES AND MUTCD MANUAL RECOMMENDATIONS, CURRENT EDITION.

2. ALL SIGNING MUST BE DONE FOLLOWING MUTCD MANUAL RECOMMENDATIONS, CURRENT EDITION.

3. ONLY SAND BLASTING IS ALLOWED FOR REMOVAL OF EXISTING STRIPING.

4. CONTRACTOR IS RESPONSIBLE FOR REMOVAL OF CONFLICTING EXISTING STRIPING.

5. MATERIALS USED FOR STRIPING MUST COMPLY WITH THE UTAH DEPARTMENT OF TRANSPORTATION STANDARD SPECIFICATIONS.

USE OF FIRE HYDRANTS

1. THE CONTRACTOR SHALL MAKE PROPER ARRANGEMENTS WITH THE AMERICAN FORK CITY, WATER DEPARTMENT FOR THE USE OF FIRE HYDRANTS WHEN USED FOR WORK PERFORMED UNDER THIS PROJECT'S APPROVAL.

EROSION AND SEDIMENT CONTROL

1. THE CONTRACTOR OR DEVELOPER IS RESPONSIBLE FOR SUBMITTING A NOTICE OF INTENT (NOI) TO BE REVIEWED AND APPROVED BY THE UTAH DIVISION OF WATER QUALITY.

2. THE NOI MUST BE SUBMITTED TO UTAH DIVISION OF WATER QUALITY 45 DAYS PRIOR TO THE START OF CONSTRUCTION AND MAY ENTITLE COVERAGE UNDER THE UTAH DIVISION OF WATER QUALITY GENERAL PERMIT FOR STORM WATER DISCHARGES ASSOCIATED WITH CONSTRUCTION ACTIVITY. A PROJECT LOCATION MAP MUST BE SUBMITTED WITH THE NOI.

3. A SEDIMENT AND EROSION CONTROL PLAN MUST BE SUBMITTED TO THE CITY ENGINEER FOR APPROVAL IF A SEDIMENT AND EROSION CONTROL PLAN HAS NOT ALREADY BEEN INCLUDED WITH THE APPROVED CONSTRUCTION DRAWINGS. THIS PLAN MUST BE MADE AVAILABLE AT THE PROJECT SITE AT ALL TIMES.

4. A UPDES STORM WATER DISCHARGE PERMIT MAY BE REQUIRED. THE CONTRACTOR SHALL BE CONSIDERED THE PERMITTEE.

5. THE CONTRACTOR SHALL PROVIDE SEDIMENT CONTROL AT ALL POINTS WHERE STORM WATER RUNOFF LEAVES THE SITE, INCLUDING WATERWAYS, OVERLAND SHEET FLOW, AND STORM SEWERS.

6. ACCEPTED METHODS OF PROVIDING EROSION/SEDIMENT CONTROL INCLUDE BUT ARE NOT LIMITED TO: SEDIMENT BASINS, SILT FILTER FENCE, AGGREGATE CHECK DAMS, AND TEMPORARY GROUND COVER. HAY OR STRAW BALES ARE NOT PERMITTED.

7. THE CONTRACTOR SHALL PROVIDE ADEQUATE DRAINAGE OF THE WORK AREA AT ALL TIMES CONSISTENT WITH EROSION CONTROL PRACTICES.

8. DISTURBED AREAS THAT WILL REMAIN UNWORKED FOR 30 DAYS OR MORE SHALL BE SEEDED OR PROTECTED WITHIN SEVEN CALENDAR DAYS OF THE DISTURBANCE.

9. OTHER SEDIMENT CONTROLS THAT ARE INSTALLED SHALL BE MAINTAINED UNTIL VEGETATIVE GROWTH HAS BEEN ESTABLISHED. THE CONTRACTOR SHALL BE RESPONSIBLE FOR THE REMOVAL OF ALL TEMPORARY SEDIMENT DEVICES AT THE CONCLUSION OF CONSTRUCTION BUT NOT BEFORE GROWTH OF PERMANENT GROUND COVER.

SANITARY SEWERS

1. SANITARY SEWAGE COLLECTION SYSTEMS SHALL BE CONSTRUCTED IN ACCORDANCE WITH THE RULES, REGULATIONS, STANDARDS AND SPECIFICATIONS OF THE CITY OF AMERICAN FORK, PUBLIC WORKS DEPARTMENT AND THE UTAH DEPARTMENT OF HEALTH CODE AND REGULATIONS.

2. THE MINIMUM REQUIREMENTS FOR SANITARY SEWER PIPE WITH DIAMETERS 15 INCHES AND SMALLER SHALL BE REINFORCED CONCRETE PIPE ASTM C76 CLASS 3, OR PVC SEWER PIPE ASTM D3034, SDR 35.

3. PIPE FOR 6-INCH DIAMETER HOUSE SERVICE LINES SHALL BE PVC PIPE ASTM D3034, SDR 35. PVC PIPE SHALL NOT BE USED AT DEPTHS GREATER THAN 28 FEET. PIPE MATERIALS AND RELATED STRUCTURES SHALL BE SHOP TESTED IN ACCORDANCE WITH CITY OF AMERICAN FORK CONSTRUCTION INSPECTION DIVISION QUALITY CONTROL REQUIREMENTS.

4. ALL MANHOLE LIDS SHALL BE PROVIDED WITH CONTINUOUS SELF-SEALING GASKETS.

5. THE APPROVED CONSTRUCTION DRAWINGS SHALL SHOW WHERE BOLT-DOWN LIDS ARE REQUIRED.

6. SANITARY SEWER MANHOLES SHALL BE PRECAST CONCRETE OR AS APPROVED BY THE CITY ENGINEER AND CONFORM TO THE CITY OF AMERICAN FORK SANITARY MANHOLE STANDARD DRAWING. MANHOLE LIDS SHALL INCLUDE THE WORD SEWER.

7. ALL PVC SEWER PIPES SHALL BE DEFLECTION TESTED NO LESS THAN 60 DAYS AFTER COMPLETION OF BACKFILLING OPERATIONS.

8. AT THE DETERMINATION OF THE CITY ENGINEER, THE CONTRACTOR MAY BE REQUIRED TO PERFORM A TV INSPECTION OF THE SANITARY SEWER SYSTEM PRIOR TO FINAL ACCEPTANCE BY THE CITY. THIS WORK SHALL BE COMPLETED BY THE CONTRACTOR AT HIS EXPENSE.

9. VISIBLE LEAKS OR OTHER DEFECTS OBSERVED OR DISCOVERED DURING TV INSPECTION SHALL BE REPAIRED TO THE SATISFACTION OF THE ENGINEER.

10. ROOF DRAINS, FOUNDATION DRAINS, FIELD TILE OR OTHER CLEAN WATER CONNECTIONS TO THE SANITARY SEWER SYSTEM ARE STRICTLY PROHIBITED ACCORDING TO THE AMERICAN FORK CODE OF ORDINANCES.

11. ALL WATER LINES SHALL BE LOCATED AT LEAST 10 FEET HORIZONTALLY AND 18 INCHES VERTICALLY, FROM SANITARY SEWERS AND STORM SEWERS, TO THE GREATEST EXTENT PRACTICABLE.

12. WHERE SANITARY SEWERS CROSS WATER MAINS OR OTHER SEWERS OR OTHER UTILITIES, TRENCH BACKFILL SHALL BE PLACED BETWEEN THE PIPES CROSSING AND SHALL BE COMPACTED GRANULAR MATERIAL ACCORDING TO THE CITY STANDARD SPECIFICATIONS. IN THE EVENT THAT A WATER LINE MUST CROSS WITHIN 18 INCHES OF A SANITARY SEWER, THE SANITARY SEWER SHALL BE CONCRETE ENCASED OR CONSIST OF DUCTILE IRON PIPE MATERIAL.

13. EXISTING SANITARY SEWER FLOWS SHALL BE MAINTAINED AT ALL TIMES. COSTS FOR PUMPING AND BYPASSING SHALL BE INCLUDED IN THE CONTRACTOR'S UNIT PRICE BID FOR THE RELATED ITEMS.

14. THE CONTRACTOR SHALL FURNISH ALL MATERIAL, EQUIPMENT, AND LABOR TO MAKE CONNECTIONS TO EXISTING MANHOLES.

15. ALL SEWER LINES SHALL BE PLACED AT A MINIMUM DEPTH OF 4 FEET MEASURED FROM TOP OF FINISHED GRADE TO TOP OF SEWER LINE.

Blue Stakes of UTAH 811 Bluestakes.org

PERIGEE CONSULTING
CIVIL • STRUCTURAL • SURVEY
8089 SOUTH 1300 WEST, SUITE 160
801.628.6004 TEL 801.590.0611 FAX
WEST JORDAN, UT 84088
WWW.PERIGEECIVIL.COM

LICENSED PROFESSIONAL ENGINEER
No. 13937226
AUSTIN EARL WEAVER
15 NOV 2024
STATE OF UTAH

AMERICAN FORK CITY

CITY ENGINEER DATE

MARK	DESCRIPTION	DATE	APPR.

DESIGNED BY:	AEW
DWN BY:	AEW
CKD BY:	TVW
SUBMITTED BY:	
DATE:	13 NOV 2024
SOLICITATION NO:	
CONTRACT NO:	01041
FILE NAME:	N:\01041 Holmes Gunther American Fork\Cadd\pl\02 GN01
SIZE:	ANSI D
PLOTTED BY:	
PLOT DATE:	11/14/2024 2:35:32 PM
REV:	

ELLEN'S 2 SUBDIVISION
HOLMES HOMES
GENERAL NOTES

SHEET NUMBER
02
OF 20 SHEETS
DRAWING NAME
GN01

11/14/2024 2:35:32 PM

STORM SEWER

1. ALL STORM WATER DETENTION AND RETENTION AREAS AND MAJOR FLOOD ROUTING SWALES SHALL BE CONSTRUCTED TO FINISH GRADE AND HYDRO – SEEDED AND HYDRO – MULCHED ACCORDING TO THE CITY OF AMERICAN FORK STANDARD SPECIFICATIONS.
2. HERE PRIVATE STORM SEWERS CONNECT TO PUBLIC STORM SEWER, THE LAST RUN OF PRIVATE STORM SEWER CONNECTING TO THE PUBLIC STORM SEWER SHALL BE REINFORCED CONCRETE PIPE CONFORMING TO ASTM DESIGNATION C76, WALL B, CLASS IV FOR PIPE DIAMETERS 12 INCHES TO 15 INCHES, CLASS III FOR 18 INCHES TO 24 INCH PIPES, AND 27 INCHES AND LARGER PIPE SHALL BE CLASS II, UNLESS OTHERWISE SHOWN ON THE APPROVED CONSTRUCTION DRAWINGS.
3. GRANULAR BACKFILL SHALL BE COMPACTED GRANULAR MATERIAL ACCORDING TO AMERICAN FORK CITY STANDARD SPECIFICATIONS.
4. ALL PUBLIC STORM SEWERS SHALL BE REINFORCED CONCRETE PIPE CONFORMING TO ASTM DESIGNATION C76, WALL B, CLASS IV FOR PIPE DIAMETERS 12 INCHES TO 15 INCHES, CLASS III FOR 18 INCHES TO 24 INCH PIPES, AND 27 INCHES AND LARGER PIPE SHALL BE CLASS II, UNLESS OTHERWISE SHOWN ON THE APPROVED CONSTRUCTION DRAWINGS.
5. HEADWALLS AND END WALLS SHALL BE REQUIRED AT ALL STORM SEWER INLETS OR OUTLETS TO AND FROM STORM WATER MANAGEMENT FACILITIES. NATURAL STONE AND/OR BRICK APPROVED BY THE CITY ENGINEER SHALL BE PROVIDED ON ALL VISIBLE HEADWALLS AND/OR END WALLS SURFACES.
6. STORM INLETS OR CATCH BASINS SHALL BE CHANNELIZED AND HAVE BICYCLE SAFE GRATES. MANHOLE LIDS SHALL INCLUDE THE WORD STORM.
7. STORM SEWER OUTLETS GREATER THAN 18 INCHES IN DIAMETER ACCESSIBLE FROM STORM WATER MANAGEMENT FACILITIES OR WATERCOURSES SHALL BE PROVIDED WITH SAFETY GRATES, AS APPROVED BY THE CITY ENGINEER.

WATER LINE

1. ALL WATER LINE MATERIALS SHALL BE PROVIDED AND INSTALLED ACCORDING TO CURRENT SPECIFICATIONS OF THE CITY OF AMERICAN FORK, WATER DEPARTMENT.
2. ALL PUBLIC WATER PIPE WITH A DIAMETER 3 INCHES TO 8 INCHES SHALL BE DUCTILE IRON, CLASS 53. PUBLIC WATER PIPE 12 INCHES IN DIAMETER OR LARGER SHALL BE DUCTILE IRON, CLASS 54.
3. ONLY FIRE HYDRANTS CONFORMING TO CITY OF AMERICAN FORK STANDARDS WILL BE APPROVED FOR USE.
4. PUBLIC WATER LINES SHALL BE DISINFECTED BY THE CITY OF AMERICAN FORK, WATER DEPARTMENT. REQUESTS FOR WATER LINE CHLORINATION SHALL BE MADE THROUGH THE CITY OF AMERICAN FORK, WATER DEPARTMENT. THE COST FOR CHLORINATION SHALL BE PAID FOR BY THE CONTRACTOR.
5. ALL WATER LINES SHALL BE DISINFECTED ACCORDING TO CITY OF AMERICAN FORK STANDARD SPECIFICATIONS. SPECIAL ATTENTION IS DIRECTED TO APPLICABLE SECTIONS OF AMERICAN WATER WORKS ASSOCIATION SPECIFICATION C–651, PARTICULARLY FOR FLUSHING (SECTION 5) AND FOR CHLORINATING VALVES AND FIRE HYDRANTS (SECTION 7).
6. PRESSURE TESTING SHALL BE PERFORMED IN ACCORDANCE WITH THE CITY OF AMERICAN FORK, CONSTRUCTION AND MATERIAL SPECIFICATIONS. WHEN WATER LINES ARE READY FOR DISINFECTION, THE CONTRACTOR SHALL SUBMIT TWO (2) SETS OF "AS–BUILT" PLANS, AND A LETTER STATING THAT THE WATER LINES HAVE BEEN PRESSURE TESTED AND NEED TO BE DISINFECTED, TO THE CITY OF AMERICAN FORK, WATER DEPARTMENT.
7. THE CONTRACTOR SHALL BE RESPONSIBLE FOR ALL COSTS ASSOCIATED WITH THE DISINFECTION OF ALL WATER LINES CONSTRUCTION PER THIS PLAN. PRESSURE TESTING SHALL BE PERFORMED IN ACCORDANCE WITH THE CITY OF AMERICAN FORK, CONSTRUCTION AND MATERIAL SPECIFICATIONS.
8. THE CONTRACTOR SHALL PAINT ALL FIRE HYDRANTS ACCORDING TO CITY OF AMERICAN FORK STANDARDS. THE COST OF PAINTING FIRE HYDRANTS SHALL BE INCLUDED IN THE CONTRACT UNIT PRICE FOR FIRE HYDRANTS.
9. NO WATER TAPS OR SERVICE CONNECTIONS (E.G., TO CURB STOPS OR METER PITS) MAY BE ISSUED UNTIL ADJACENT PUBLIC WATER LINES SERVING THE CONSTRUCTION SITE HAVE BEEN DISINFECTED BY THE CITY OF AMERICAN FORK, WATER DEPARTMENT AND HAVE BEEN ACCEPTED BY THE PUBLIC WORKS DEPARTMENT.
10. THE CONTRACTOR SHALL NOTIFY THE CITY OF AMERICAN FORK, WATER DEPARTMENT AT (801) 763 3060 AT LEAST 24 HOURS BEFORE TAPPING INTO EXISTING WATER LINES.
11. ALL WATER MAIN STATIONING SHALL BE BASED ON STREET CENTERLINE STATIONING.
12. ALL BENDS, JOINT DEFLECTIONS AND FITTINGS SHALL BE BACKED WITH CONCRETE PER CITY OF AMERICAN FORK STANDARDS.
13. THE CONTRACTOR SHALL GIVE WRITTEN NOTICE TO ALL AFFECTED PROPERTY OWNERS AT LEAST 1 WORKING DAY BUT NOT MORE THAN 3 WORKING DAYS PRIOR TO ANY TEMPORARY INTERRUPTION OF WATER SERVICE. INTERRUPTION OF WATER SERVICE SHALL BE MINIMIZED AND MUST BE APPROVED BY THE CITY ENGINEER.
14. ALL WATER LINES SHALL BE PLACED AT A MINIMUM DEPTH OF 4 FEET MEASURED FROM TOP OF FINISHED GRADE TO TOP OF WATER LINE. WATER LINES SHALL BE SET DEEPER AT ALL POINTS WHERE NECESSARY TO CLEAR EXISTING OR PROPOSED UTILITY LINES OR OTHER UNDERGROUND RESTRICTIONS BY A MINIMUM OF 18 INCHES.


SECONDARY WATER

1. ALL SECONDARY WATER LINE MATERIALS SHALL BE PROVIDED AND INSTALLED ACCORDING TO CURRENT SPECIFICATIONS OF THE CITY OF AMERICAN FORK.
2. PRESSURE TESTING SHALL BE PERFORMED IN ACCORDANCE WITH THE CITY OF AMERICAN FORK, CONSTRUCTION AND MATERIAL SPECIFICATIONS. WHEN WATER LINES ARE READY FOR DISINFECTION, THE CONTRACTOR SHALL SUBMIT TWO (2) SETS OF "AS–BUILT" PLANS, AND A LETTER STATING THAT THE SECONDARY WATER LINES HAVE BEEN PRESSURE TESTED, TO THE CITY OF AMERICAN FORK.
3. THE CONTRACTOR SHALL NOTIFY THE CITY OF AMERICAN FORK, SECONDARY WATER DEPARTMENT AT (801) 763–3060 AT LEAST 24 HOURS BEFORE TAPPING INTO EXISTING WATER LINES.
4. ALL SECONDARY WATER MAIN STATIONING SHALL BE BASED ON STREET CENTERLINE STATIONING.
5. ALL BENDS, JOINT DEFLECTIONS AND FITTINGS SHALL BE BACKED WITH CONCRETE PER CITY OF AMERICAN FORK STANDARDS.
6. ALL SECONDARY WATER LINES SHALL BE PLACED AT A MINIMUM DEPTH OF 2 FEET MEASURED FROM TOP OF FINISHED GRADE TO TOP OF WATER LINE. SECONDARY WATER LINES SHALL BE SET DEEPER AT ALL POINTS WHERE NECESSARY TO CLEAR EXISTING OR PROPOSED UTILITY LINES OR OTHER UNDERGROUND RESTRICTIONS BY A MINIMUM OF 24 INCHES.


CONSTRUCTION NOTES

1. ALL MATERIALS AND WORKMANSHIP SHALL BE SUBJECT TO INSPECTION BY THE OWNER AND THE CITY OF AMERICAN FORK ENGINEERING DIVISION. THE OWNER AND THE CITY RESERVE THE RIGHT TO ACCEPT OR REJECT ANY SUCH MATERIALS AND WORKMANSHIP THAT DOES NOT CONFORM TO ITS STANDARDS AND SPECIFICATIONS.
2. THE CONTRACTOR SHALL NOTIFY THE CITY OF AMERICAN FORK ENGINEERING DIVISION INSPECTION SECTION, A MINIMUM OF 48 HOURS AND A MAXIMUM OF 96 HOURS PRIOR TO STARTING CONSTRUCTION.
3. THE CONTRACTOR IS SPECIFICALLY CAUTIONED THAT THE LOCATION AND/OR ELEVATION OF EXISTING UTILITIES AS SHOWN ON THESE PLANS IS BASED ON THE RECORDS OF THE VARIOUS UTILITY COMPANIES AND WHERE POSSIBLE, MEASUREMENTS TAKEN IN THE FIELD. THE INFORMATION IS NOT TO BE RELIED ON AS BEING EXACT OR COMPLETE. THE CONTRACTOR IS RESPONSIBLE FOR LOCATING AND PROTECTING ALL UTILITIES WHETHER SHOWN OR NOT SHOWN ON THE PLANS. THIS UTILITY WORK SHALL BE INCLUDED AS PART OF BASIC BID. FIELD RESEARCH SHALL BE DONE PRIOR TO COMPLETING A BID.
4. EXISTING WATER, SANITARY AND STORM SEWER LINES ARE SHOWN BASED ON BEST AVAILABLE INFORMATION. PRIOR TO CONSTRUCTION, THE CONTRACTOR SHALL VERIFY PERTINENT LOCATIONS AND ELEVATIONS SPECIFICALLY AT CONNECTION POINTS AND AT POTENTIAL POINTS OF CONFLICT.
5. CONTRACTOR SHALL BE RESPONSIBLE FOR:
   A) OBTAINING ALL PERMITS AND LICENSES.
   B) PREPARING A TRAFFIC CONTROL PLAN, PROVIDING ALL TRAFFIC DEVICES AS MAY BE REQUIRED BY THE WORK.
   C) COORDINATING WITH ALL UTILITY COMPANIES INVOLVED WITH REGARD TO RELOCATION'S OR ADJUSTMENTS OF AND WITH NO DISRUPTION OF SERVICE.
   D) ALL PROJECT SAFETY INCLUDING BUT NOT LIMITED TO, TRENCH EXCAVATION AND SHORING, TRAFFIC CONTROL, AND SECURITY.
   E) OBTAINING TEMPORARY POWER AND WATER TO THE SITE.
   F) PAYING ALL FEES EXCLUDING CONNECTION FEES AND SYSTEM DEVELOPMENT FEES.
   G) OBTAINING NECESSARY PERMISSION FROM THE CITY FOR AMERICAN FORK AND UDOT FOR ALL WORK IN AND ADJACENT TO THE PUBLIC RIGHT–OF–WAY.
   H) SETTING ALL MANHOLE COVERS, INLET GRATES, WATER VALVES, CLEAN OUTS, FIRE HYDRANTS AND OTHER ACCESS COVERS TO FINISHED PAVEMENT SURFACE OR FINISHED GRADE.
   I) RECORDING AS–BUILT INFORMATION AS PER AMERICAN FORK CITY STANDARDS.
   J) REFER TO AND MEET THE REQUIREMENTS OF THE GEOTECHNICAL REPORT.
   K) KEEPING ADJACENT STREETS FREE AND CLEAN OF ALL DEBRIS AND DIRT FROM THE JOB SITE. CONTRACTOR MUST SWEEP STREETS AS NEEDED AND UPON THE OWNER/CITY REQUEST.
   L) REFER TO ARCHITECTURAL PLANS FOR THE EXACT LOCATION, AND DIMENSIONS OF BUILDING EXITS, RAMPS, TRUCK DOORS, AND UTILITIES ENTRANCE LOCATION.
   M) VERIFYING ELEVATION AND HORIZONTAL LOCATION OF ALL UTILITY POINTS OF CONNECTION PRIOR TO ANY UTILITY INSTALLATION.
   N) OBTAIN U.P.D.E.S. PERMITS AND MONITORING ALL OF THE STORM WATER POLLUTION PREVENTION DEVICES.
6. CONTRACTOR SHALL INSTALL A CONSTRUCTION BARRIER AROUND AND ALONG ENTIRE CONSTRUCTION LIMIT LINE AND NEAR AND ALL AROUND ALL CUTS, TRENCHES, HOLES AND PITS.
7. ENSURE PROPER SIGNS TO INFORM VEHICULAR AND PEDESTRIAN TRAFFIC OF DETOURS AND HAZARDS.
8. EXISTING STRUCTURES AND DEBRIS WITHIN CONSTRUCTION LIMITS ARE TO BE ABANDONED, REMOVED OR RELOCATED AS NECESSARY.
9. CONTRACTOR SHALL BE RESPONSIBLE FOR ALL RELOCATIONS, INCLUDING BUT NOT LIMITED TO; ALL UTILITIES, STORM DRAINAGE, SIGNS, TRAFFIC SIGNALS AND POLES, LANDSCAPE MATERIALS AND IRRIGATION COMPONENTS, ETC. AS REQUIRED. ALL WORK SHALL BE IN ACCORDANCE WITH GOVERNING AUTHORITIES SPECIFICATIONS AND SHALL BE APPROVED BY SUCH.
10. SITE CONTRACTOR SHOULD BE AWARE OF AN ENVIRONMENTALLY SENSITIVE AREA LOCATED NEAR THE PARCEL, WHICH IS PART OF THE AMERICAN FORK COMMERCIAL CENTER OVERALL DEVELOPMENT. EXTREME CARE MUST BE TAKEN IN THE WASHING OF EQUIPMENT AND SITE DISCHARGE OF ANY KIND. COORDINATE WITH SITE DEVELOPER REGARDING THE SPECIFIC RESTRICTIONS FOR THIS CONSERVATION AREA. DO NOT DISCHARGE TO STORM DRAINS.
11. ALL EXISTING LANDSCAPE DAMAGED DURING DEMOLITION SHALL BE PROMPTLY REPAIRED OR REPLACED. CONTRACTOR SHALL MANUALLY WATER ALL AREAS WHERE EXISTING IRRIGATION IS NOT FUNCTIONAL.
12. IF DURING THE CONSTRUCTION PROCESS, CONDITIONS ARE ENCOUNTERED WHICH INDICATE AN UNIDENTIFIED SITUATION IS PRESENT, THE CONTRACTOR SHALL CONTACT THE OWNER AND ENGINEER IMMEDIATELY.
13. DIMENSIONS FOR LAYOUT AND CONSTRUCTION ARE NOT TO BE SCALED FROM ANY DRAWING. IF PERTINENT DIMENSIONS ARE NOT SHOWN CONTACT THE ENGINEER FOR CLARIFICATIONS.
14. IN GENERAL, THE LIMITS OF CONSTRUCTION INCLUDE ALL FACILITIES SHOWN AS PROPOSED ON THE BUILDING AND SITE PLANS. IN ADDITION, ALL ADJACENT PUBLIC IMPROVEMENTS AND PRIVATE IMPROVEMENTS MUST BE REPAIRED, RESTORED, OR COMPLETED TO A FINAL CONDITION. THE CONTRACTOR IS RESPONSIBLE FOR IDENTIFYING PRIOR TO BID ANY ITEMS ON THE SITE, AND CONNECTING PARCELS, THAT WILL REQUIRE REPAIR, REMOVAL, RESTORATION, OR WORK OF ANY KIND TO COMPLETE THE PROPOSED CONSTRUCTION. THESE ITEMS SHALL BE INCLUDED IN THE CONTRACTOR'S BASIC BID.
15. SEE CONSTRUCTION DOCUMENTS AND CONSULT THE DESIGN ENGINEER FOR THE EXACT LOCATIONS OF ALL PROPOSED SAW CUTS REQUIRED. SOME FIELD ADJUSTMENTS MAY BE REQUIRED TO ENSURE PROPER DRAINAGE AT ASPHALT JUNCTIONS.
16. CONTRACTOR SHALL CLEAR AND GRUB SITE AND REMOVE ALL EXCESS MATERIALS FROM SITE AS PART OF THE BASE BID. ABSOLUTELY NO DEPOSITING OF MATERIALS ON OTHER AFCC SITES WITHOUT PERMISSION OF OWNER.


NOTES:
1. REFER TO EARTHTEC ENGINEERING GEOTECHNICAL STUDY PROJECT NO. 240090G DATED 19 FEBRUARY 2024 FOR PAVEMENT DESIGN.
2. STREET CROSS SECTION BASED UPON 62' RIGHT–OF–WAY LOCAL STREET SEE SHEET DT05.
3. CURB AND GUTTER SHALL BE INSTALLED AS TYPE E PER SHEET DT01.
4. REFER TO AMERICAN FORK MUNICIPAL CODE SEC 15.01.1250 FOR COMPLETE PAVING REQUIREMENTS.
5. SIDEWALK SECTION PER DRAWING 15.18 ON SHEET DT06 AND APWA MANUAL OF STANDARD PLANS PLAN 231 AND PLAN 235.

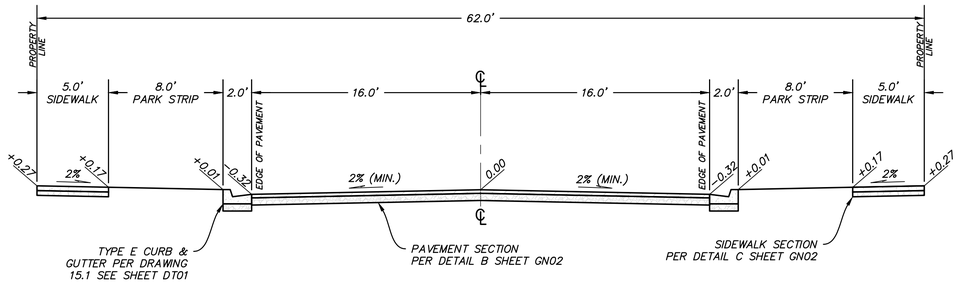

A GN02 **RESIDENTIAL - 32' LOCAL STREET SECTION (62' ROW)**
SCALE: 1" = 5'

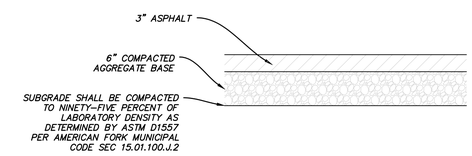

B GN02 **PAVEMENT SECTION (62' ROW LOCAL STREET)**
SCALE: N.T.S.

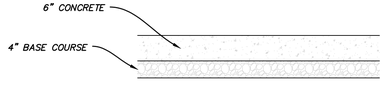

C GN02 **SIDEWALK SECTION**
SCALE: N.T.S.

PERIGEE CONSULTING
CIVIL · STRUCTURAL · SURVEY
8089 SOUTH 1300 WEST, SUITE 160
801.628.6004 TEL 801.590.0911 FAX
WEST JORDAN, UT 84088
WWW.PERIGEECIVIL.COM

LICENSED PROFESSIONAL ENGINEER
No. 13937226
AUSTIN EARL WEAVER
15 NOV 2024
STATE OF UTAH

AMERICAN FORK CITY

CITY ENGINEER DATE

MARK	DESCRIPTION	DATE	APPR.

REV:	
DATE:	13 NOV 2024
SOLICITATION NO:	
CONTRACT NO:	01041
DESIGNED BY:	AEW
CKD BY:	TVW
DWN BY:	AEW
SUBMITTED BY:	
FILE NAME:	N:\01041 Holmes Gunther American Fork\Cadd\Plt\02 GN01
SIZE:	ANSI D
PLOTTED BY:	
PLOT DATE:	11/14/2024 12:45:40 PM

ELLEN'S 2 SUBDIVISION
HOLMES HOMES
GENERAL NOTES

SHEET NUMBER 03
OF 20 SHEETS
DRAWING NAME GN02

Blue Stakes of UTAH 811 Bluestakes.org

N

W E

S

0 30 60 Feet

S89°44'26"E 280.958'

N33°29'28"E 107.570'

S0°32'17"E 35.301'

S0°09'57"W 54.701'

L1

L2

L3

S0°20'00"E 88.235'

DEMO 37 LF OF EXISTING ASPHALT WITH 2' SAWCUT

490 NORTH STREET

L4

L5

L6

S0°19'07"W 139.150'

S0°00'00"E 209.066'

N0°37'07"W 90.000'

EXISTING SQUARE STORM DRAIN BOX (SHALL REMAIN UNDISTURBED)

N89°22'58"E 141.283'

REMOVE EXISTING FENCE

9.82'

16.00'

9.47'

10.00'

900 EAST STREET

N0°42'00"W 347.229'

DEMO 355 LF OF EXISTING ASPHALT WITH 2' SAWCUT

EXISTING POWER POLES/LINES TO BE REMOVED BY ROCKY MOUNTAIN POWER

EXISTING MAILBOX TO REMAIN IN PLACE. SIDEWALK CONCRETE SHALL BE POURED AROUND POST.

N90°00'00"W 476.950'

9	14,091 S.F.	0.32 acres
8	9,020 S.F.	0.21 acres
10	23,408 S.F.	0.54 acres
15	12,984 S.F.	0.30 acres
11	14,156 S.F.	0.32 acres
7	10,519 S.F.	0.24 acres
14	9,112 S.F.	0.21 acres
13	9,674 S.F.	0.22 acres
12	9,236 S.F.	0.21 acres
6	10,448 S.F.	0.24 acres
5	10,527 S.F.	0.24 acres
1	9,306 S.F.	
2	9,309 S.F.	0.21 acres
3	11,543 S.F.	0.26 acres
4	10,558 S.F.	0.24 acres

PERIGEE CONSULTING
CIVIL · STRUCTURAL · SURVEY
8089 SOUTH 1300 WEST, SUITE 160
801.628.6004 TEL 801.566.0911 FAX
WEST JORDAN, UT 84088
WWW.PERIGEECIVIL.COM

LICENSED PROFESSIONAL ENGINEER
No. 13937226
AUSTIN EARL WEAVER
15 NOV 2024
STATE OF UTAH

AMERICAN FORK CITY

CITY ENGINEER DATE

MARK	DESCRIPTION	DATE	APPR.


DESIGNED BY: AEW
DWN BY: AEW
CKD BY: TVW
SUBMITTED BY:
DATE: 13 NOV 2024
SOLICITATION NO:
CONTRACT NO: 01041
FILENAME: N:\01041 Holmes Gunther American Fork\Cadd\Plt\04 DM01.dwg
SIZE: ANSI D
PLOTTED BY:
PLOT DATE: 11/14/2024 12:45:48 PM
REV:

ELLEN'S 2 SUBDIVISION
HOLMES HOMES
DEMOLITION PLAN

SHEET NUMBER
04
OF 20 SHEETS
DRAWING NAME
DM01

Blue Stakes of UTAH 811
Bluestakes.org

11/14/2024 12:45:48 PM

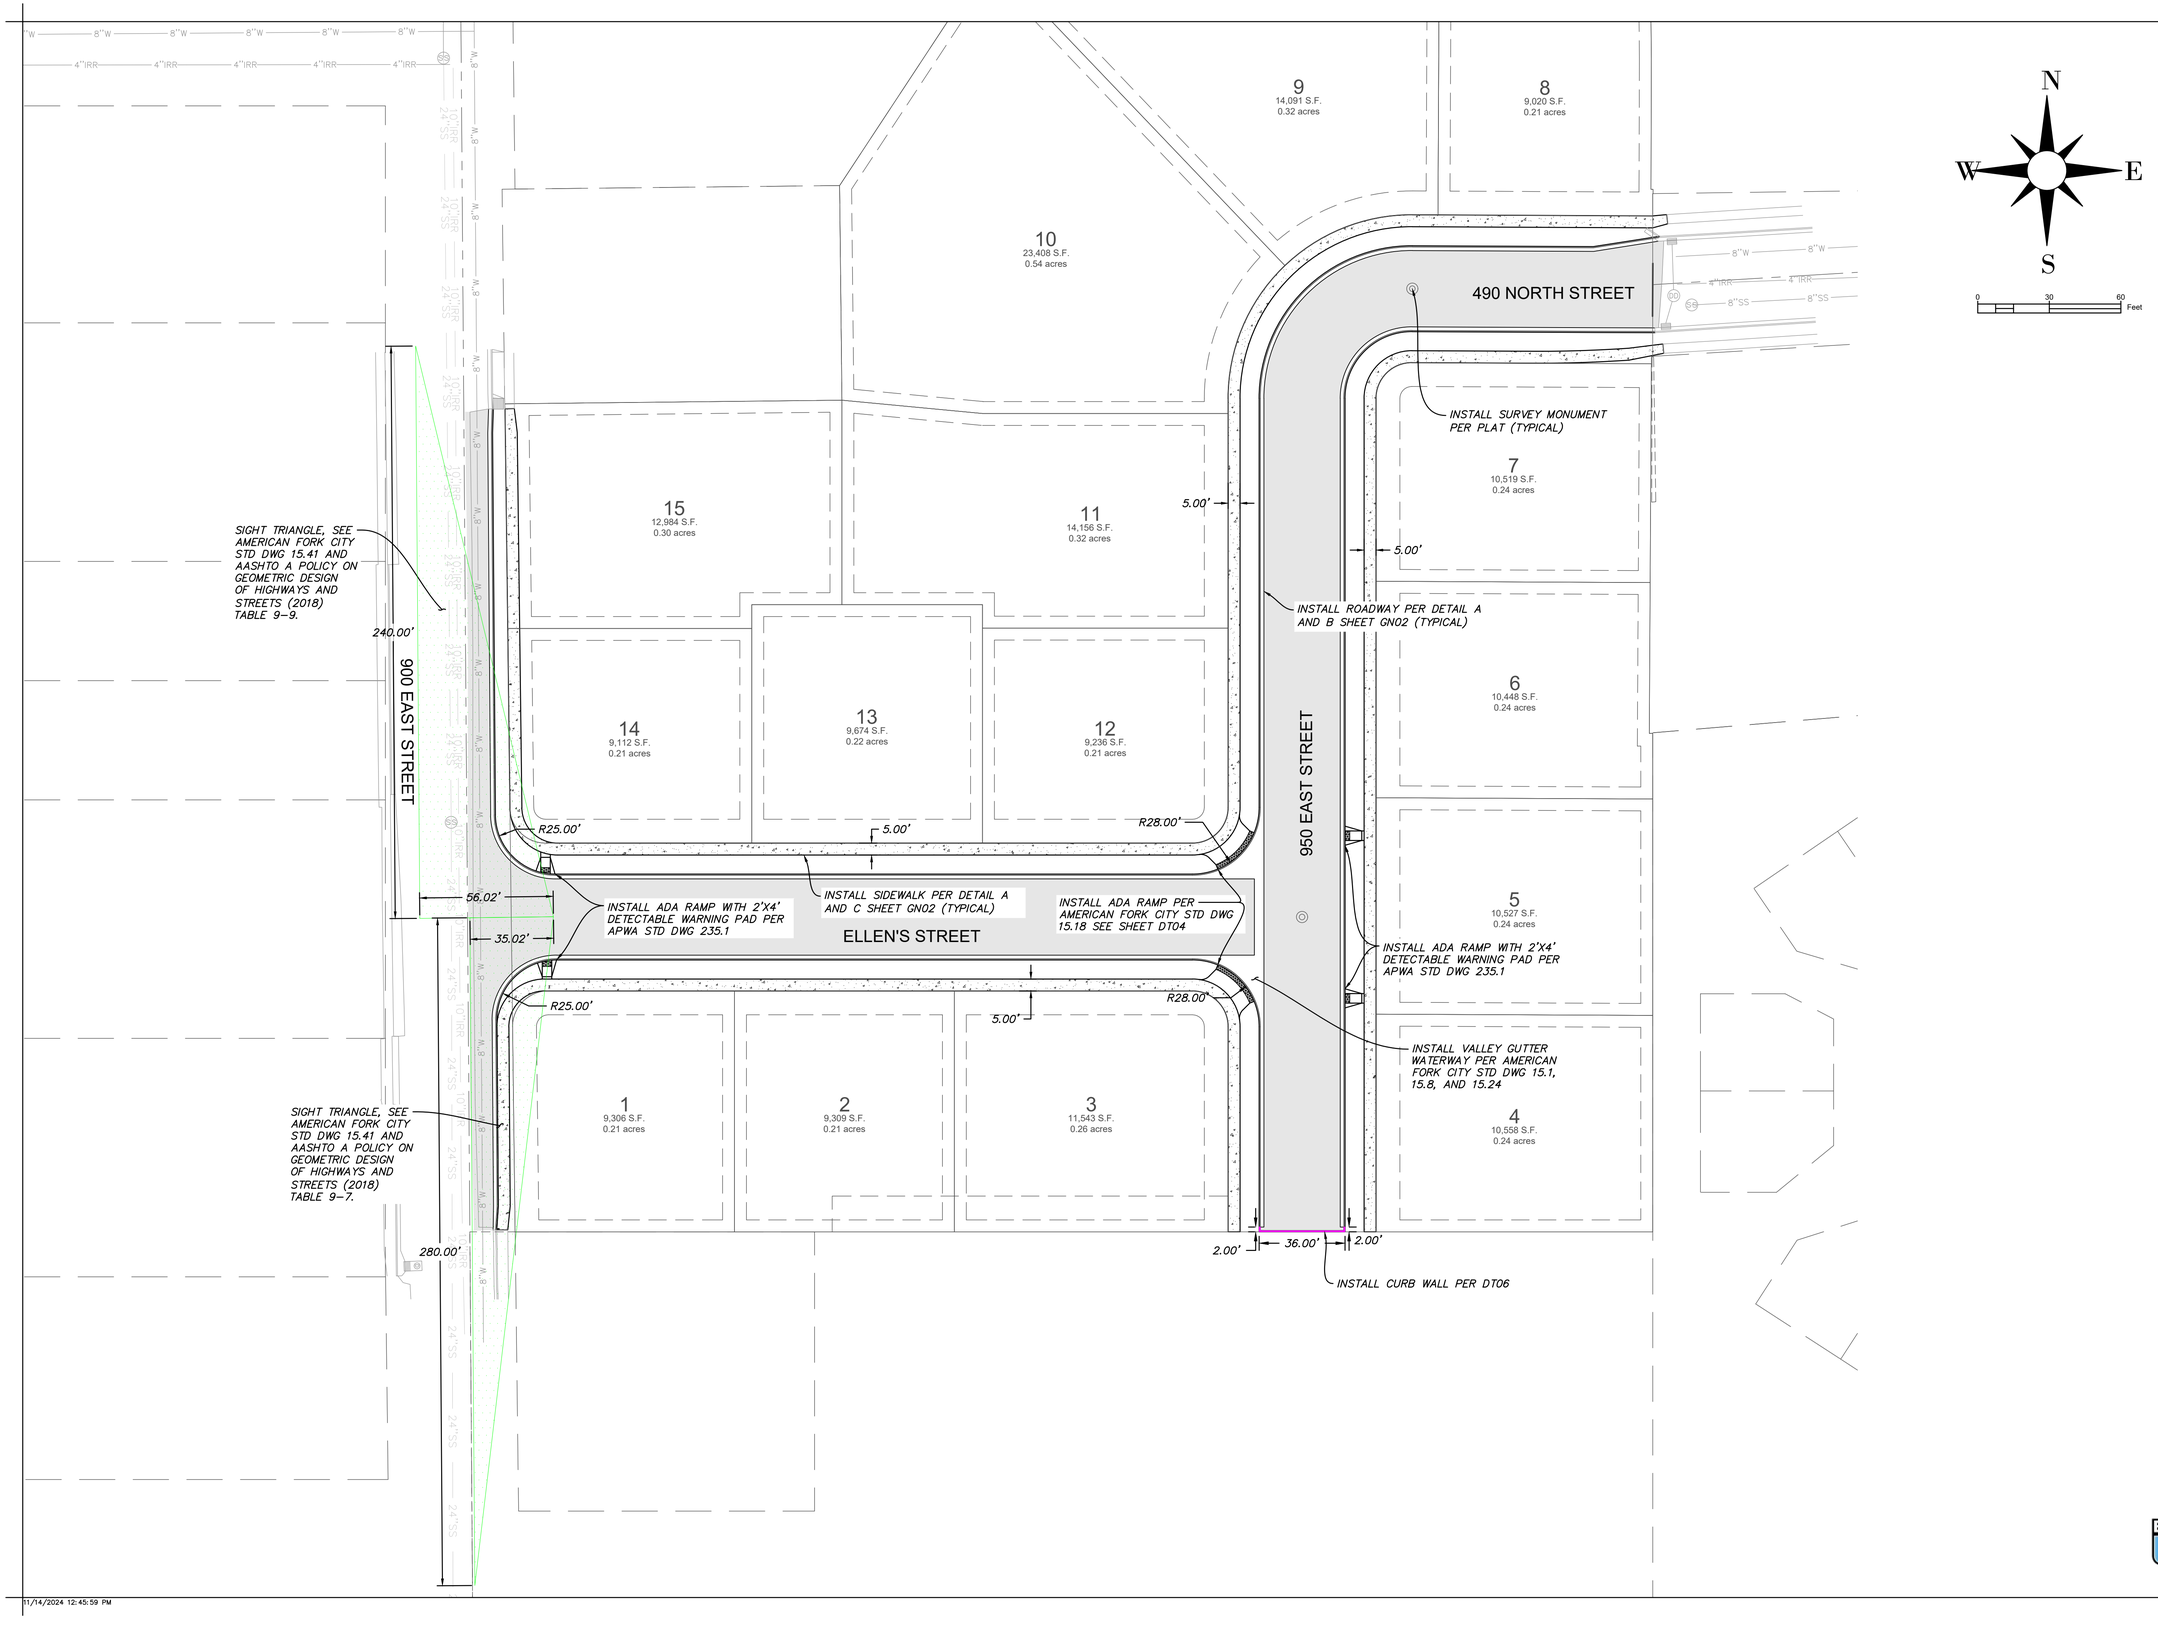

PERIGEE CONSULTING
CIVIL · STRUCTURAL · SURVEY
8089 SOUTH 1300 WEST, SUITE 160
801.628.6004 TEL 801.590.0911 FAX
WEST JORDAN, UT 84088
WWW.PERIGEECIVIL.COM

LICENSED PROFESSIONAL ENGINEER
No. 13937226
AUSTIN EARL WEAVER
15 NOV 2024
STATE OF UTAH

AMERICAN FORK CITY

CITY ENGINEER DATE

MARK	DESCRIPTION	DATE	APPR.

DESIGNED BY:	AEW
DRAWN BY:	AEW
CKD BY:	TVW
SUBMITTED BY:	
FILE NAME:	N:\01041 Holmes Gunther American Fork\Cadd\dgn\05_SP01
SIZE:	ANSI D
PLOTTED BY:	
PLOT DATE:	11/14/2024 12:45:59 PM
REV:	
DATE:	13 NOV 2024
SOLICITATION NO:	
CONTRACT NO:	01041

ELLEN'S 2 SUBDIVISION
HOLMES HOMES
SITE PLAN

SHEET NUMBER
05
OF 20 SHEETS
DRAWING NAME
SP01

Blue Stakes of UTAH 811 bluestakes.org

N
W E
S
0 30 60 Feet

9
14,091 S.F.
0.32 acres

8
9,020 S.F.
0.21 acres

10
23,408 S.F.
0.54 acres

INSTALL BENDS PER PROFILES (SEE PP01–PP02), INSTALL THRUST BLOCKS PER CITY DETAIL 15.21 ON DT04 (TYPICAL)

490 NORTH STREET

CONNECT TO EXISTING 8" WATER AND 4" IRRIGATION LINES. FIELD VERIFY TIE LOCATIONS

Check. Should this be an E Electrical, not a G Gas?

7
10,519 S.F.
0.24 acres

EXISTING SQUARE STORM DRAIN BOX (SHALL REMAIN UNDISTURBED)

FIELD VERIFY TIES TO EXISTING UTILITY LINES

15
12,984 S.F.
0.30 acres

11
14,156 S.F.
0.32 acres

1" WATER LATERAL
1" PRIVATE IRRIGATION LATERAL
4" SEWER LATERAL
(TYPICAL)

10,448 S.F.
0.24 acres

900 EAST STREET

14
9,112 S.F.
0.21 acres

13
9,674 S.F.
0.22 acres

12
9,236 S.F.
0.21 acres

STOP & STREET NAME SIGN

IRRIGATION LOOP
IRR TOP: 4635.21
SS BOTTOM: 4637.28

950 EAST STREET

WATER LINE LOOP
IRR TOP: 4635.25
SS BOTTOM: 4637.35

FIELD VERIFY TIES TO EXISTING UTILITY LINES

ELLEN'S STREET

CAST–IN–PLACE MANHOLE
FIELD VERIFY TIE TO EXISTING

Install lines stops to shutdown water line to install cluster of valves

5
10,527 S.F.
0.24 acres

STOP & STREET NAME SIGN

1
9,306 S.F.
0.21 acres

2

3
11,543 S.F.
0.26 acres

4
10,558 S.F.
0.24 acres

INSTALL UNDERGROUND CONTECH STORM DRAIN STORAGE SYSTEM PER PP04 AND DT08. SEE PERIGEE STORM DRAIN REPORT FOR CALCULATIONS.

11.00'
11.00'
1.00'
152.00'

INSTALL CONTECH CDS UNIT PER PP04 AND DT08.

Sec 15.01.100 E a requires this to be a double inlet

Sec 15.01.100 E a requires this to be a double inlet

City has concerns with this system especially related to maintenance and access.

Can this system be maintained? How will City gain access?

Will curb cuts/driveway access be required to allow vacuum trucks to maintain system for example?

The proposed SD-02 will prevent curb cuts due to its design with its curb inlet as depicted on DT08

UTILITY NOTES:
1. ALL SANITARY SEWER MAINS AND LATERALS MUST BE INSPECTED AND APPROVED BY THE CITY INSPECTOR BEFORE TRENCH BACKFILLING IS COMPLETED.
2. ALL LATERAL CONNECTIONS SHALL BE INSERT–A–TEE OR WYE AT TEN O'CLOCK OR TWO O'CLOCK POSITIONING TO THE CENTER OF THE MAIN LINE.
3. THE CITY ENGINEER SHALL BE INFORMED IF RUTTING/PUMPING OCCURS DURING CONSTRUCTION.
4. ALL EXISTING DRY UTILITY TIE–IN LOCATIONS SHALL BE FIELD VERIFIED.
5. THE PERFORATED MANHOLES SHALL BE INSTALLED PER AMERICAN FORK STANDARD DETAIL DWG 15.14 WITH A 6–FOOT DIAMETER MANHOLE SIZE INSTEAD OF 5–FOOT.
6. ALL DRY UTILITIES TO CONFORM WITH AMERICAN FORK CITY ORDINANCE 17.5.135.

Blue Stakes of UTAH 811 Bluestakes.org

PERIGEE CONSULTING
CIVIL • STRUCTURAL • SURVEY
8089 SOUTH 1300 WEST, SUITE 160
801.628.6004 TEL 801.566.0911 FAX
WEST JORDAN, UT 84088
WWW.PERIGEECIVIL.COM

LICENSED PROFESSIONAL ENGINEER
No. 13937226
AUSTIN EARL WEAVER
15 NOV 2024
STATE OF UTAH

AMERICAN FORK CITY

CITY ENGINEER DATE


MARK	DESCRIPTION	DATE	APPR.

REV:	
DATE:	13 NOV 2024
SOLICITATION NO:	
CONTRACT NO:	01041
PLOT DATE:	11/14/2024 12:46:01 PM
DESIGNED BY:	AEW
DWN BY:	TVW
CKD BY:	AEW
SUBMITTED BY:	
FILENAME:	N:\01041 Holmes Gunther American Fork\Cad\UT\06 UT01
PLOTTED BY:	
SIZE:	ANSI D

ELLEN'S 2 SUBDIVISION
HOLMES HOMES
UTILITY PLAN

SHEET NUMBER
06
OF 20 SHEETS
DRAWING NAME
UT01

11/14/2024 12:46:01 PM

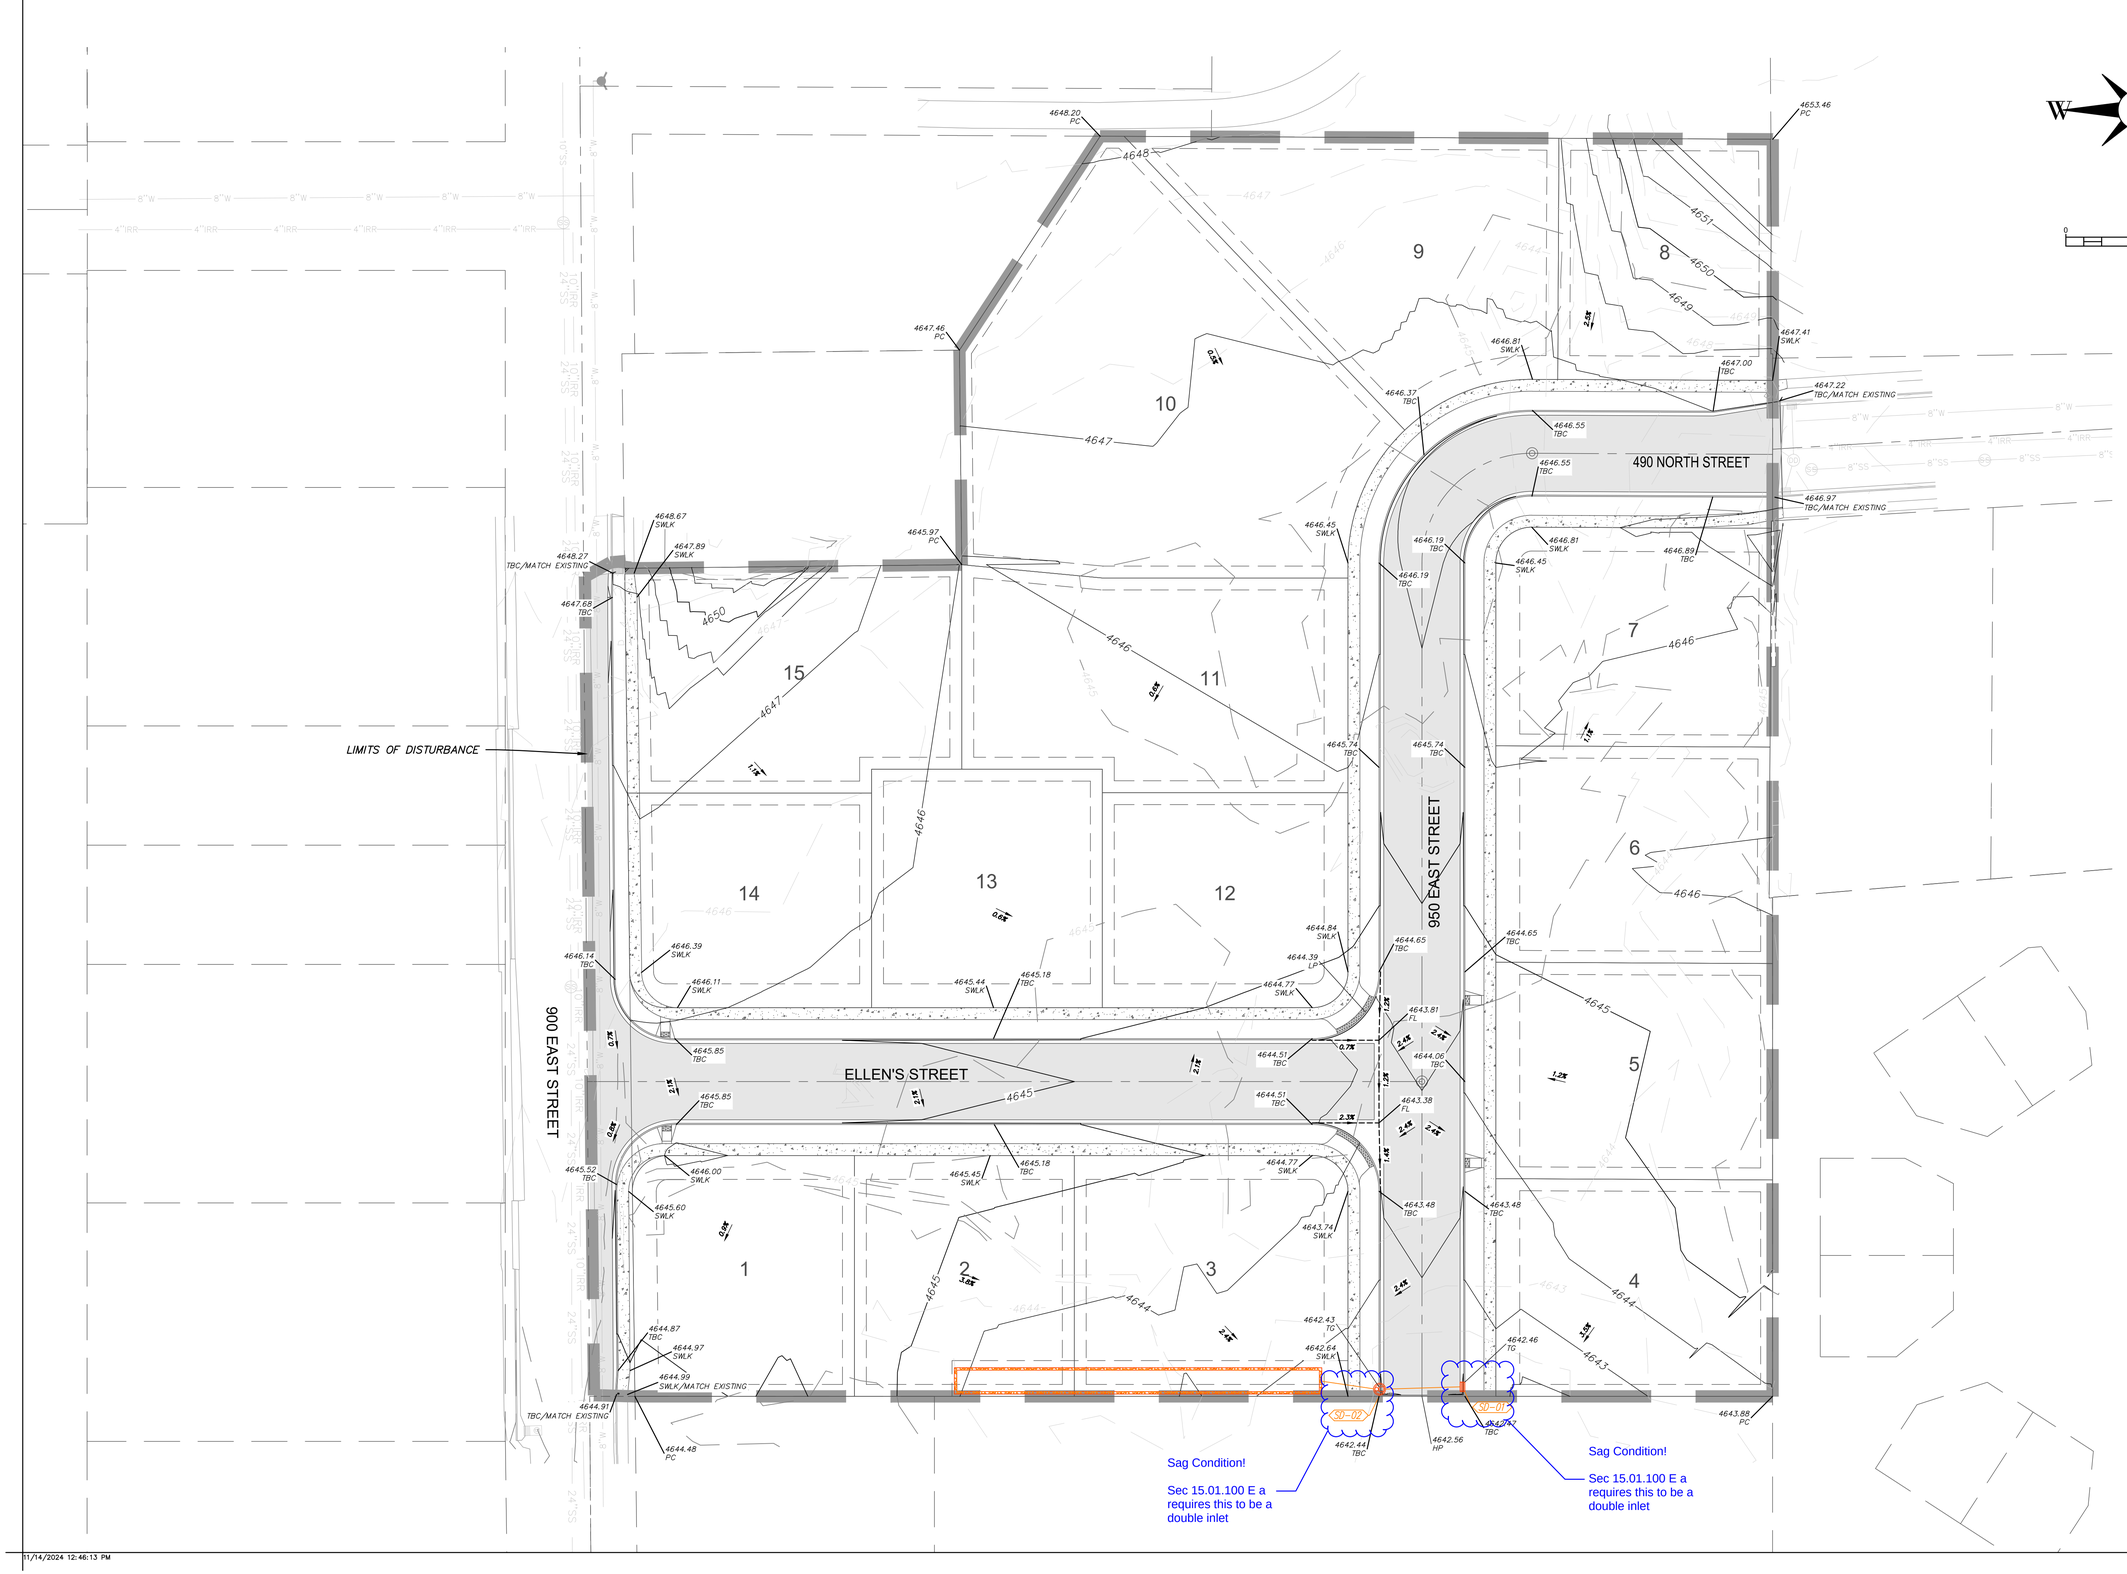

PERIGEE CONSULTING
CIVIL · STRUCTURAL · SURVEY
8689 SOUTH 1300 WEST, SUITE 160
801.628.6004 TEL 801.566.0911 FAX
WEST JORDAN, UT 84088
WWW.PERIGEECIVIL.COM

LICENSED PROFESSIONAL ENGINEER
No. 13937226
AUSTIN EARL WEAVER
15 NOV 2024
STATE OF UTAH

AMERICAN FORK CITY

CITY ENGINEER DATE

MARK	DESCRIPTION	DATE	APPR.

DESIGNED BY:	AEW
DWN BY:	AEW
CKD BY:	TVW
SUBMITTED BY:	
FILENAME:	N:\01041 Holmes Gunther American Fork\Cadd\Plt\07 GR01
SIZE:	ANSI D
PLOTTED BY:	
PLOT DATE:	11/14/2024 12:46:13 PM
CONTRACT NO:	01041
SOLICITATION NO:	
DATE:	13 NOV 2024
REV:	

ELLEN'S 2 SUBDIVISION
HOLMES HOMES
GRADING PLAN

SHEET NUMBER
07
OF 20 SHEETS
DRAWING NAME
GR01

Blue Stakes of UTAH 811
bluestakes.org



KEY MAP


PROFILE LEGEND:

PROPOSED SURFACE


EXISTING SURFACE

PROFILE BAND LEGEND:

EXISTING / PROPOSED

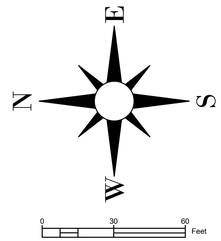


NOTE: CONTRACTOR SHALL FIELD VERIFY ANY PERTINENT EXISTING UTILITY INFORMATION PRIOR TO INSTALLATION OF THE CAST-IN-PLACE MANHOLE AND CONNECTIONS.

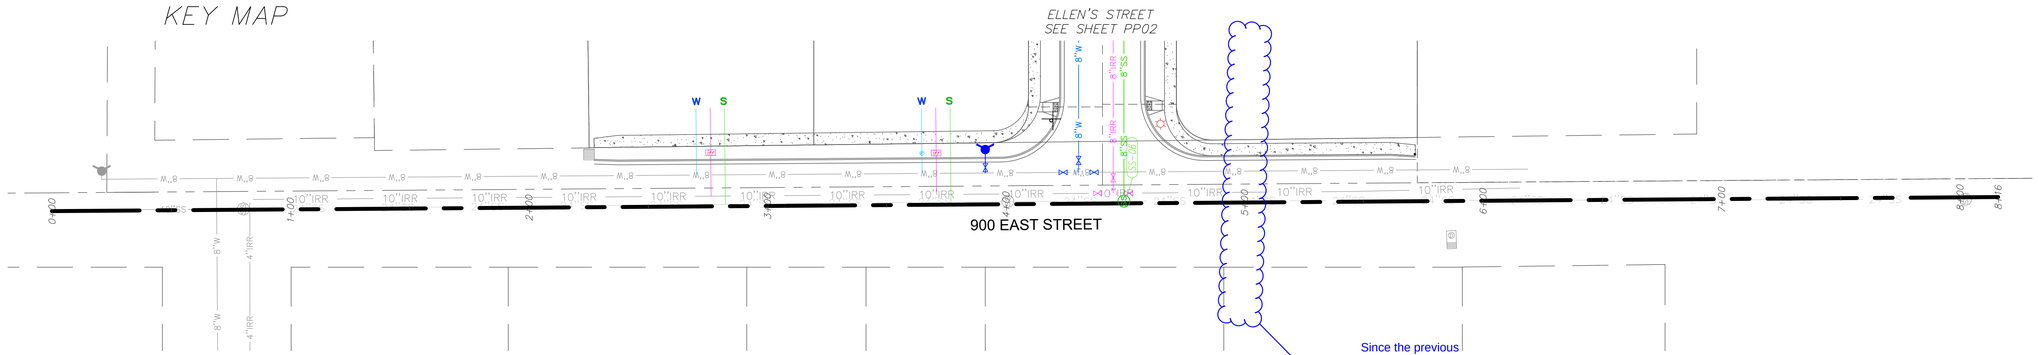

ELLEN'S STREET

STA: 0+00 TO 9+00

Since the previous submittal, this overhead powerline has been removed/frozen on this sheet. If this powerline still exists, it is best to still show it here.

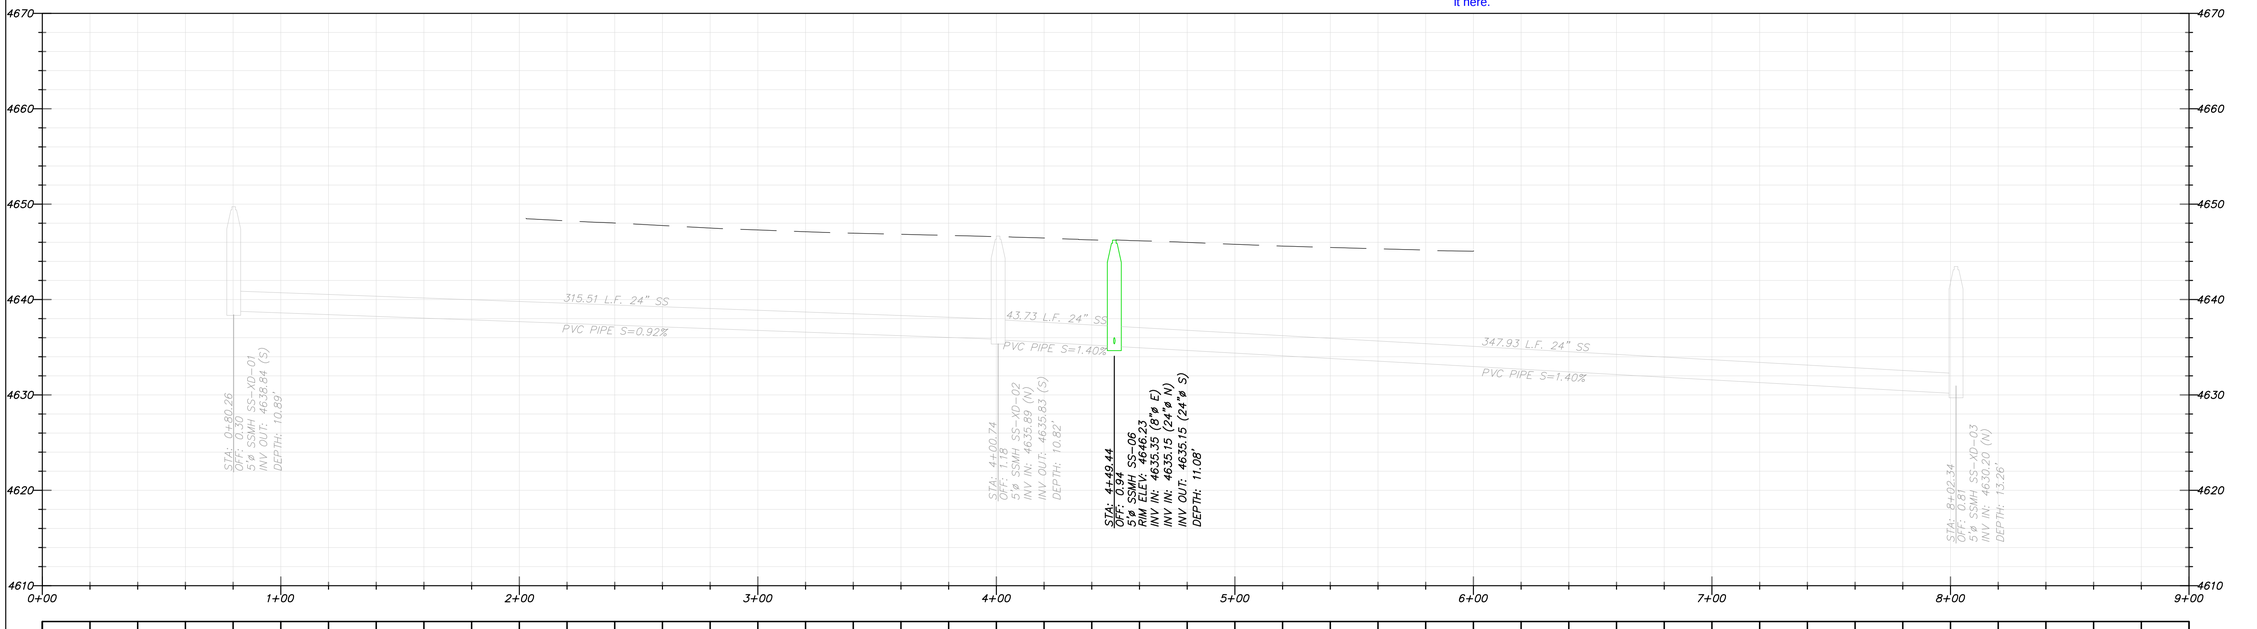

4648.25	4648.02	4647.76	4647.49	4647.29	4647.11	4646.96	4646.84	4646.72	4646.62	4646.45	4646.25	4646.16	4645.99	4645.79	4645.60	4645.45	4645.32	4645.19	4645.08

Blue Stakes of UTAH 811
Bluestakes.org

PERIGEE
CONSULTING
CIVIL - STRUCTURAL - SURVEY
8089 SOUTH 1300 WEST, SUITE 160
801.628.6004 TEL 801.590.0911 FAX
WEST JORDAN, UT 84088
WWW.PERIGEECIVIL.COM

LICENSED PROFESSIONAL ENGINEER
No. 13937226
AUSTIN EARL WEAVER
15 NOV 2024
STATE OF UTAH

AMERICAN FORK CITY

CITY ENGINEER DATE


MARK	DESCRIPTION	DATE	APPR.

DESIGNED BY: AEW	DRAWN BY: AEW	CHKD BY: TVW	SUBMITTED BY:
DATE: 13 NOV 2024	SOLICITATION NO:	CONTRACT NO: 01041	REV:
FILE NAME: N:\01041 Holmes Gunther American Fork\Cadd\PUB PP01			
SIZE: ANSI D	PLOTTED BY:	PLOT DATE: 11/14/2024 12:46:35 PM	

ELLEN'S 2 SUBDIVISION
HOLMES HOMES
PLAN & PROFILE - N 900 E ST

SHEET NUMBER
08
OF 20 SHEETS
DRAWING NAME
PP01


11/14/2024 12:46:35 PM

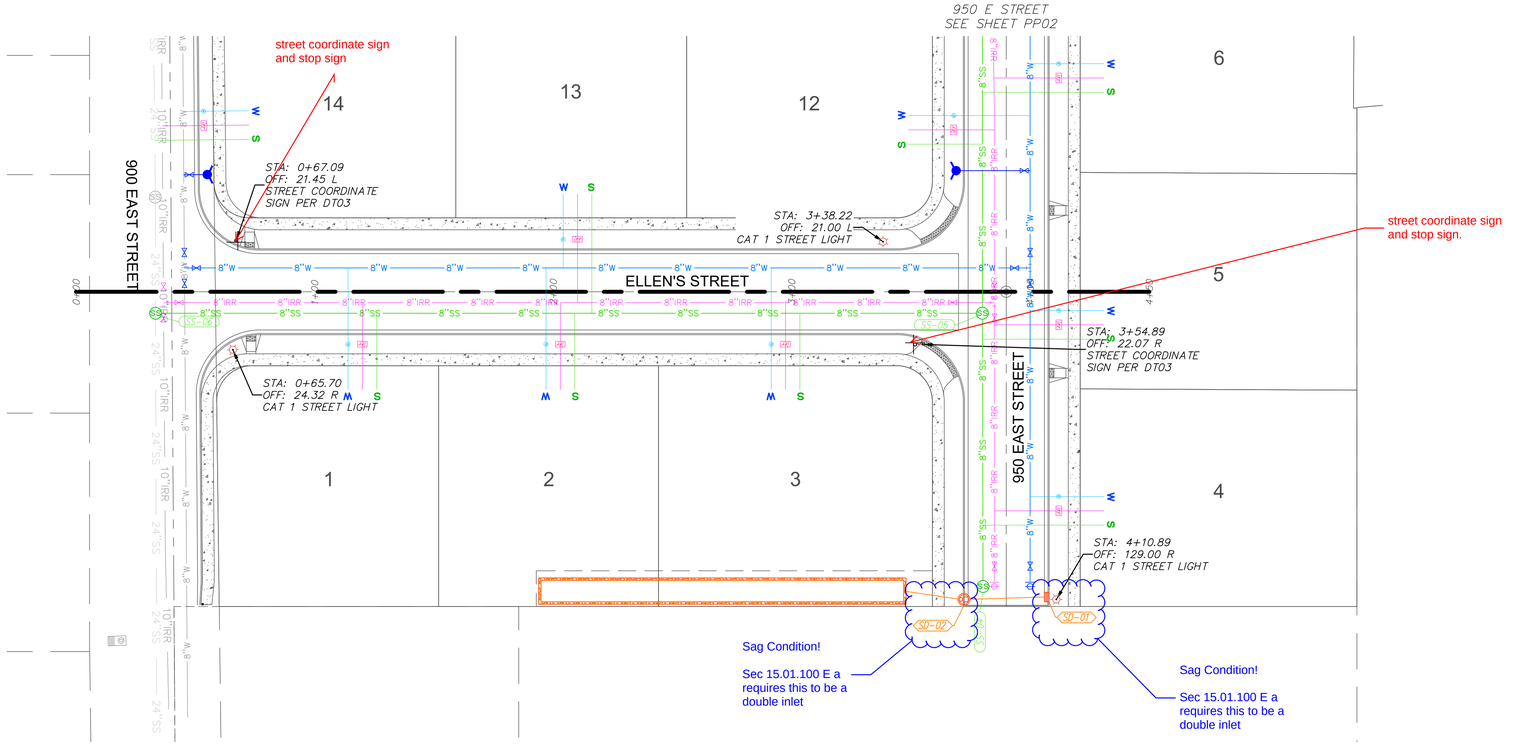

KEY MAP

ELLEN'S STREET

STA: −0+50 TO 5+00

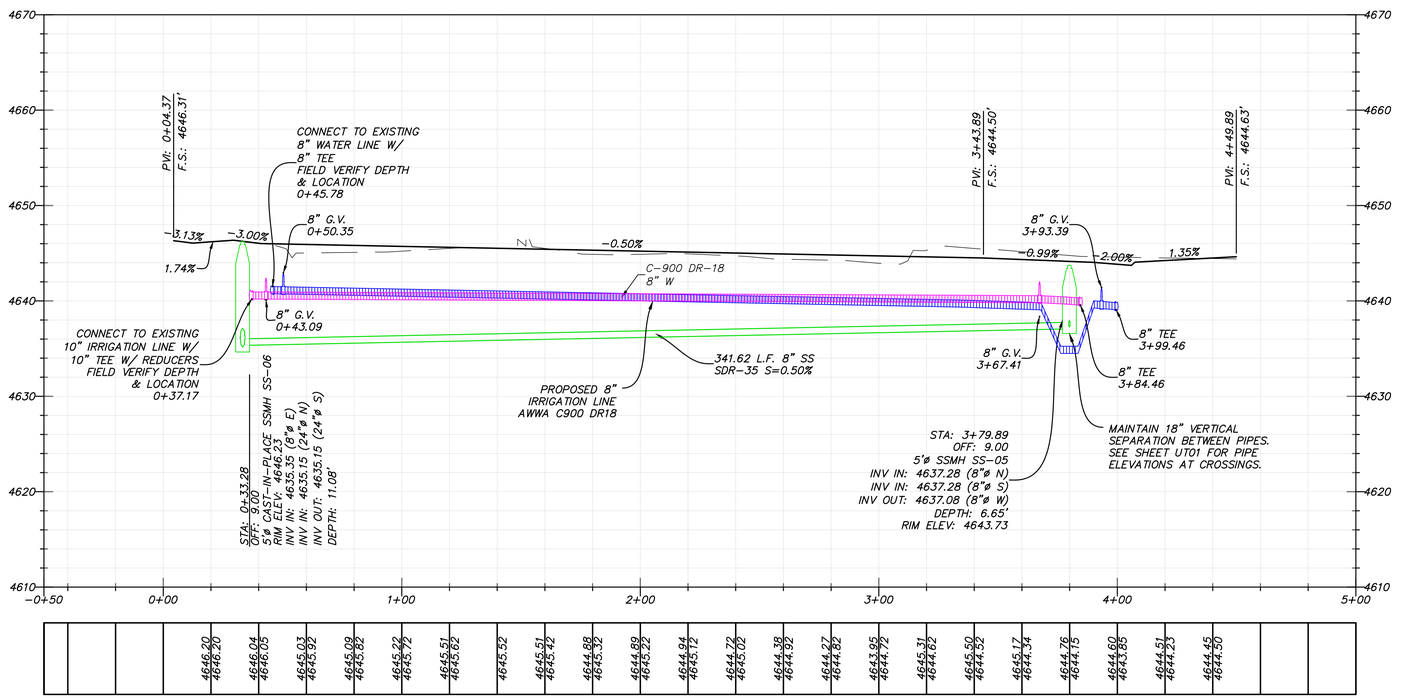

PROFILE LEGEND:

PROPOSED SURFACE

EXISTING SURFACE

PROFILE BAND LEGEND:

EXISTING / PROPOSED

PERIGEE CONSULTING
CIVIL · STRUCTURAL · SURVEY
WEST JORDAN, UT 84088
WWW.PERIGEECIVIL.COM
8089 SOUTH 1300 WEST, SUITE 160
801.628.6004 TEL 801.566.0911 FAX

LICENSED PROFESSIONAL ENGINEER
No. 13937226
AUSTIN EARL WEAVER
15 NOV 2024
STATE OF UTAH

AMERICAN FORK CITY

CITY ENGINEER DATE

MARK	DESCRIPTION	DATE	APPR.


DESIGNED BY:	AEW
DRAWN BY:	AEW
CHECKED BY:	TVW
SUBMITTED BY:	
DATE:	13 NOV 2024
SOLICITATION NO:	
CONTRACT NO:	01041
FILE NAME:	N:\01041 Holmes Gunther American Fork\Cadd\Plt\08 PP01
SIZE:	ANSI D
PLOTTED BY:	
PLOT DATE:	11/14/2024 12:46:38 PM
REV:	


ELLEN'S 2 SUBDIVISION
HOLMES HOMES
PLAN & PROFILE – ELLENS ST

SHEET NUMBER
09
OF 20 SHEETS
DRAWING NAME
PP02

Blue Stakes of UTAH 811 Bluestakes.org

11/14/2024 12:46:38 PM

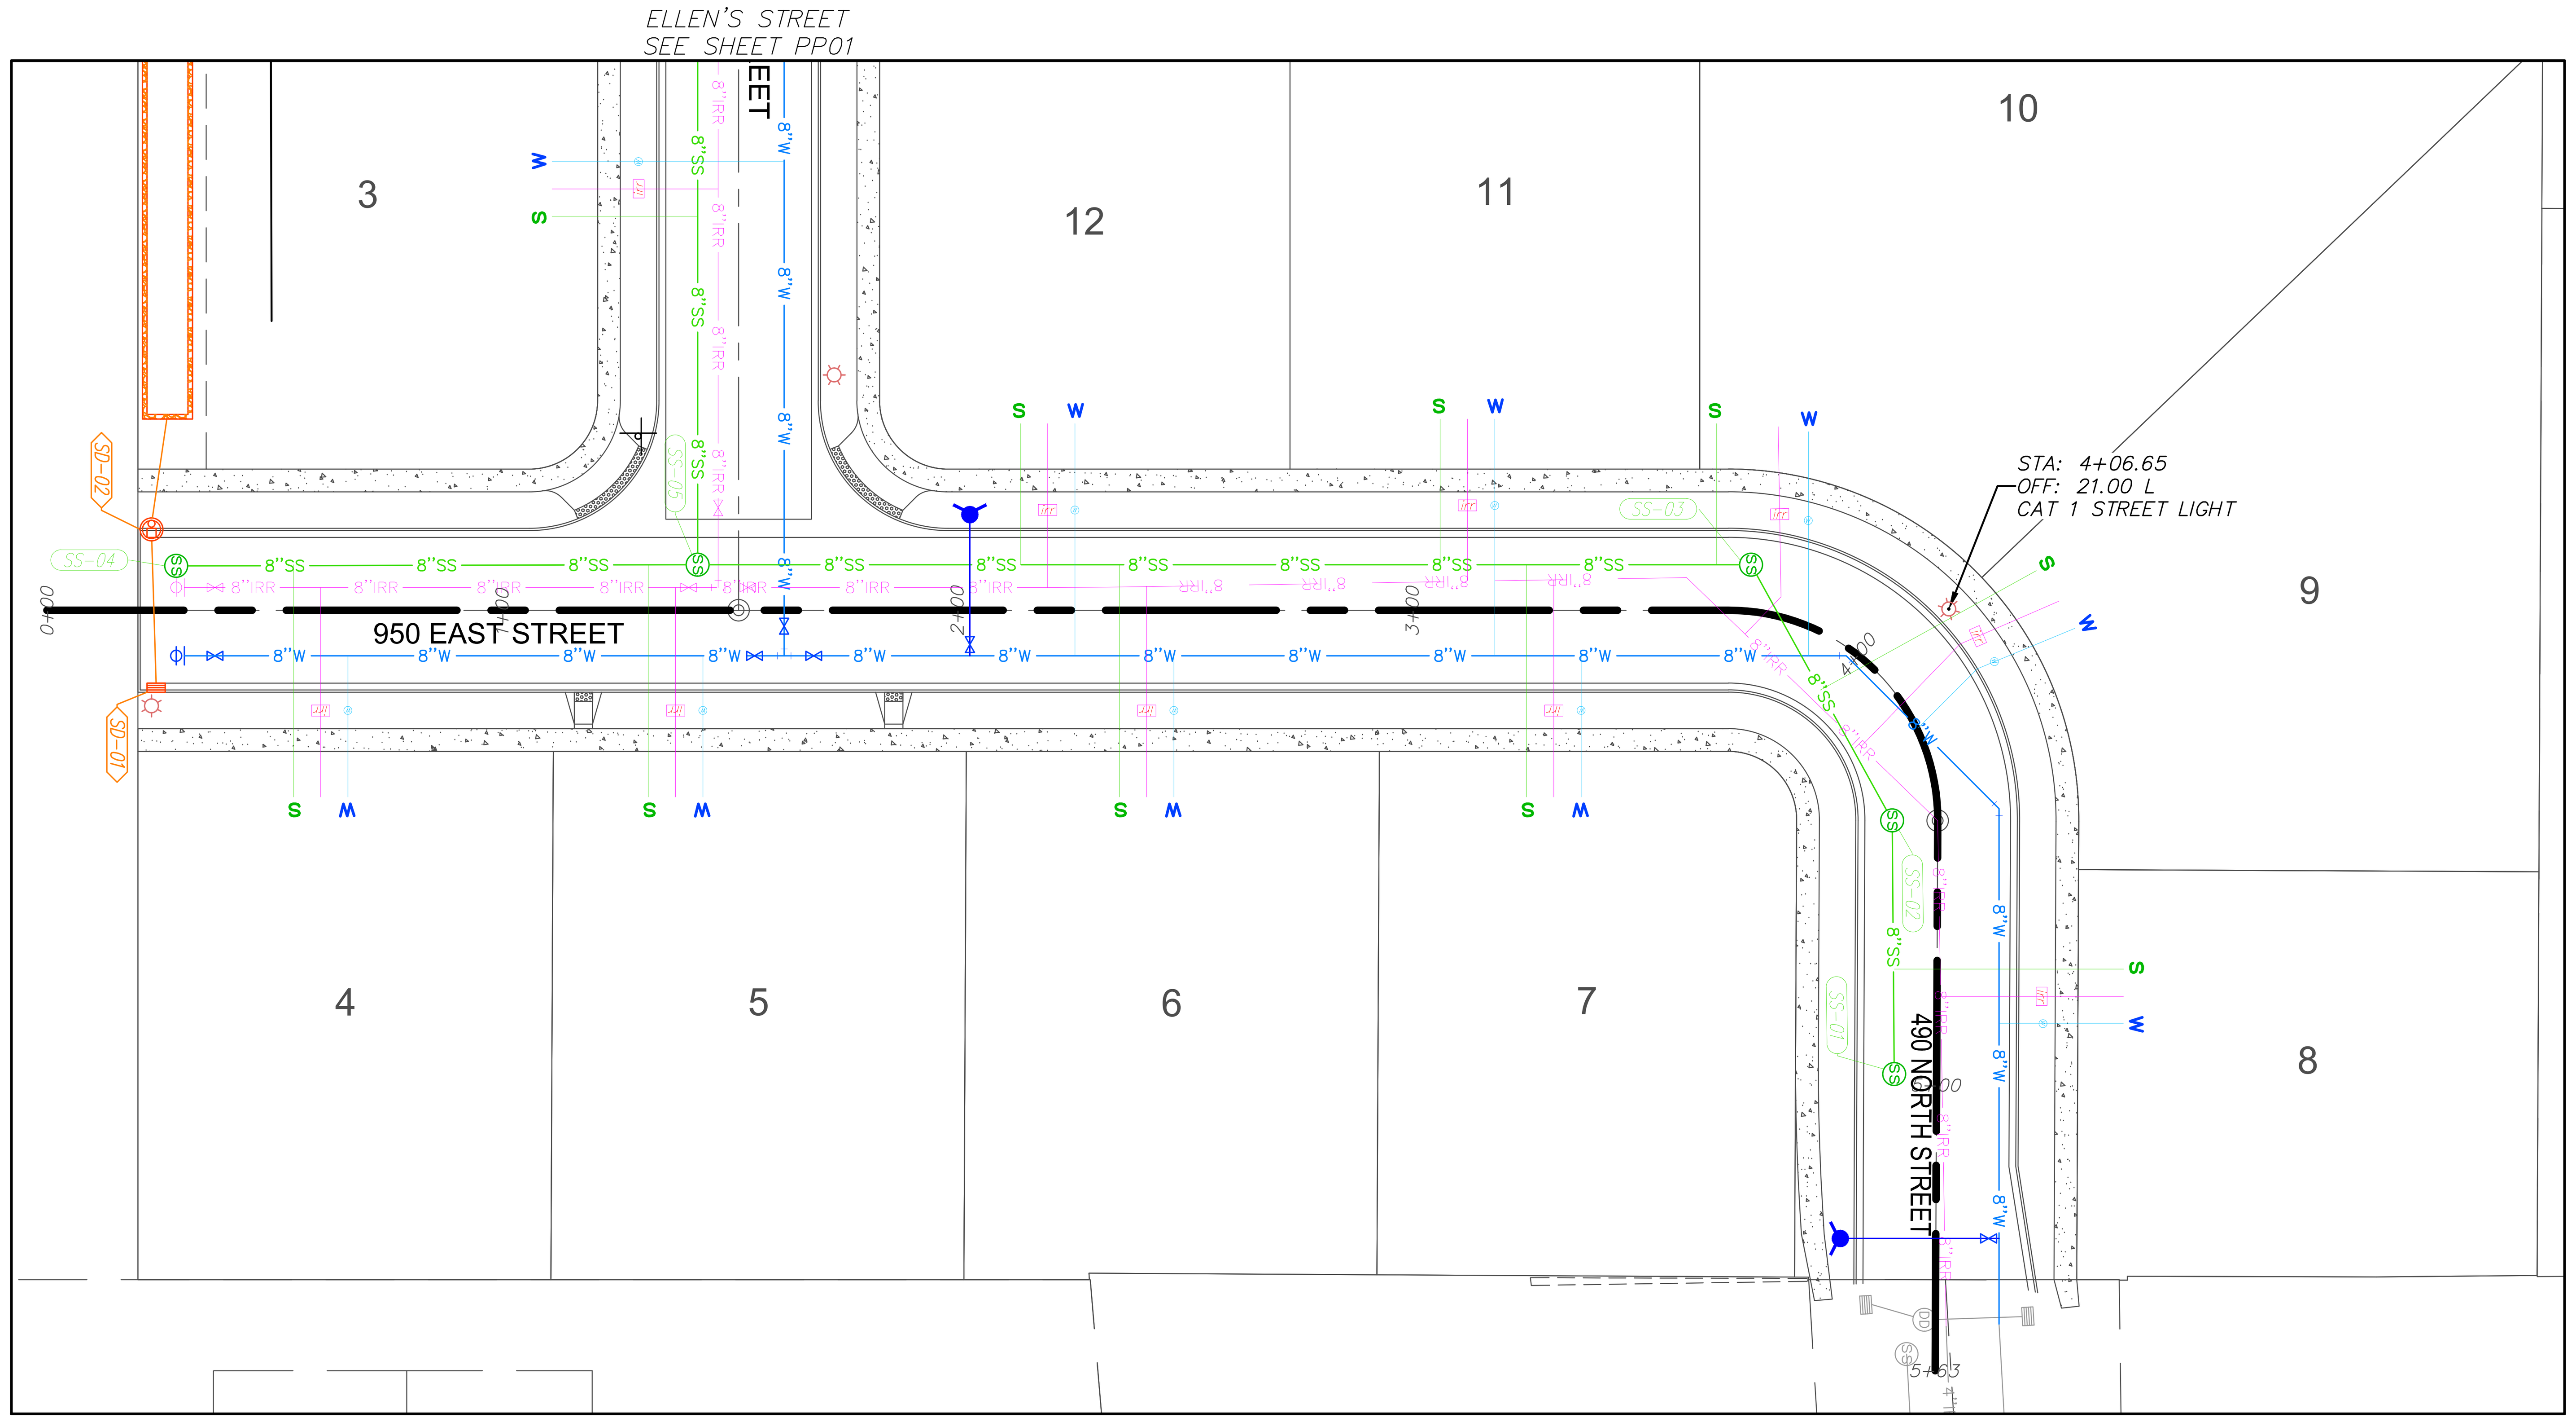

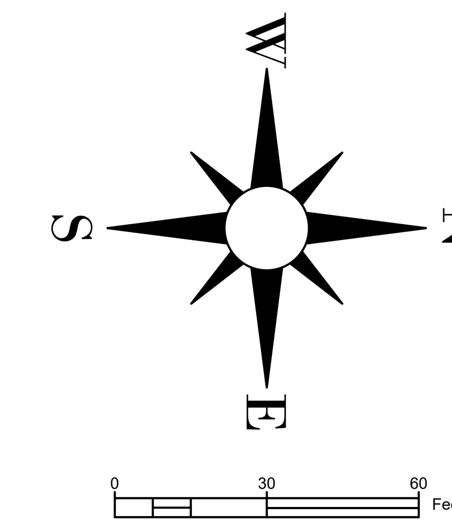




KEY MAP

950 EAST STREET

STA: −1+00 TO 6+50

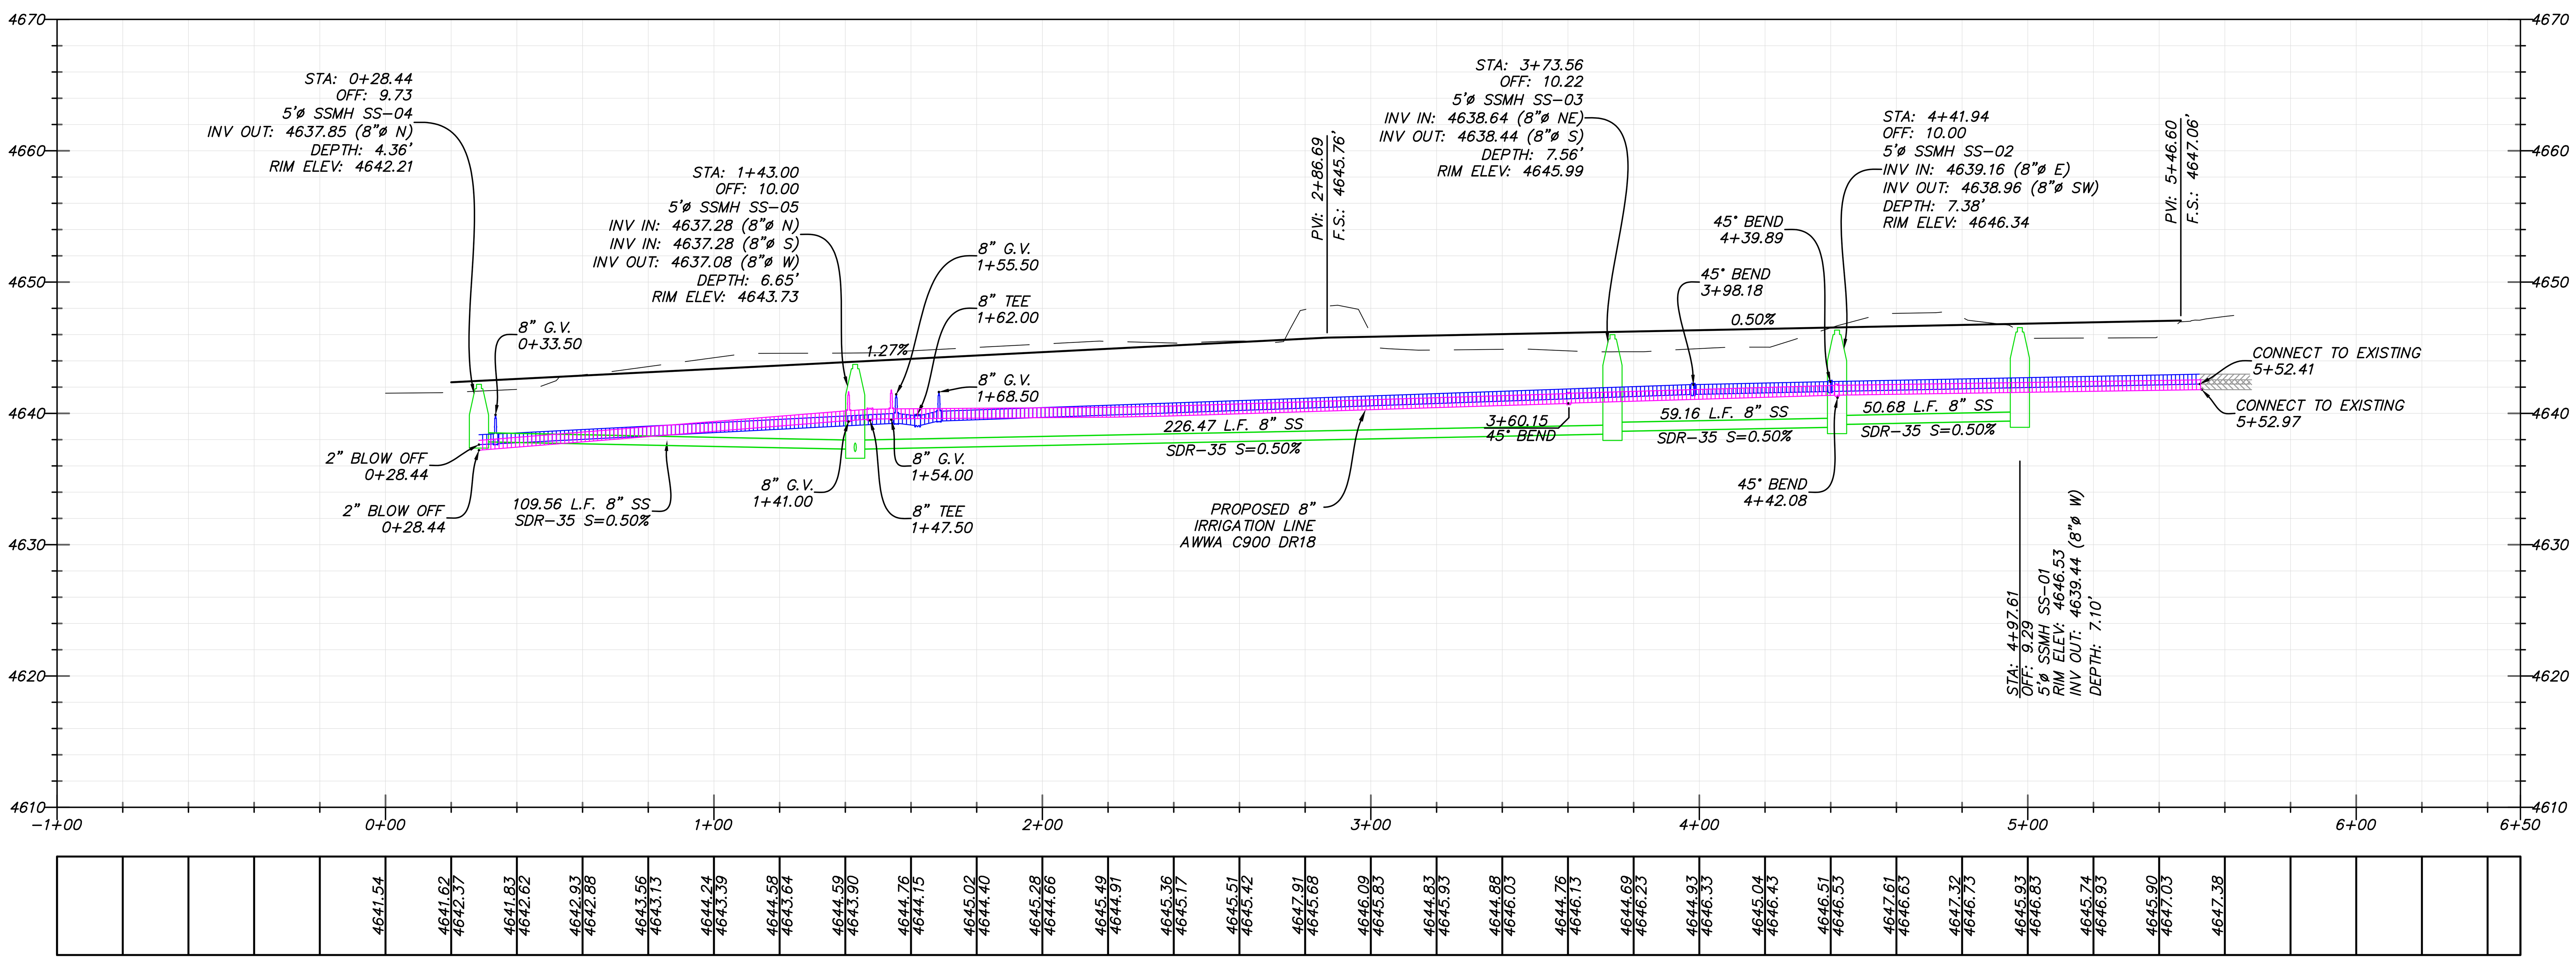

PROFILE LEGEND:

PROPOSED SURFACE

EXISTING SURFACE

PROFILE BAND LEGEND:

EXISTING | PROPOSED

PERIGEE CONSULTING
CIVIL • STRUCTURAL • SURVEY
9089 SOUTH 1300 WEST, SUITE 160 WEST JORDAN, UT 84088
801.628.6004 TEL 801.590.6611 FAX WWW.PERIGEECIVIL.COM

LICENSED PROFESSIONAL ENGINEER
No. 13937226
AUSTIN EARL WEAVER
13 NOV 2024
STATE OF UTAH

AMERICAN FORK CITY

CITY ENGINEER DATE

MARK	DESCRIPTION	DATE	APPR.


DESIGNED BY: AEW
DWN BY: AEW
CKD BY: TVW
SUBMITTED BY:
DATE: 13 NOV 2024
SOLICITATION NO:
CONTRACT NO: 01041
REV:
FILE NAME: N:\01041 Holmes Gunther American Fork\Cadd\P\08 PP01
PLOTTED BY:
PLOT DATE: 11/14/2024 12:46:41 PM
SIZE: ANSI D

ELLEN'S 2 SUBDIVISION
HOLMES HOMES
PLAN & PROFILE – 950 E ST

SHEET NUMBER 10 OF 20 SHEETS


DRAWING NAME PP03


11/14/2024 12:46:41 PM

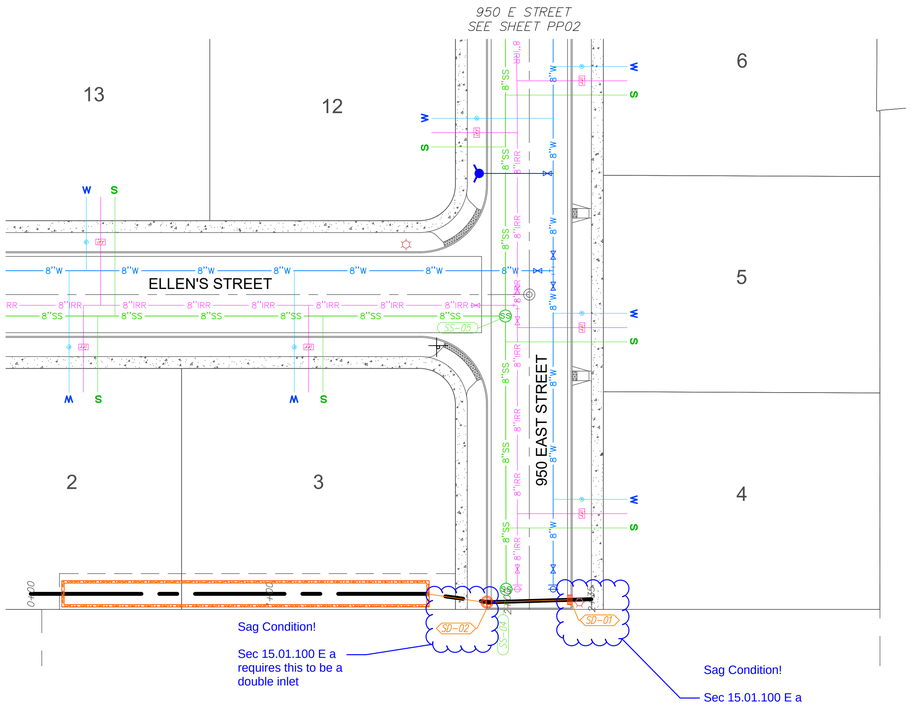

STORM DRAIN GALLERY

STA: −1+00 TO 4+00

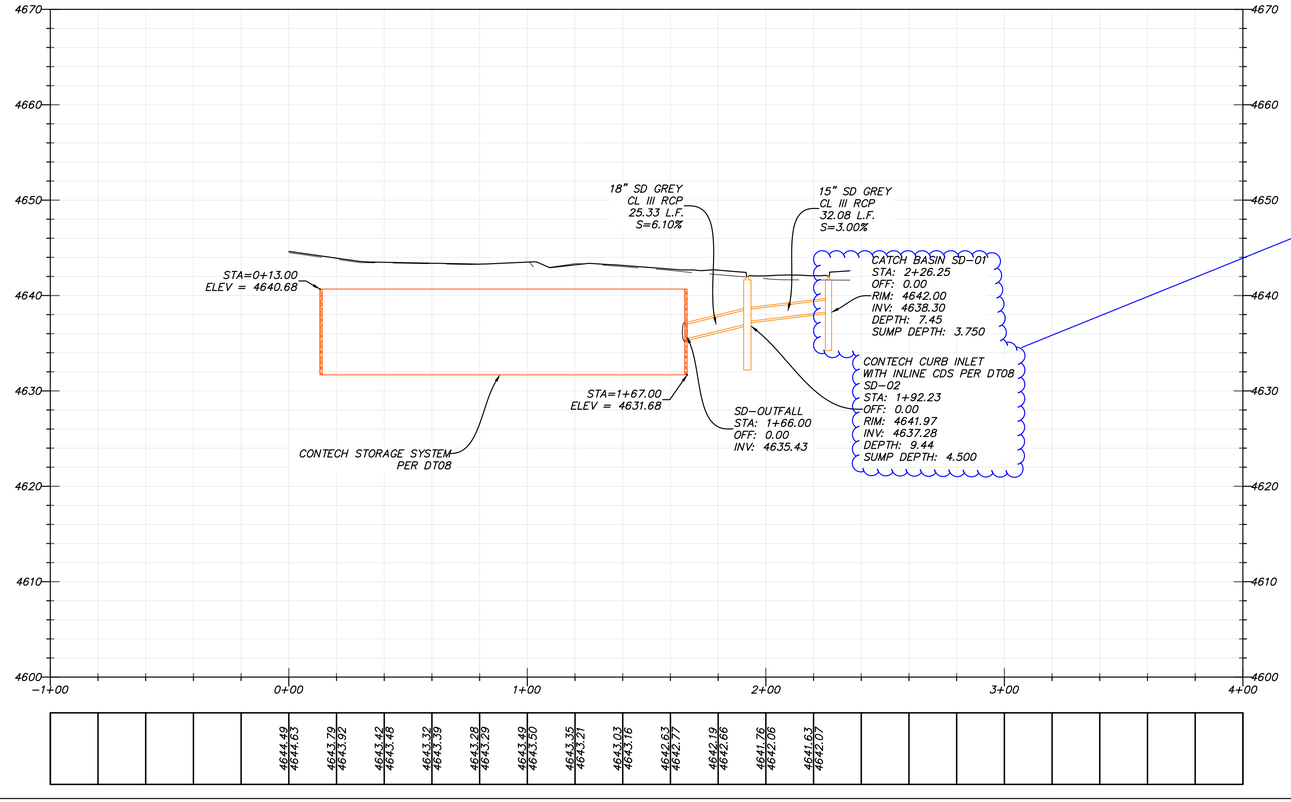

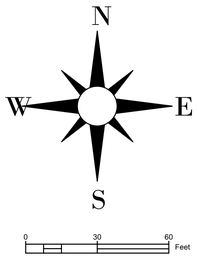



KEY MAP

PROFILE LEGEND:

PROPOSED SURFACE

EXISTING SURFACE

PROFILE BAND LEGEND:

EXISTING / PROPOSED

PERIGEE CONSULTING
CIVIL • STRUCTURAL • SURVEY
8089 SOUTH 1300 WEST, SUITE 160
801.628.6004 TEL 801.566.0911 FAX
WEST JORDAN, UT 84088
WWW.PERIGEECIVIL.COM

LICENSED PROFESSIONAL ENGINEER
No. 13937226
AUSTIN EARL WEAVER
15 NOV 2024
STATE OF UTAH

AMERICAN FORK CITY

CITY ENGINEER DATE

MARK	DESCRIPTION	DATE	APPR.

DESIGNED BY: AEW
DRAWN BY: AEW
CKED BY: TVW
SUBMITTED BY:
PLOTTED BY:
DATE: 13 NOV 2024
SOLICITATION NO:
CONTRACT NO: 01041
FILE NAME: N:\01041 Holmes Gunther American Fork\Cads\SP\08 PP01
SIZE: ANSI D
PLOT DATE: 11/14/2024 12:46:44 PM
REV:

ELLEN'S 2 SUBDIVISION
HOLMES HOMES
PLAN & PROFILE – STORM DRAIN GALLERY

SHEET NUMBER 11
OF 20 SHEETS
DRAWING NAME PP04

Blue Stakes of UTAH 811 bluestakes.org

11/14/2024 12:46:44 PM

N
W E
S
0 30 60 Feet

490 NORTH STREET

900 EAST STREET

950 EAST STREET

ELLEN'S STREET

9
14,091 S.F.
0.32 acres

8
9,020 S.F.
0.21 acres

10
23,408 S.F.
0.54 acres

11
14,166 S.F.
0.32 acres

15
12,984 S.F.
0.30 acres

7
10,519 S.F.
0.24 acres

6
10,448 S.F.
0.24 acres

5
10,527 S.F.
0.24 acres

4
4,558 S.F.
0.24 acres

1
9,306 S.F.
0.21 acres

2
9,309 S.F.
0.21 acres

3
11,243 S.F.
0.26 acres

14
9,112 S.F.
0.21 acres

13
9,674 S.F.
0.22 acres

12
9,236 S.F.
0.21 acres

SILT FENCE PER DETAIL SF ON SHEE DT07

LIMITS OF DISTURBANCE

PORTABLE TOILET LOCATION SEE DETAIL PT ON SHEET DT07

STAGING AREA

CONCRETE WASHOUT AREA SEE DETAIL CWM ON SHEET DT07

WASTE DISPOSAL AREA PER DETAIL WD ON SHEET DT07

SWPPP SIGN WITH DIGITAL ACCESS TO SWPPP PLAN

STABILIZED CONSTRUCTION ENTRANCE PER DETAIL SCE ON SHEET DT07

25.00'

50.00'

Originally designed system will need a way to maintenance.

SD-02

SD-01

Sag Condition!

Sec 15.01.100 E a requires this to be a double inlet

INSTALL INLET PROTECTION AROUND STORM DRAIN INLETS PER DETAIL IPS ON SHEET DT07 (TYPICAL)

Sag Condition!

Sec 15.01.100 E a requires this to be a double inlet

Blue Stakes of UTAH 811 Bluestakes.org

PERIGEE CONSULTING
CIVIL · STRUCTURAL · SURVEY
WEST JORDAN, UT 84088
WWW.PERIGEECIVIL.COM
8089 SOUTH 1300 WEST, SUITE 160
801.628.6004 TEL 801.596.0911 FAX

LICENSED PROFESSIONAL ENGINEER
No. 13937226
AUSTIN EARL WEAVER
15 NOV 2024
STATE OF UTAH

AMERICAN FORK CITY

CITY ENGINEER DATE


MARK	DESCRIPTION	DATE	APPR.

DESIGNED BY:	AEW
DWN BY:	AEW
CKD BY:	TYW
SUBMITTED BY:	
FILE NAME:	N:\01041 Holmes Gunther American Fork\Cadd\VP\12 EC01
SIZE:	ANSI D
PLOTTED BY:	
PLOT DATE:	11/14/2024 12:46:57 PM
DATE:	13 NOV 2024
SOLICITATION NO:	
CONTRACT NO:	01041
REV:	


ELLEN'S 2 SUBDIVISION
HOLMES HOMES
EROSION CONTROL PLAN

SHEET NUMBER
12
OF 20 SHEETS
DRAWING NAME
EC01


11/14/2024 12:46:57 PM

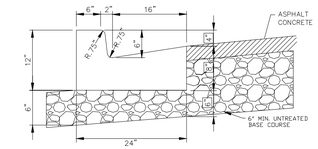

TYPE F CURB & GUTTER
-NTS-

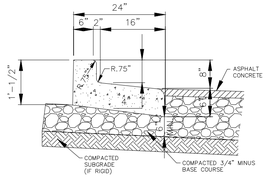


REVERSE LIP CURB & GUTTER "PRIVATE USE ONLY"
-NTS-

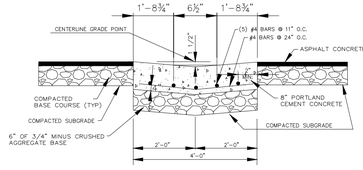


4.0' VALLEY GUTTER
-NTS-

DRAWN: JRP REVISED: DATE: MAY 2002 SCALE: VARIES	Northern ENGINEERING-LAND PLANNING -CONSTRUCTION MANAGEMENT 1040 E. 800 N. OREM, UTAH 84057 (801) 802-8992	AMERICAN FORK CITY	STANDARD DETAIL FOR: TYPE B1 C&G REVERSE LIP C&G VALLEY GUTTER	DRAWING NO. 15.1


K:\AMERICAN FORK STANDARDS\Drawings\FINAL\C&G - VALLEY GUTTER.dwg 05/22/2005 10:48:56 AM MDT

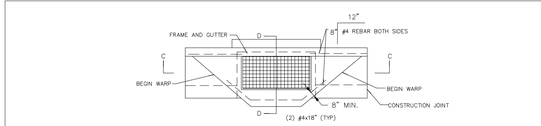


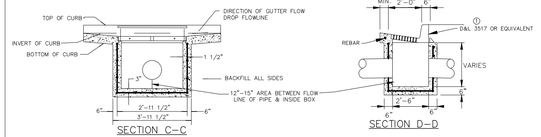

STORM DRAIN CATCH BASIN
-NTS-


NOTE:
A POLUTION PREVENTION DECAL REQUIRED ON ALL STORM DRAIN CATCH BASINS AND PRE-TREATMENT CURB INLETS.

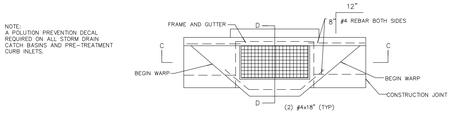

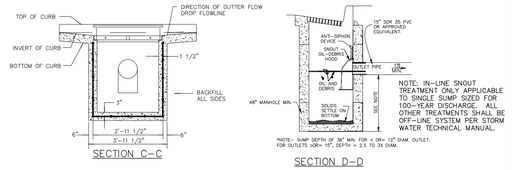

PRE-TREATMENT CURB INLET WITH SINGLE GRATE
-NTS-


DRAWN: JRP REVISED: AJS DATE: APRIL 2012 SCALE: VARIES	AMERICAN FORK CITY	STANDARD DETAIL FOR: CATCH BASIN	DRAWING NO. 15.2

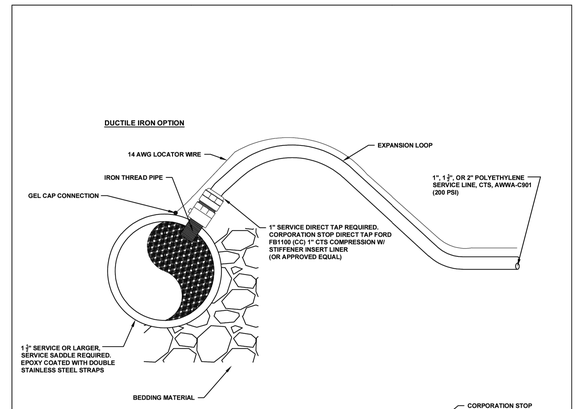

NOTES

1. 1", 1½", OR 2" CTS POLYETHYLENE 200 PSI PIPE BLUE COLOR FOR CULINARY.
2. STAINLESS STEEL INSERT STIFFENERS ARE REQUIRED ON ALL POLYETHYLENE CONNECTIONS.
3. TEFLON TAPE OR APPROVED EQUAL IS REQUIRED ON ALL THREADED CONNECTIONS.
4. WATER SERVICE TAP OR SADDLE SHALL BE INSTALLED AT 45 DEGREES IN RELATION TO THE CENTERLINE OF THE PIPE.


DRAWN: ASG REVISED: ASG DATE: JULY 2023 SCALE: NTS	AMERICAN FORK CITY PUBLIC WORKS 275 EAST 200 NORTH (801) 763-3060	STANDARD DETAIL FOR: CULINARY WATER SERVICE TAP	DRAWING NO. CW 15.3

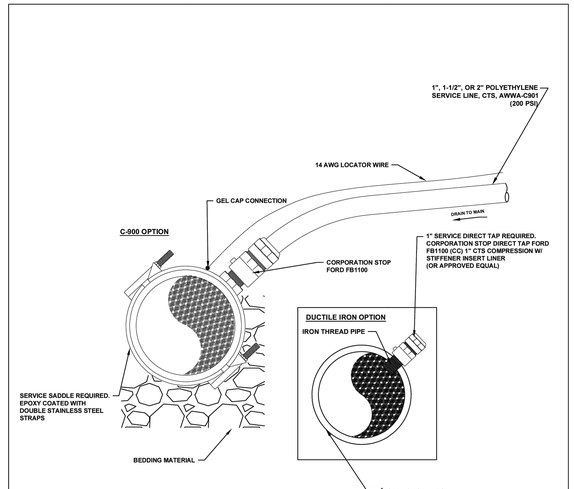

NOTES

1. 1", 1½", OR 2" CTS POLYETHYLENE 200 PSI PIPE PURPLE COLOR FOR PRESSURIZED IRRIGATION
2. STAINLESS STEEL INSERT STIFFENERS ARE REQUIRED ON ALL POLYETHYLENE CONNECTIONS.
3. TEFLON TAPE OR APPROVED EQUAL IS REQUIRED ON ALL THREADED CONNECTIONS.
4. PI LATERAL SHALL BE SLOPED TO DRAIN TOWARD MAIN.
5. SHALL BE INSTALLED AT 45 DEGREES IN RELATION TO THE CENTERLINE OF THE PIPE.


DRAWN: ASG REVISED: ASG DATE: JULY 2023 SCALE: NTS	AMERICAN FORK CITY PUBLIC WORKS 275 EAST 200 NORTH (801) 763-3060	STANDARD DETAIL FOR: PRESSURIZED IRRIGATION SERVICE TAP	DRAWING NO. PI 15.3

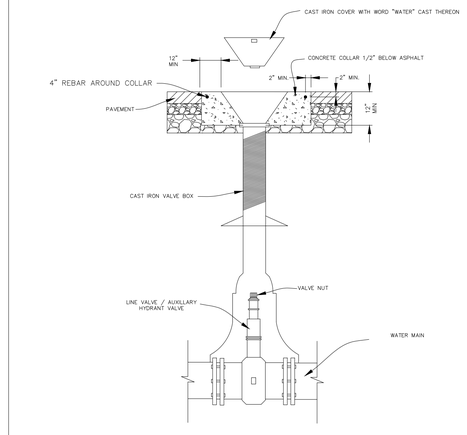

VALVE BOX DETAIL

DRAWN: JRP REVISED: DATE: JULY 2002 SCALE: VARIES	Northern ENGINEERING-LAND PLANNING -CONSTRUCTION MANAGEMENT 1040 E. 800 N. OREM, UTAH 84057 (801) 802-8992	AMERICAN FORK CITY	STANDARD DETAIL FOR: VALVE BOX DETAIL	DRAWING NO. 15.4

K:\AMERICAN FORK STANDARDS\Drawings\FINAL\VALVE BOX.dwg 05/22/2005 11:54:09 AM MDT

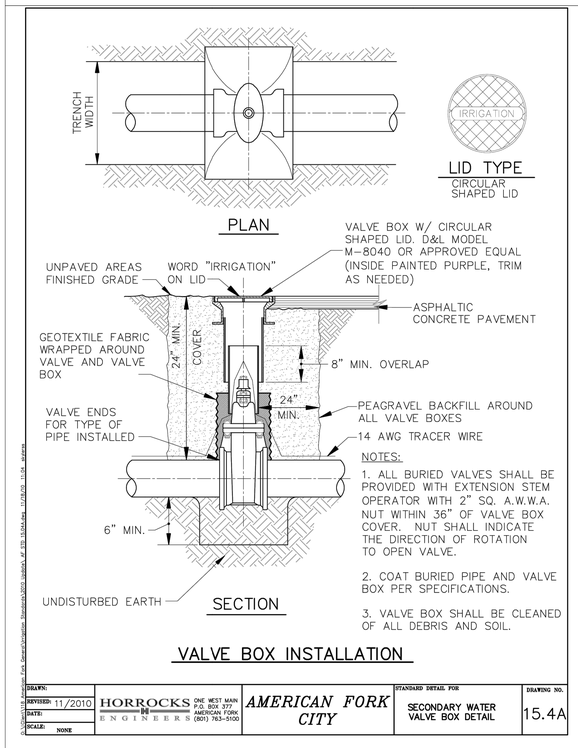

VALVE BOX INSTALLATION

DRAWN: REVISED: 11/2010 DATE: SCALE: NONE	HORROCKS ENGINEERS ONE WEST MAIN P.O. BOX 377 AMERICAN FORK (801) 763-5100	AMERICAN FORK CITY	STANDARD DETAIL FOR: SECONDARY WATER VALVE BOX DETAIL DRAWING NO. 15.4A

PERIGEE CONSULTING
CIVIL • STRUCTURAL • SURVEY
9069 SOUTH 1300 WEST, SUITE 160
WEST JORDAN, UT 84088
801.328.6004 TEL 801.566.6611 FAX
WWW.PERIGEEUT.COM

LICENSED PROFESSIONAL ENGINEER
No. 13937226
AUSTIN EARL WEAVER
15 NOV 2024
STATE OF UTAH

AMERICAN FORK CITY

CITY ENGINEER DATE

MARK	DESCRIPTION	DATE	APPR


DESIGNED BY: AEW	REV:
DWN BY: AEW	DATE: 13 NOV 2024
CHKD BY: TVW	SOLICITATION NO:
SUBMITTED BY:	CONTRACT NO: 01041
FILE NAME: N:\01041 Holmes Gunther American Fork\Cadd\PI\13 DT01	PLOT DATE: 11/14/2024 12:47:12 PM
SIZE: ANSI D	PLOTTED BY:

ELLEN'S 2 SUBDIVISION
HOLMES HOMES
AMERICAN FORK STANDARD DETAILS

SHEET NUMBER
13
OF 20 SHEETS
DRAWING NAME
DT01

Blue Stakes of UTAH 811
Bluestakes.org

11/14/2024 12:47:12 PM

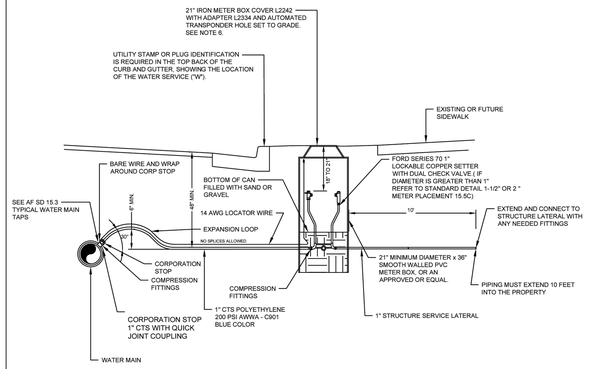



1" CULINARY WATER SERVICE CONNECTION

NOTES:

1. METER BOX, COVER, COPPERSETTER, CORPORATION STOP, & SERVICE LINES TO BE FURNISHED AND INSTALLED BY CONTRACTOR.
2. METER IS REQUIRED AND MUST BE PURCHASED BY THE PROPERTY OWNER FROM THE CITY. METER IS PROVIDED AND INSTALLED BY THE CITY.
3. STAINLESS STEEL STIFFENERS ARE REQUIRED ON ALL POLYETHYLENE CONNECTIONS.
4. CULINARY WATER LATERALS THAT ARE LAID PARALLEL TO A SEWER MUST BE LAID AT LEAST 10' (EDGE TO EDGE)FROM ANY EXISTING OR PROPOSED SEWER LATERAL. (PER UTAH CODE R309-550-7)
5. WHERE WATER AND SEWER LATERALS MUST CROSS, WATER LATERAL SHALL BE A MINIMUM OF 18" ABOVE THE SEWER LATERAL AS MEASURED EDGE TO EDGE. (PER UTAH CODE R309-550-7)
6. TEFLON TAPE OR APPROVED EQUAL IS REQUIRED ON ALL THREADED CONNECTIONS.
7. ALL METER BOX LIDS WITHIN CONCRETE SHALL BE D&L SUPPLY MODEL B-5021(LIGHT TRAFFIC) WITH A RECESSED TRANSPONDER HOLE SET TO GRADE.
8. ALL FITTINGS SHALL BE CTS.
9. SPLICING /REPAIR OF EXISTING POLY PIPE ; MECHANICAL COMPRESSION WITH INTERNAL STIFFENERS ARE REQUIRED.MUST BE APPROVED BY AMERICAN FORK CITY.
10. LATERALS SHALL BE OF ONE CONTINUOUS LENGTH OF PIPE FROM MAIN TO SETTER AND FROM SETTER TO STRUCTURE AND SHALL BE BURIED AT A MINIMUM OF 48" UNLESS APPROVED BY THE CITY ENGINEER.
11. METER CAN SHALL BE INSTALLED AT THE CENTER OF THE PARK STRIP BETWEEN FRONT OF SIDEWALK AND BACK OF CURB


DRAWN BY NLP	AMERICAN FORK	AMERICAN FORK CITY PUBLIC WORKS 275 EAST 200 NORTH (801)763-9030	1" CULINARY WATER SERVICE CONNECTION	DRAWING NO 15.5
REVISED ABM				
DATE 9/19/2019.				
SCALE VARIES				

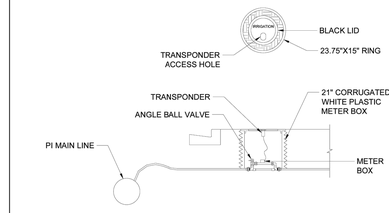

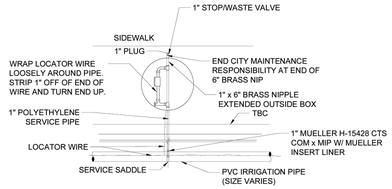

1" PLAN VIEW
NTS

DRAWN: ABW	AMERICAN FORK	AMERICAN FORK CITY PUBLIC WORKS 275 EAST 200 NORTH (801) 763-9030	PI METER DETAIL	15.5D
REVISED:				
DATE: APR 2019				
SCALE: VARIES				

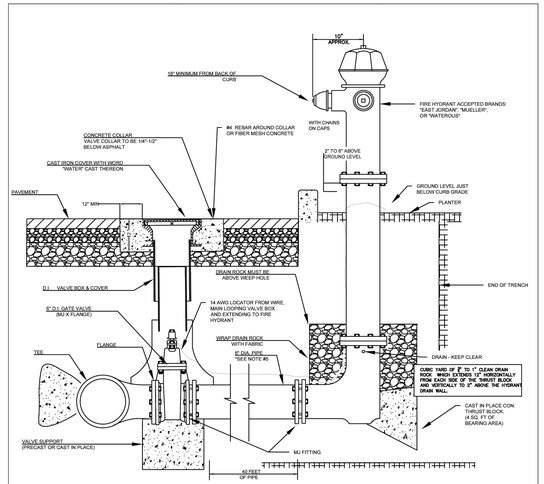


-NTS-


NOTES

1. HYDRANTS THAT ARE TO BE RELOCATED AS CALLED ON THE PLAN VIEW SHALL BE REINSTALLED IN ACCORDANCE WITH THIS DETAIL.
2. ALL GATE VALVES SHALL BE LOCATED AT THE MAIN LINE AS SHOWN ON THIS DETAIL.
3. WHERE EXISTING FITTINGS ARE NOT COMPATIBLE WITH THE NEW MAIN CONSTRUCTION, SUITABLE ADAPTERS OR NEW FITTING SHALL BE USED UPON APPROVAL BY THE AMERICAN FORK CITY ENGINEER.
4. ALL ANCHORS AND BLOCKING TO BEAR PIPE AGAINST UNDISTURBED SOIL.
5. IF LENGTH OF PIPE EXCEEDS 40 FEET, INCREASE DIAMETER TO 8 INCH MINIMUM.
6. POLYETHYLENE ENCASEMENT: ALL DI PIPE AND FITTING SHALL BE INCASED WITH POLYETHYLENE WRAP 8 MILS TO PROTECT FROM BACKFILL BUT IS NOT INTENDED TO BE AIR AND WATERTIGHT.

DRAWN BY ABM	AMERICAN FORK	AMERICAN FORK CITY PUBLIC WORKS 275 EAST 200 NORTH (801)763-3060	FIRE HYDRANT	15.6
REVISED KKS				
DATE 1/13/2021				
SCALE NTS				

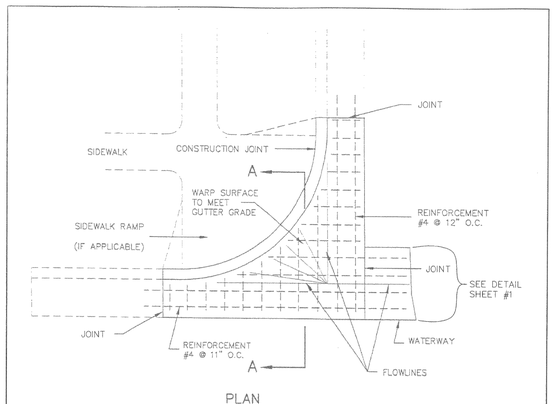


PLAN

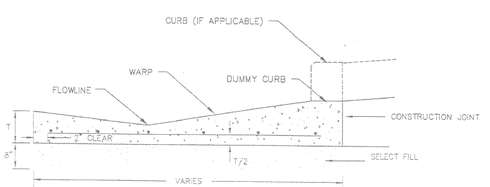

SECTION A-A

DRAWN: JRP	Northern ENGINEERING • LAND PLANNING • CONSTRUCTION MANAGEMENT 1040 E. 800 N. OREM, UTAH 84057 (801) 802-8992	AMERICAN FORK CITY	INTERSECTION RADIUS REBAR DETAIL	15.8
REVISED:				
DATE: MAY 2002				
SCALE: VARIES				

N:\AMERICAN FORK STANDARDS\Dgn-wings\FINAL\CA-SE-SAC RE.BAR.dwg 05/02/2005 10:52:02 AM MST

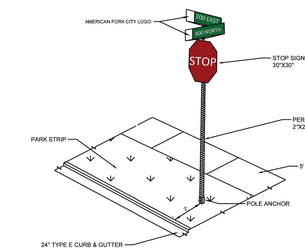


STREET COORDINATE SIGN

NOTES

1. ALL SIGN SHALL BE INSTALLED IN ACCORDANCE WITH MUTCD STANDARDS
2. COORDINATE SIGNS ARE REQUIRED AT STREET 90 DEGREE BENDS, 4-WAY AND T-INTERSECTIONS. SIGNS WITH ALPHABETICAL COORDINATES THAT ARE STREET NAMES SHALL INCLUDE A NUMERICAL COORDINATE FOR THE ROAD BELOW THE STREET NAME. SIGNS WITH CARDINAL DIRECTIONS SHALL BE SPELLED OUT. E G "NORTH"
3. POLE ANCHORS: PERFORATED SQUARE TUBE. THESE ANCHORS SHALL BE USED ON ALL CITY POLES UNLESS OTHERWISE STATED (I.E STATE SPEC SIGNS AS REQUIRED). ANCHORS SHALL BE INSTALLED WITH APPROXIMATELY 4" ANCHOR EXPOSED ABOVE THE TOP BACK OF CURB OR FINISHED GRADE. A 4" SLEEVE IS REQUIRED AROUND THE ANCHOR WHEN INSTALLED IN CONCRETE
   A. SIZE: 2 1/2"X2 1/2" X 30"
   B. THICKNESS: 12 GAUGE GALVANIZED, PERFORATED SQUARE TUBE
4. POLE: PERFORATED SQUARE TUBE UNLESS OTHERWISE STATED(I.E STATE SPEC SIGNS AS REQUIRED)
   A. SIZE: 2"X2"10' (STREET COORDINATE SIGN ONLY), 2"X2"12' (STREET COORDINATE WITH REGULATORY SIGN)
   B. THICKNESS: 12 GAUGE GALVANIZED
5. STREET COORDINATE SIGN: MUTCD CODE: D3-1. TWO SINGLE SIDED RIVETED BACK TO BACK
   A. SIZE: 8"X36"
   B. THICKNESS: 0.080 ALUMINUM
   C. REFLECTIVITY: HIGH INTENSITY TYPE 4
   D. UV PROTECTION FILM REQUIRED
   E. LOGO: PROVIDED BY THE CITY (PRIVATE LOGOS ARE NOT ALLOWED) SIGNS ARE TO HAVE THE CITY LOGO PRINTED ON THE LEFT OF THE SIGN WITH THE STREET NAME AND/OR COORDINATE FOLLOWING.
   F. FONT STYLE: HIGHWAY GOTHIC B SERIES
      (1) SIZE: STREET NAMES SHALL HAVE THE FIRST INITIAL LETTER OF THE DIRECTION/ROAD NAME UPPER CASE WITH REMAINING LETTERS LOWER CASE. SPEED LIMIT < 40 MPH: THE INITIAL UPPER-CASE LETTER SHALL BE 6" WITH THE REMAINING LOWER-CASE LETTERS AT 4.5" IN SIZE. SPEED LIMIT>40MPH: THE INITIAL UPPER-CASE LETTER SHALL BE 8" WITH THE REMAINING LOWER-CASE LETTERS 6" IN SIZE
   G. COLOR: GREEN (PUBLIC STREETS), BLUE (PRIVATE STREETS)
6. HARDWARE:
   A. 3/8" ALUMINUM DRIVE RIVET (USED TO MOUNT SIGN TO PERFORATED POLE)
   B. 5/16" MEDIUM CORNER BOLT WITH JAM NUT (USED TO SECURE POLE TO ANCHOR)
7. INSTALLATION OF SIGNS: THE LOWER STREET COORDINATE SIGN SHALL BE PARALLEL TO THE ROAD THAT IT IS IDENTIFYING AND INSTALLED ABOVE A REGULATORY SIGN IF AVAILABLE.
   A. LOCATION: STREET SIGNS SHALL BE INSTALLED ON THE SOUTH AND EAST SIDES OF AN INTERSECTION WITH A MINIMUM LATERAL OFFSET OF 2 FEET FROM THE BACK OF CURB AND ANY ADJACENT WALKWAY.
   B. HEIGHT: STREET SIGNS SHALL BE INSTALLED WITH A MINIMUM HEIGHT OF 7 FEET, MEASURED VERTICALLY FROM THE BOTTOM OF THE SIGN TO THE TOP OF GRADE/CURB

DRAWN BY NLP	AMERICAN FORK	AMERICAN FORK CITY PUBLIC WORKS 275 EAST 200 NORTH (801)763-3060	STREET COORDINATE SIGN	15.37
REVISED IKKS				
DATE 12/8/2020				
SCALE VARIES				

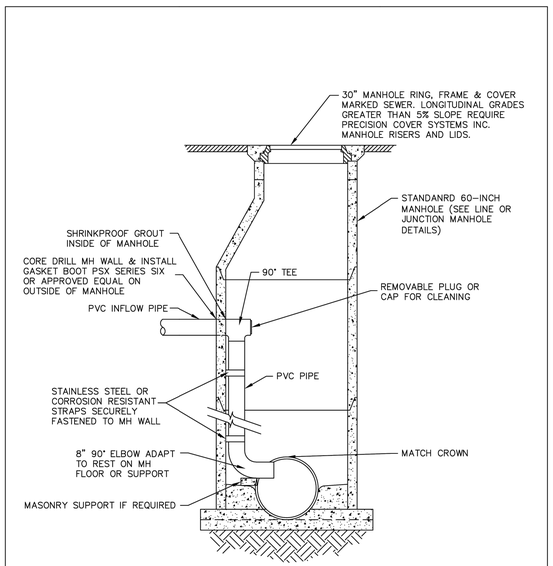

SANITARY SEWER DROP MANHOLE DETAIL

-NTS-

DRAWN: JRP	Northern ENGINEERING • LAND PLANNING • CONSTRUCTION MANAGEMENT 1040 E. 800 N. OREM, UTAH 84057 (801) 802-8992	AMERICAN FORK CITY	SANITARY SEWER DROP MANHOLE DETAIL	15.11
REVISED:				
DATE: JULY 2002				
SCALE: VARIES				

N:\AMERICAN FORK STANDARDS\Dgn-wings\FINAL\SEWER-DROP Missing 05/02/2005 10:47:05 AM MST

Blue Stakes of UTAH 811 bluestakes.org

PERIGEE CONSULTING
CIVIL • STRUCTURAL • SURVEY
9069 SOUTH 1300 WEST, SUITE 160
801.428.6004 TEL 801.566.6011 FAX
WEST JORDAN, UT 84088
WWW.PERIGEEUT.COM

LICENSED PROFESSIONAL ENGINEER
No. 13937226
AUSTIN EARL WEAVER
13 NOV 2024
STATE OF UTAH

AMERICAN FORK CITY


CITY ENGINEER DATE

MARK	DESCRIPTION	DATE	APPR

DESIGNED BY: AEW	REV:
DWN BY: AEW	DATE: 13 NOV 2024
CKD BY: TVW	SOLICITATION NO:
SUBMITTED BY:	CONTRACT NO: 01041
FILENAME: N:\01041 Holmes Gunther American Fork\Cosdt\PLN\13 DT01	PLOT DATE: 11/14/2024 12:47:15 PM
SIZE: ARCH D	PLOTTED BY:


ELLEN'S 2 SUBDIVISION
HOLMES HOMES
AMERICAN FORK STANDARD DETAILS

SHEET NUMBER 14
OF 20 SHEETS
DRAWING NAME DT02

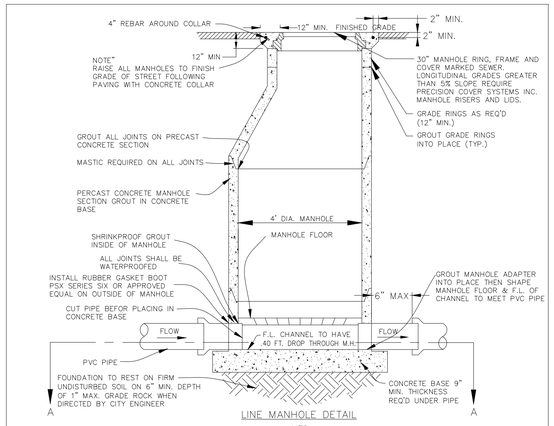

LINE MANHOLE DETAIL

-NTS-

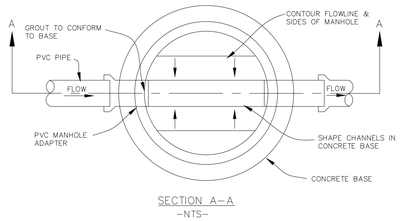


SECTION A-A

-NTS-


DRAWN: JRP	Northern ENGINEERING AND PLANNING -CONSTRUCTION MANAGEMENT 1040 E. 800 N. OREM, UTAH 84057 (801) 802-8992	AMERICAN FORK CITY	STANDARD DETAIL FOR: SANITARY SEWER LINE MANHOLE DETAIL	DRAWING NO. 15.12
REVISED:				
DATE: JULY 2002				
SCALE: VARIES				

K:\AMERICAN FORK STANDARDS\Drawings\FINAL\SEWER-LINE.dwg 05/12/2005 11:30:06 AM MST

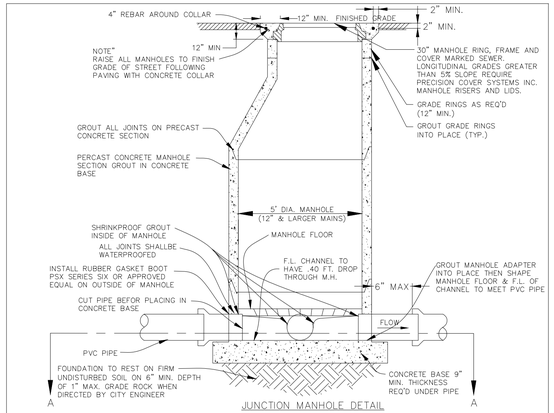

JUNCTION MANHOLE DETAIL

-NTS-

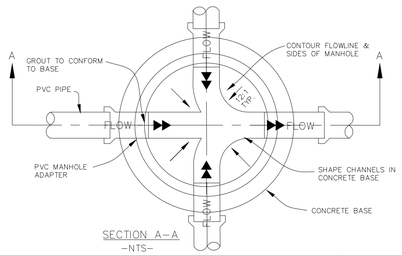

SECTION A-A


-NTS-

DRAWN: JRP	Northern ENGINEERING AND PLANNING -CONSTRUCTION MANAGEMENT 1040 E. 800 N. OREM, UTAH 84057 (801) 802-8992	AMERICAN FORK CITY	STANDARD DETAIL FOR: SANITARY SEWER JUNCTION MANHOLE DETAIL	DRAWING NO. 15.13
REVISED:				
DATE: JULY 2002				
SCALE: VARIES				

K:\AMERICAN FORK STANDARDS\Drawings\FINAL\SEWER-JUNCTION.dwg 05/12/2005 11:09:25 AM MST

NOTES:

1) MANHOLE BASE AND ALL SECTIONS SHALL BE PRECAST TO CONFORM TO ASTW C-478
2) THE SUMP SHALL BE CONCRETE.
3) THE PRETREATMENT MANHOLE SHALL BE CONSTRUCTED TO ENSURE WATER TIGHTNESS
4) THE SUMP SHALL BE LOCATED 5' OFFSET FORM MANHOLE PERPENDICULAR TO GUTTER ALIGNMENT
5) THE SUMP LID SHALL NOT BE LOCATED IN THE SIDEWALK SECTION.
6) ANY APPROVED EQUIVALENT REQUIRE CITY ENGINEER WRITTEN APPROVAL.

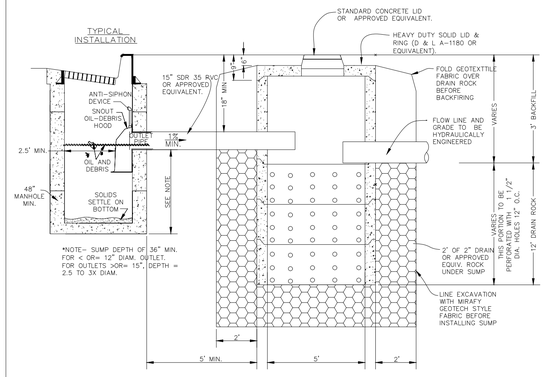


PRETREATMENT MANHOLE AND SUMP DETAIL

-NTS-

DRAWN: JRP	Northern ENGINEERING AND PLANNING -CONSTRUCTION MANAGEMENT 1040 E. 800 N. OREM, UTAH 84057 (801) 802-8992	AMERICAN FORK CITY	STANDARD DETAIL FOR: PRETREATMENT MANHOLE AND SUMP	DRAWING NO. 15.14
REVISED:				
DATE: MAY 2002				
SCALE: VARIES				


K:\AMERICAN FORK STANDARDS\Drawings\FINAL\PRE-TREATMENT SUMP.dwg 05/12/2005 09:09:24 AM MST

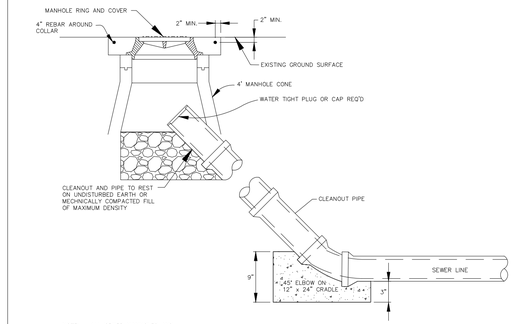


NOTE: ALL SEWER MANHOLES AND CLEANOUTS SHALL BE ACCESSIBLE BY MAINTENANCE PUMPER TRUCK.

DRAWN: JRP	Northern ENGINEERING AND PLANNING -CONSTRUCTION MANAGEMENT 1040 E. 800 N. OREM, UTAH 84057 (801) 802-8992	AMERICAN FORK CITY	STANDARD DETAIL FOR: SEWER CLEANOUT SEWER PIPE INSTALLATION	DRAWING NO. 15.15
REVISED:				
DATE: MAY 2002				
SCALE: VARIES				

K:\AMERICAN FORK STANDARDS\Drawings\FINAL\SEWER CLEANOUT.dwg 05/12/2005 11:03:56 AM MST

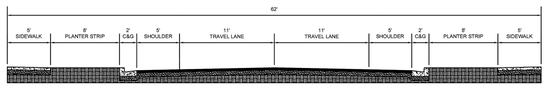

LOCAL STREET CROSS-SECTION

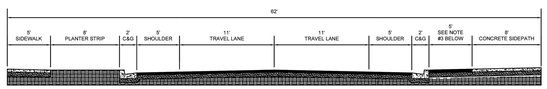


LOCAL STREET CROSS-SECTION WITH 8' CONCRETE SIDEPATH


NOTES:

1. PROVIDE COLORING AND PATTERN FOR STAMPED CONCRETE. TO DELINEATE THE PATH FROM THE STAMP CONCRETE. SUBMIT THREE SAMPLES OF COLORING AND STAMPING PATTERNS TO THE CITY ENGINEER FOR REVIEW AND APPROVAL.
2. PLANTER STRIP TO BE TURF, AND REQUESTS FOR CHANGES MUST BE APPROVED BY THE PLANNING COMMISSION
3. PLANTER STRIP OR COLORED STAMPED CONCRETE AS APPROVED BY PLANNING COMMISSION.


DRAWN: MVU	AMERICAN FORK CITY PUBLIC WORKS 275 EAST 200 NORTH (801) 763-9030		STANDARD DETAIL FOR: LOCAL STREET CROSS SECTIONS	DRAWING NO. FIG-1
REVISED:				
DATE: JULY 2019				
SCALE: VARIES				

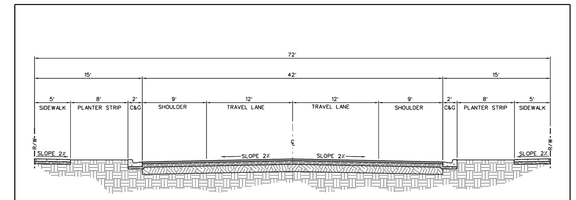

MINOR COLLECTOR CROSS-SECTION

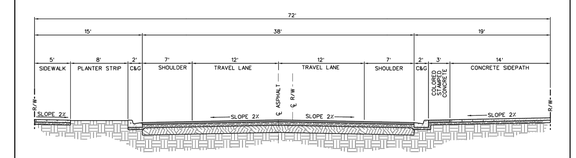

MINOR COLLECTOR CROSS-SECTION WITH 14' SIDEPATH

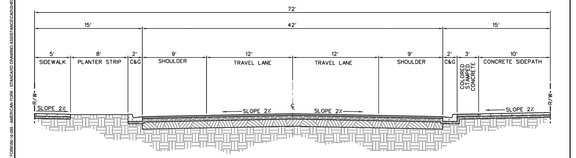

MINOR COLLECTOR CROSS-SECTION WITH 10' SIDEPATH

NOTES:

1. PROVIDE COLORING AND PATTERN FOR STAMPED CONCRETE TO DELINEATE THE PATH FROM THE STAMPED CONCRETE. SUBMIT THREE SAMPLES OF COLORING AND STAMPING PATTERNS TO CITY ENGINEER FOR REVIEW AND APPROVAL.
2. PLANTER STRIP TO BE TURF. ANY REQUESTS FOR CHANGES MUST BE APPROVED BY THE PLANNING COMMISSION.

JUB ENGINEERS, INC.

			MINOR COLLECTOR CROSS SECTIONS	SHEET FIG-2
			AMERICAN FORK CITY CORPORATION AMERICAN FORK, UTAH	

ISSUE OF DRAWINGS

THIS DOCUMENT, AND THE IDEAS AND DESIGNS INCORPORATED HEREIN AS AN INSTRUMENT OF PROFESSIONAL SERVICE, IS THE PROPERTY OF JUB ENGINEERS, Inc. AND SHALL NOT BE USED IN WHOLE OR IN PART FOR ANY OTHER PROJECT WITHOUT THE EXPRESS WRITTEN AUTHORIZATION OF JUB ENGINEERS, Inc.

NO.	REVISION DESCRIPTION	BY	DATE

FILE: 55-19.006_FIG-2.TD
JUB PROJ. # 55-19.006
DRAWN BY: SHA
DESIGN BY: JMC
CHECKED BY: MLC
LAST UPDATED: 9/14/2019

PERIGEE CONSULTING
CIVIL • STRUCTURAL • SURVEY
9069 SOUTH 1300 WEST, SUITE 160
WEST JORDAN, UT 84088
801.826.6004 TEL 801.566.6011 FAX
WWW.PERIGEEDVM.COM

LICENSED PROFESSIONAL ENGINEER
No. 13937226
AUSTIN EARL WEAVER
15 NOV 2024
STATE OF UTAH

AMERICAN FORK CITY

CITY ENGINEER DATE


MARK	DESCRIPTION	DATE	APPR

DESIGNED BY: AEW	DRAWN BY: AEW	SUBMITTED BY:	FILE NAME: N:\21041 Holmes Gunther American Fork\Cadd\PL\13_DT01	SIZE: ANSI D	PLOTTED BY:	PLOT DATE: 11/14/2024 12:47:18 PM
	CHD BY: TVW					
	DATE: 13 NOV 2024		CONTRACT NO: 01041			
		REV:	SOLICITATION NO:			

ELLEN'S 2 SUBDIVISION
HOLMES HOMES
AMERICAN FORK STANDARD DETAILS

SHEET NUMBER 15
OF 20 SHEETS
DRAWING NAME DT03


Blue Stakes of UTAH 811 Bluestakes.org

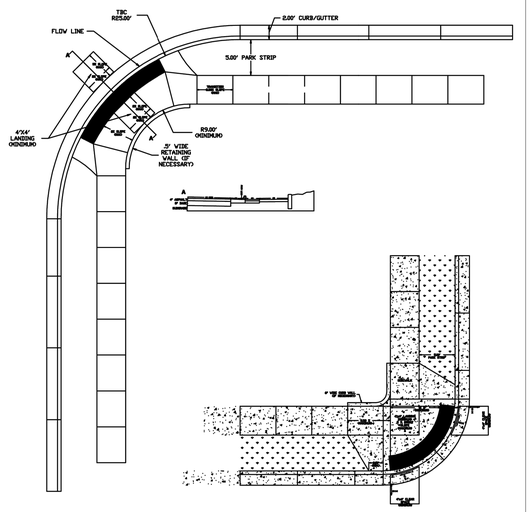

NOTES:

1. THE RAMP SHALL BE CONSTRUCTED USING CAST IRON TACTILE DOMES CAST TO MATCH THE RADIUS OF CURVE OR EQUAL AS APPROVE BY THE CITY ENGINEER.
2. PROVIDE DETECTABLE WARNING AREA PER APWA/ADAAG SPECIFICATIONS.
3. SEE APWA PLAN #235 FOR CONSTRUCTION DETAILS, SLOPES, ETC.


DRAWN: R.A.		AMERICAN FORK CITY	STANDARD DETAIL FOR: SIDEWALK RAMP	DRAWING NO. 15.18
REVISED:				
DATE: APR. 2012				
SCALE: VARIES				

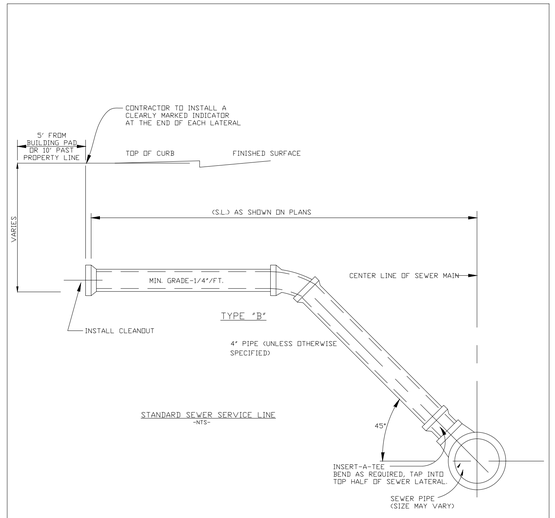

NOTE:
ALSO SEE DRAWING NO. 15.23

DRAWN: JRP	Northern ENGINEERING-LAND PLANING -CONSTRUCTION MANAGEMENT 1040 E. 800 N. OREM, UTAH 84057 (801) 802-8992	AMERICAN FORK CITY	STANDARD DETAIL FOR: STANDARD SEWER SERVICE LINE	DRAWING NO. 15.19
REVISED:				
DATE: MAY 2002				
SCALE: VARIES				


K:\AMERICAN FORK STANDARDS\Drawings\FINAL\SEWER SERVICE LINE.dwg 05/12/2005 11:06:03 AM MST

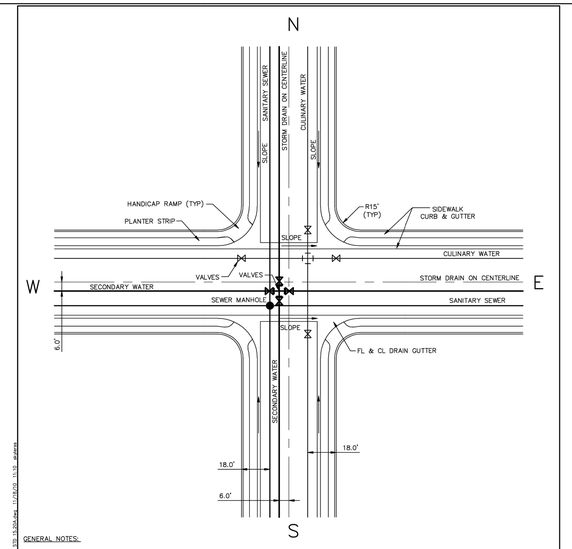

GENERAL NOTES:

1. INSTALL GATE VALVES AT EXTENSION OF PROPERTY LINES ON CULINARY WATER LINES OF THE SIZE AND TYPE IN COMPLIANCE WITH APPLICABLE AMERICAN FORK CITY SPECIFICATIONS AND DETAIL DRAWINGS.
2. INSTALL MANHOLE OF SIZE AND TYPE IN COMPLIANCE WITH APPLICABLE AMERICAN FORK SPECIFICATIONS AND DETAIL DRAWINGS.
3. DEVIATIONS FROM UTILITY LOCATION AS DETAILED HEREIN MAY ONLY BE MADE AS APPROVED BY THE AMERICAN FORK CITY PUBLIC WORKS DIRECTOR.
4. SANITARY SEWER SHOULD BE LOCATED ON THE SOUTH AND WEST.
5. CULINARY WATER SHOULD BE LOCATED ON THE NORTH AND EAST.
6. SECONDARY WATER SHOULD BE LOCATED ON THE SOUTH AND WEST.
7. INSTALL SECONDARY WATER VALVES AT THE INTERSECTION OF THE CROSS OR TEE.

DRAWN:	HORROCKS ENGINEERS ONE WEST MAIN P.O. BOX 377 AMERICAN FORK (801) 763-5100	AMERICAN FORK CITY	STANDARD DETAIL FOR: STANDARD STREET INTERSECTION AND UTILITY LOCATION	DRAWING NO. 15.20A
REVISED: 11/2010				
DATE:				
SCALE:				

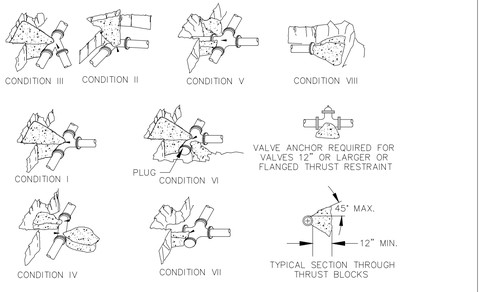

NOTES:

1. ALL THRUST BLOCK BEARING FACES SHALL BE POURED AGAINST UNDISTURBED SOIL OR APPROVED COMPACTED BACKFILL.
2. CONCRETE SHALL BE CLASS C.
3. CALCULATED ON 150 PSI. STATIC PRESSURE & ALLOWABLE BEARING PRESSURE OF 1500 LB. PER SQ. FT.
4. ALL THRUST BLOCK SIDES SHALL BE FORMED. (CITY INSPECTOR MAY REQUIRE WOOD FORMS.)


THRUST BLOCK BEARING AREA IN SQ. FEET

PIPE SIZE (IN.)	CONDITION							
	I	II	III	IV	V	VI	VII	VIII
4	1.5	1.8	1	0.5	1.3	1.3	1.3	1.3
8	5	7.1	3.8	2	5	5	5	5
10	7.8	11.1	6	3	7.8	7.8	7.8	7.8
14	15.4	21.7	11.8	6	15.4	15.4	15.4	15.4

WATER LINE THRUST BLOCK DETAILS

DRAWN: JRP	Northern ENGINEERING-LAND PLANING -CONSTRUCTION MANAGEMENT 1040 E. 800 N. OREM, UTAH 84057 (801) 802-8992	AMERICAN FORK CITY	STANDARD DETAIL FOR: WATERLINE THRUST BLOCKING	DRAWING NO. 15.21
REVISED:				
DATE: MAY 2002				
SCALE: VARIES				


K:\AMERICAN FORK STANDARDS\Drawings\FINAL\THRUST BLOCK.dwg 05/12/2005 11:04:16 AM MST

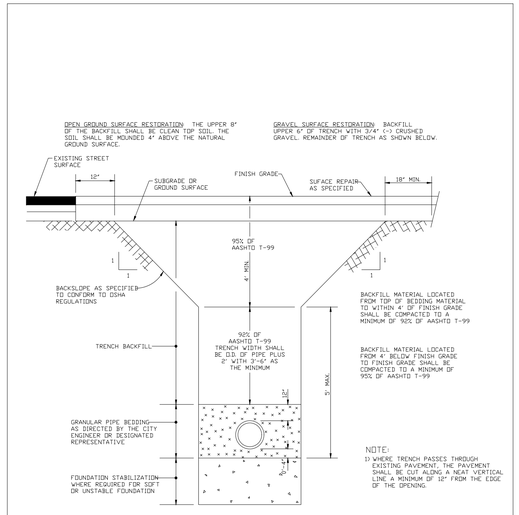

TYPICAL TRENCH DETAIL
-NTS-

DRAWN: JRP	Northern ENGINEERING-LAND PLANING -CONSTRUCTION MANAGEMENT 1040 E. 800 N. OREM, UTAH 84057 (801) 802-8992	AMERICAN FORK CITY	STANDARD DETAIL FOR: TYPICAL TRENCH DETAIL	DRAWING NO. 15.22
REVISED:				
DATE: MAY 2002				
SCALE: VARIES				

K:\AMERICAN FORK STANDARDS\Drawings\FINAL\TRENCH.dwg 05/12/2005 11:07:53 AM MST

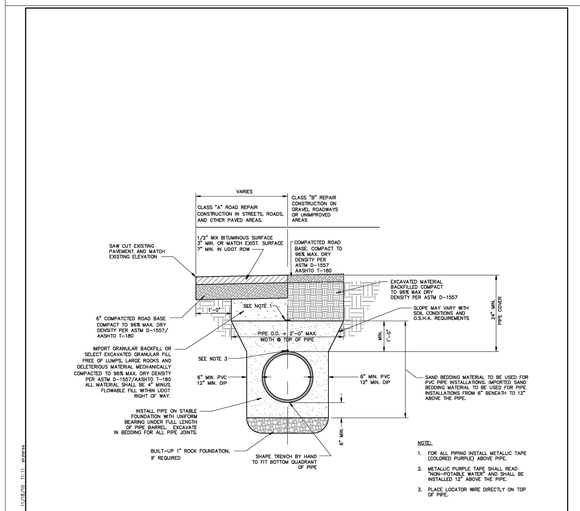

NOTE:
1. FOR ALL PIPING INSTALL METALLIC TAPE (COLORED PURPLE) ABOVE PIPE.
2. METALLIC PURPLE TAPE SHALL READ "NON-POTABLE WATER" AND SHALL BE INSTALLED 12" ABOVE THE PIPE.
3. PLACE LOCATOR WIRE DIRECTLY ON TOP OF PIPE.

TYPICAL SECONDARY WATER TRENCH DETAIL

DRAWN:	HORROCKS ENGINEERS ONE WEST MAIN P.O. BOX 377 AMERICAN FORK (801) 763-5100	AMERICAN FORK CITY	STANDARD DETAIL FOR: TYPICAL SECONDARY WATER TRENCH DETAIL	DRAWING NO. 15.22A
REVISED: 11/2010				
DATE:				
SCALE:				

PERIGEE CONSULTING
CIVIL • STRUCTURAL • SURVEY
9069 SOUTH 1300 WEST, SUITE 160
WEST JORDAN, UT 84088
801.328.8004 TEL 801.566.6611 FAX
WWW.PERIGEEUT.COM

LICENSED PROFESSIONAL ENGINEER
No. 13937226
AUSTIN EARL WEAVER
15 NOV 2024
STATE OF UTAH

AMERICAN FORK CITY

CITY ENGINEER DATE


MARK	DESCRIPTION	DATE	APPR

DESIGNED BY: AEW	DRAWN BY: AEW	CHKD BY: TVW	SUBMITTED BY:	DATE: 13 NOV 2024	SOLICITATION NO:	CONTRACT NO: 01041	FILE NAME: N:\01041 Holmes Gunther American Fork\Cadd\Plt\13 DT01	SIZE: ANSI D	PLOT DATE: 11/14/2024 12:47:22 PM	PLOTTED BY:	REV:


ELLENS 2 SUBDIVISION
HOLMES HOMES
AMERICAN FORK STANDARD DETAILS

SHEET NUMBER 16
OF 20 SHEETS
DRAWING NAME DT04

Blue Stakes of UTAH 811 Bluestakes.org

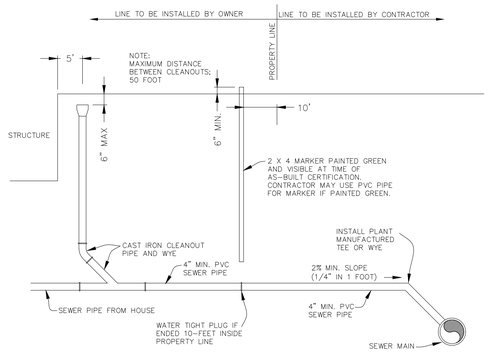

SEWER LATERAL DETAIL
-NTS-

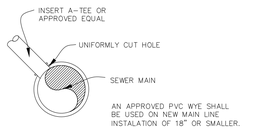


SEWER SERVICE LATERAL SADDLE
-NTS-

NOTE:
1) LATERAL SHALL NOT ENTER MANHOLE, UNLESS OTHERWISE APPROVED BY CITY ENGINEER.
2) FOR CONCRETE PIPE ADD CONCRETE COLLAR AROUND INSERT-A-TEE.
3) ALSO SEE DRAWING NO. 15.19

DRAWN: JRP	Northern ENGINEERING-LAND PLANNING -CONSTRUCTION MANAGEMENT 1040 E. 800 N. OREM, UTAH 84057 (801) 802-8992	AMERICAN FORK CITY	STANDARD DETAIL FOR: SANITARY SEWER LATERAL AND CLEAN OUT	DRAWING NO. 15.23
REVISED:				
DATE: JULY 2002				
SCALE: VARIES				

K:\AMERICAN FORK STANDARDS\Drawings\FINAL\SEWER-LATERAL.dwg 05/02/2005 11:03:30 AM MDT

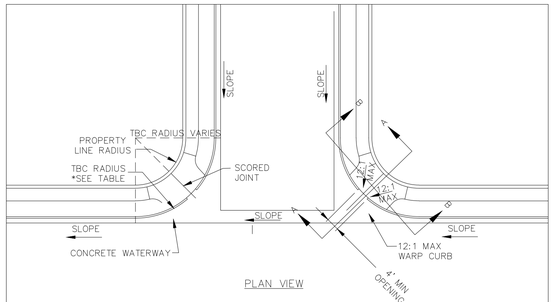


PLAN VIEW

ROADWAY CLASSIFICATION	TOP BACK CURB RADIUS (FEET)	PROPERTY LINE RADIUS (FEET)
ARTERIAL	40	30
COLLECTOR	30	20
LOCAL	25	15




SECTION A-A

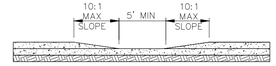

SECTION B-B

DRAWN: JRP	Northern ENGINEERING-LAND PLANNING -CONSTRUCTION MANAGEMENT 1040 E. 800 N. OREM, UTAH 84057 (801) 802-8992	AMERICAN FORK CITY	STANDARD DETAIL FOR: STANDARD STREET INTERSECTION CORNER	DRAWING NO. 15.24
REVISED:				
DATE: MAY 2002				
SCALE: VARIES				

K:\AMERICAN FORK STANDARDS\Drawings\FINAL\STR INTER-CORNER.dwg 05/02/2005 11:03:29 AM MDT

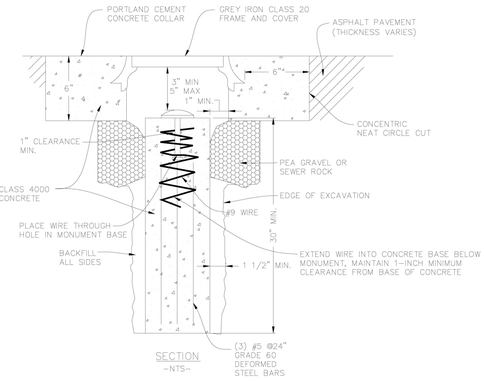


SECTION
-NTS-

NOTE: A MINIMUM OF TWO (2) SUBDIVISION MONUMENTS ARE REQUIRED ON EACH SUBDIVISION PLAT. THE LINE OF SIGHT BETWEEN EACH SUBDIVISION MONUMENT SHALL NOT BE OBSTRUCTED WITH PROPOSED BUILDINGS OR BUILDING ENVELOPES.




CAP PLAN
-NTS-

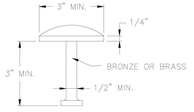

CAP SECTION
-NTS-

DRAWN: JRP	Northern ENGINEERING-LAND PLANNING -CONSTRUCTION MANAGEMENT 1040 E. 800 N. OREM, UTAH 84057 (801) 802-8992	AMERICAN FORK CITY	STANDARD DETAIL FOR: TYPE "A" MONUMENT CAP AND BASE	DRAWING NO. 15.28
REVISED:				
DATE: MAY 2002				
SCALE: VARIES				


K:\AMERICAN FORK STANDARDS\Drawings\FINAL\MONUMENT.dwg 05/02/2005 11:03:17 AM MDT

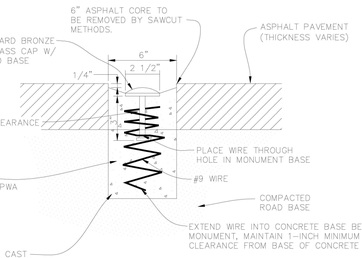

SECTION
-NTS-



CAP PLAN
-NTS-

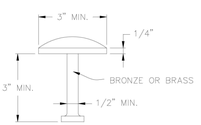


CAP SECTION
-NTS-

NOTE:
1) A MINIMUM OF TWO (2) SUBDIVISION MONUMENTS ARE REQUIRED ON EACH SUBDIVISION PLAT. THE LINE OF SIGHT BETWEEN EACH SUBDIVISION MONUMENT SHALL NOT BE OBSTRUCTED WITH PROPOSED BUILDINGS OR BUILDING ENVELOPES.

2) ALL TYPE "B" STREET MONUMENTS ARE TO BE APPROVED BY AMERICAN FORK CITY PUBLIC WORKS DEPARTMENT.

DRAWN: JRP	Northern ENGINEERING-LAND PLANNING -CONSTRUCTION MANAGEMENT 1040 E. 800 N. OREM, UTAH 84057 (801) 802-8992	AMERICAN FORK CITY	STANDARD DETAIL FOR: TYPE "B" STREET MONUMENT	DRAWING NO. 15.29
REVISED:				
DATE: MAY 2002				
SCALE: VARIES				

K:\AMERICAN FORK STANDARDS\Drawings\FINAL\MONUMENT-B.dwg 05/02/2005 11:02:03 AM MDT

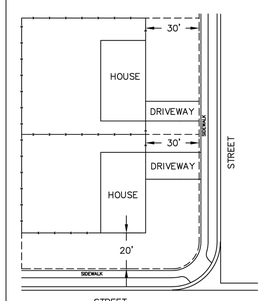

42" SOLID OR 48" OPEN (50% OR GREATER) MAXIMUM HEIGHT

6 FOOT MAXIMUM HEIGHT

American Fork City Fence Ordinance
2.5.15 Fences, Walls and Hedges

No fence, wall hedge or similar device extending into or enclosing all or any part of the front yard or side yard adjacent to a street shall be constructed or maintained at a height greater than forty-two (42) inches; provided that where the fence fabric is to be of the chain link or other open mesh type, and the fence will remain non-sight obstructing, the maximum height may be increased to not greater than forty-eight (48) inches. The maximum height of any fence, hedge, wall, or similar enclosing device situated within any other portion of a lot shall be six (6) feet.

All fences and walls shall be constructed of substantial material and the design and construction shall be consistent with the quality of dwellings and other improvements within the surrounding area. It shall be unlawful for any person to erect or cause to be erected or to maintain any barbed wire fence along or adjacent to any public street within the city.

Before commencing construction, plans for all fences and walls shall first be submitted to and approved by the Zoning Administrator. Where, in the opinion of the Administrator, a proposed fence or wall does not conform to the above criteria, he shall refer the application to the Planning Commission for action. Any applicant aggrieved by a decision may appeal said decision to the Planning Commission who shall have the authority to reverse, affirm, or modify any decision of the Administrator.

If you have any questions concerning the Fence Ordinance, please contact the Building Department at 275 East 200 North or call 763-3065.

Note: A 30" clearance must be maintained around fire hydrants.


NOTE:

THE PROPERTY LINE IS 1 FOOT INSIDE THE SIDEWALK.


DRAWN: JRP	Northern ENGINEERING-LAND PLANNING -CONSTRUCTION MANAGEMENT 1040 E. 800 N. OREM, UTAH 84057 (801) 802-8992	AMERICAN FORK CITY	STANDARD DETAIL FOR: FENCING ORDINANCE	DRAWING NO. 15.30
REVISED:				
DATE: MAY 2002				
SCALE: VARIES				

K:\AMERICAN FORK STANDARDS\Drawings\FINAL\FENCING.dwg 05/02/2005 10:54:46 AM MDT

NOTES:
1. COORDINATE W/ AMERICAN FORK CITY ON LOCATION OF IRR. BOX.
2. ALL COMPRESSION FITTINGS SHALL INCLUDE A MUELLER 2"CTS PE LINER PART NO. 506141

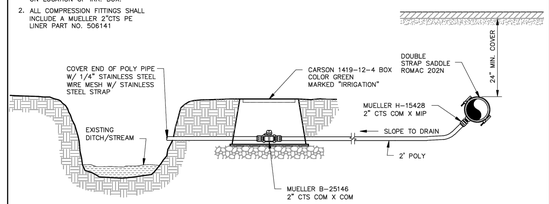

2" DRAIN TO DAYLIGHT

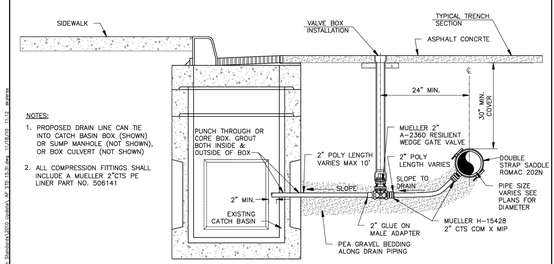

NOTES:
1. PROPOSED DRAIN LINE CAN TIE INTO CATCH BASIN BOX (SHOWN) OR SUMP MANHOLE (NOT SHOWN), OR BOX CULVERT (NOT SHOWN)
2. ALL COMPRESSION FITTINGS SHALL INCLUDE A MUELLER 2"CTS PE LINER PART NO. 506141

2" DRAIN TO CATCH BASIN/SUMP/BOX CULVERT

DRAWN:	HORROCKS ENGINEERS ONE WEST MAIN P.O. BOX 377 AMERICAN FORK (801) 763-5100	AMERICAN FORK CITY	STANDARD DETAIL FOR: SECONDARY WATER DETAILS	DRAWING NO. 15.31
REVISED: 11/2010				
DATE:				
SCALE:				

K:\AMERICAN FORK STANDARDS\Drawings\FINAL\SECONDARY.dwg 11/15/2010 11:11:16 AM MST

PERIGEE CONSULTING
CIVIL • STRUCTURAL • SURVEY
9069 SOUTH 1300 WEST, SUITE 160
WEST JORDAN, UT 84088
801.628.6004 TEL 801.566.6011 FAX
WWW.PERIGEEUT.COM

LICENSED PROFESSIONAL ENGINEER
No. 13937226
AUSTIN EARL WEAVER
15 NOV 2024
STATE OF UTAH

AMERICAN FORK CITY

CITY ENGINEER DATE

MARK	DESCRIPTION	DATE	APP'D


REV:	DATE: 13 NOV 2024	SOLICITATION NO:	CONTRACT NO: 01041	FILE NAME: N:\01041 Holmes Gunther American Fork\Cadd\PV13 DT01	PLOT DATE: 11/14/2024 12:47:25 PM
DESIGNED BY: AEW	CAD BY: TVW	SUBMITTED BY:		SIZE: ANSI D	PLOTTED BY:
DRAWN BY: AEW					

ELLEN'S 2 SUBDIVISION
HOLMES HOMES
AMERICAN FORK STANDARD DETAILS


SHEET NUMBER 17
OF 20 SHEETS
DRAWING NAME DT05

Blue Stakes of UTAH 811 Bluestakes.org

11/14/2024 12:47:25 PM

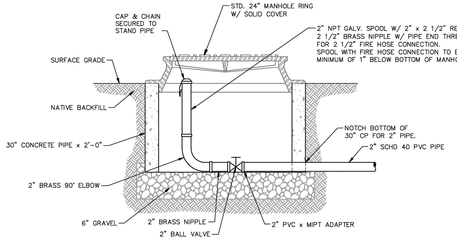

STANDARD SECTION WHERE NO STREET IMPROVEMENTS EXIST

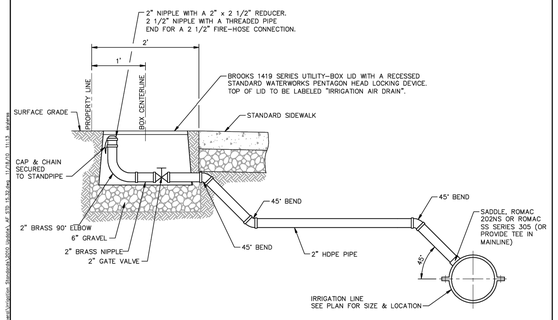


STANDARD SECTION WHERE STREET IMPROVEMENTS EXIST


DRAWN:	HORROCKS ENGINEERS ONE WEST MAIN P.O. BOX 377 AMERICAN FORK (801) 763-5100	AMERICAN FORK CITY	STANDARD DETAIL FOR: AIR INLET & REMOVAL FACILITY FOR SECONDARY WATER	DRAWING NO. 15.32
REVISED: 11/2010				
DATE:				
SCALE:				

AMERICAN FORK CITY STANDARDS

FIGURE 17.5.110-A — MINIMUM STANDARDS FOR INTERSECTION SIGHT DISTANCE

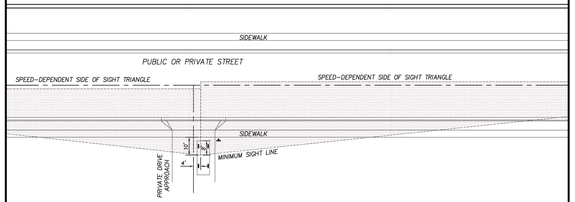

DRIVE APPROACH

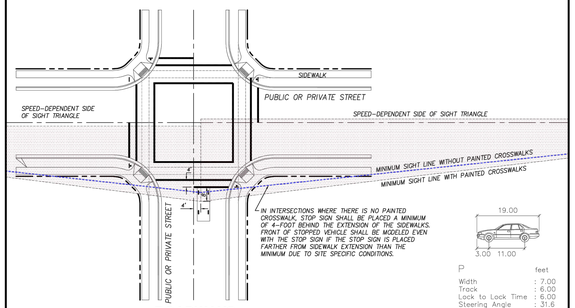

IN INTERSECTIONS WHERE THERE IS NO PAINTED CROSSWALK, STOP SIGN SHALL BE PLACED A MINIMUM OF 4-FOOT BEHIND THE EXTENSION OF THE SIDEWALKS. FRONT OF STOPPED VEHICLE SHALL BE MODELED EVEN WITH THE STOP SIGN IF THE STOP SIGN IS PLACED FARTHER FROM SIDEWALK EXTENSION THAN THE MINIMUM DUE TO SITE SPECIFIC CONDITIONS.

P	feet
Width	: 7.00
Track	: 6.00
Lock to Lock Time	: 6.00
Steering Angle	: 31.6

AASHTO PASSENGER CAR DIMENSIONS


ROADWAYS

GENERAL SHEET NOTES:
1. WAITING VEHICLE SHALL STOP OUTSIDE OF PEDESTRIAN FACILITIES AS DETAILED HEREON OR GREATER AS DETERMINED BY SPECIFIC SITE LAYOUT.
2. SEE AMERICAN FORK CITY ACCESS MANAGEMENT MANUAL AND THE LATEST VERSION OF THE AASHTO MANUAL A POLICY ON GEOMETRIC DESIGN OF HIGHWAYS AND STREETS FOR LENGTH OF SPEED-DEPENDENT SIDE OF SIGHT TRIANGLE.
3. SPEED-DEPENDENT SIDE OF SIGHT TRIANGLES SHALL BE CALCULATED BASED UPON DESIGN SPEED OF ROADWAY ALSO CONSIDERING EFFECTS OF ROADWAY GRADES FOR BOTH ROADWAYS.
4. NO OBSTRUCTION SHALL BE WITHIN THE SIGHT TRIANGLE IN THE AREA FROM 3-FOOT TO 8-FOOT (TRAFFIC SIGNS, NARROW STREET LIGHTS, NARROW TRUNK TREES WITH CANOPY ABOVE 8-FOOT EXCEPTED). OBSTRUCTIONS BELOW 3-FOOT ARE TO BE MINIMIZED.
5. DESIGNATED PARKING STALLS ARE NOT ALLOWED WITHIN SIGHT TRIANGLE AREAS.
6. DIMENSIONS SHOWN ARE MINIMUM. DESIGNER MAY OPT FOR MORE CONSERVATIVE SIGHT LINE DEFINITIONS.
7. THIS DRAWING IS ALSO AVAILABLE AS STANDARD DRAWING #15.41

FILE: T:\LD-PROJECT\AF-CITY-STANDARDS\DWG\CITY-SIGHT-TRIANGLE-AASHTO-ADOPTED.DWG
DATE: FEBRUARY 28, 2012

STD. DWG. #15.41

MINIMUM STANDARDS FOR OFF-LINE OIL/WATER/SEDIMENT SEPARATOR

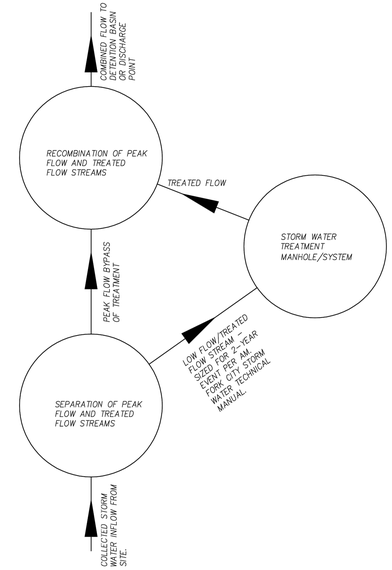


NOTES:
1. SEE AMERICAN FORK CITY STORM WATER TECHNICAL MANUAL FOR DETAILS OF DESIGN, CONSTRUCTION, AND TESTING REQUIREMENTS.
2. SPECIFIC TREATMENT SYSTEM FOR A GIVEN SITE TO BE DESIGNED BY REGISTERED PROFESSIONAL ENGINEER PERFORMING THE STORM DRAIN SYSTEM DESIGN FOR THE SITE OR APPLICATION.
3. CITY ENGINEER MAY ALLOW IN-LINE TREAMENT DEVICE IF PEAK FLOWS ARE ATTENUATED UPSTREAM AND NEVER ALLOWED TO REACH TREATMENT DEVICE.

FILE: \Q:\LD-PROJECT\AF-CITY-STANDARDS\DWG\OFF-LINE-OWS.DWG
DATE: APRIL 17, 2012

STD. DWG. #15.42


AMERICAN FORK CITY STANDARDS
UTILITY LATERAL PLACEMENT - RESIDENTIAL PARCELS

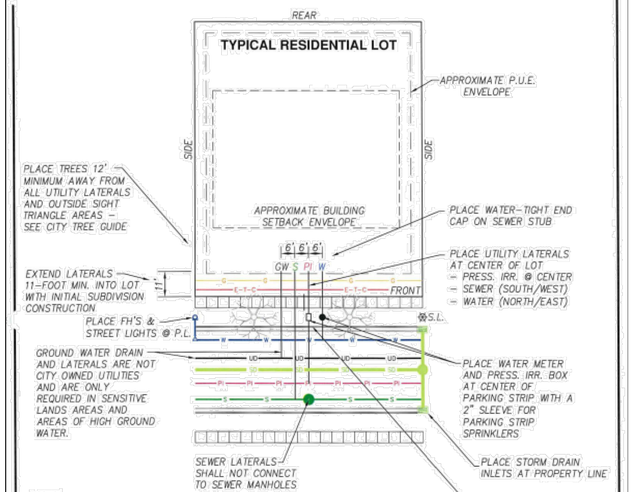

NOTES:
1. UTILITY LATERAL PLACEMENT UNDER DRIVEWAY OR UNDER DRIVEWAY APPROACH IS PROHIBITED.
2. IF HOME DRIVEWAY IS PLANNED FOR PLACEMENT OVER UTILITY LATERALS, UTILITY LATERALS SHALL BE ABANDONED AND RELOCATED PER AMERICAN FORK CITY STANDARDS. PAVEMENT REPAIRS SHALL BE COMPLETED PER AMERICAN FORK CITY PAVEMENT PRESERVATION STANDARDS.
3. WRITTEN APPROVAL FROM CITY ENGINEER OR DESIGNATED REPRESENTATIVE SHALL BE REQUIRED FOR UTILITY AND/OR LATERAL PLACEMENT DEVIATING FROM THE STANDARD PLACEMENT SHOWN.
4. DEVELOPER SHALL PLAN DRIVEWAY LOCATIONS AT TIME OF SUBDIVISION TO AVOID UTILITY LATERAL CONFLICTS WITH DRIVEWAYS. CUL-DE-SAC DRIVEWAY LOCATIONS SHALL BE PLACED ON RECORDED PLAT.
5. NEW SUBDIVISION FRANCHISE UTILITIES SHALL BE PLACED IN PUBLIC UTILITY EASEMENTS.
6. ABOVE GROUND FRANCHISE UTILITIES SHALL BE IN OUTSIDE PUBLIC ROADWAY RIGHTS-OF-WAY AND PLACED WITHIN P.U.E. AND OUTSIDE SIGHT TRIANGLE AREA.

FILE: \N: \CAD-DESIGN-FILES\AF-CITY-STANDARDS\DWG\UTILITY-LATERAL-PLACEMENT.DWG
DATE: MARCH 12, 2015

STD. DWG. #15.43

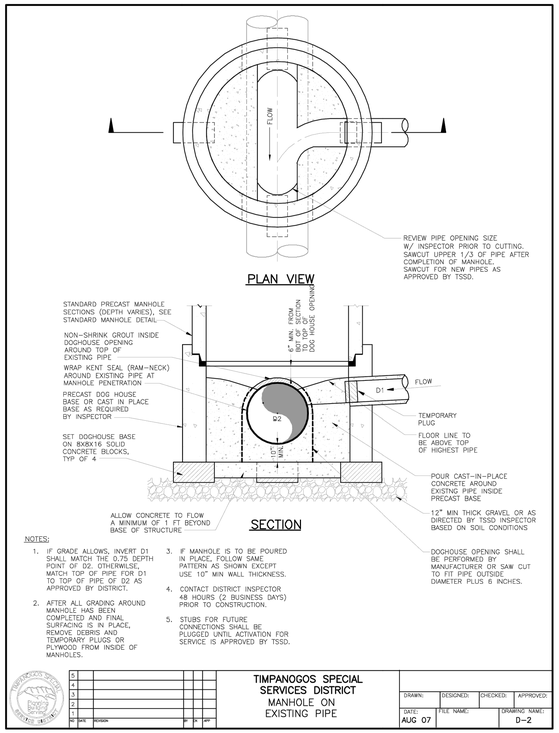


NOTES:
1. IF GRADE ALLOWS, INVERT D1 SHALL MATCH THE 0.75 DEPTH POINT OF D2. OTHERWISE, MATCH TOP OF PIPE FOR D1 TO TOP OF PIPE OF D2 AS APPROVED BY DISTRICT.
2. AFTER ALL GRADING AROUND MANHOLE HAS BEEN COMPLETED AND FINAL SURFACING IS IN PLACE, REMOVE DEBRIS AND TEMPORARY PLUGS OR PLYWOOD FROM INSIDE OF MANHOLES.
3. IF MANHOLE IS TO BE POURED IN PLACE, FOLLOW SAME PATTERN AS SHOWN EXCEPT USE 10" MIN WALL THICKNESS.
4. CONTACT DISTRICT INSPECTOR 48 HOURS (2 BUSINESS DAYS) PRIOR TO CONSTRUCTION.
5. STUBS FOR FUTURE CONNECTIONS SHALL BE PLUGGED UNTIL ACTIVATION FOR SERVICE IS APPROVED BY TSSD.

NO.	DATE	REVISION	BY	APP
5				
4				
3				
2				
1				

TIMPANOGOS SPECIAL SERVICES DISTRICT
MANHOLE ON EXISTING PIPE

DRAWN:	DESIGNED:	CHECKED:	APPROVED:
DATE: AUG 07	FILE NAME:	DRAWING NAME: D-2	

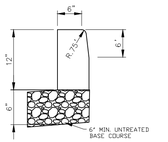

A VAR — CURBWALL DETAIL
SCALE: N.T.S.

PERIGEE CONSULTING
CIVIL • STRUCTURAL • SURVEY
9069 SOUTH 1300 WEST, SUITE 160
801.628.6004 TEL 801.566.6011 FAX
WEST JORDAN, UT 84088
WWW.PERIGEEUT.COM

LICENSED PROFESSIONAL ENGINEER
No. 13937226
AUSTIN EARL WEAVER
19 NOV 2024
STATE OF UTAH

AMERICAN FORK CITY

CITY ENGINEER DATE

NO.	DESCRIPTION	DATE	APP'D

DESIGNED BY:	AEW
DWN BY:	AEW
CKD BY:	TVW
SUBMITTED BY:	
DATE:	13 NOV 2024
SOLICITATION NO:	
CONTRACT NO:	01041
FILENAME:	N:\01041 Holmes Gunther American Fork\Cadd\PW\13 DT01
SIZE:	
PLOTTED BY:	
PLOT DATE:	11/14/2024 12:47:28 PM


ELLEN'S 2 SUBDIVISION
HOLMES HOMES
AMERICAN FORK STANDARD DETAILS

SHEET NUMBER 18
OF 20 SHEETS
DRAWING NAME DT06

Blue Stakes of UTAH 811 bluestakes.org

11/14/2024 12:47:28 PM

BMP: Concrete Waste Management — CWM

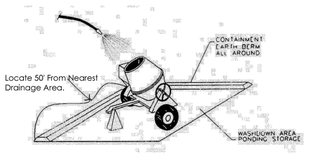

DESCRIPTION:
Prevent or reduce the discharge of pollutants to storm water from concrete waste by conducting washout off-site, performing on-site washout in a designated area, and training employees and using qualified subcontractors.

APPLICATIONS:
This technique is applicable to all types of sites.

INSTALLATION/APPLICATION CRITERIA:
- Store dry and wet materials under cover, away from drainage areas.
- Avoid mixing excess amounts of fresh concrete or cement on-site.
- Perform washout of concrete trucks off-site or in designated areas only.
- Do not wash out concrete trucks into storm drains, open ditches, streets, or streams.
- Do not allow excess concrete to be dumped on-site, except in designated areas.
- When washing concrete to remove fine particles and expose the aggregate, avoid creating runoff by draining the water within a bermed or level area. (See Earth Berm Barrier information sheet.)
- Train employees and subcontractors in proper concrete waste management.

LIMITATIONS:
- Off-site washout of concrete wastes may not always be possible.

MAINTENANCE:
- Inspect subcontractors to ensure that concrete wastes are being properly managed.
- If using a temporary pit or other on-site container, dispose hardened concrete on a regular basis.

OBJECTIVES
- ☐ Housekeeping Practices
- ☒ Contain Waste
- ☐ Minimize Disturbed Areas
- ☐ Stabilize Disturbed Areas
- ☐ Protect Slopes/Channels
- ☐ Control Site Perimeter
- ☐ Control Internal Erosion

ADAPTED FROM SALT LAKE COUNTY BMP FACTSHEET


TARGETED POLLUTANTS
- ☐ Sediment
- ☐ Nutrients
- ☐ Toxic Materials
- ☐ Oil & Grease
- ☐ Floatable Materials
- ☒ Other Waste

- ■ High Impact
- ☒ Medium Impact
- ☐ Low or Unknown Impact

IMPLEMENTATION REQUIREMENTS
- ☐ Capital Costs
- ☐ O&M Costs
- ☒ Maintenance
- ☒ Training

■ High ☒ Medium ☐ Low

BMP: Inlet Protection - Silt Fence or Straw Bale — IPS

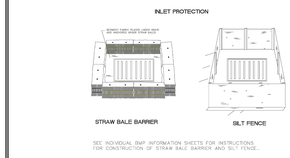

DESCRIPTION:
Sediment barrier erected around storm drain inlet.

APPLICATION:
Construct at storm drainage inlets located downgradient of areas to be disturbed by construction (for inlets in paved areas see other information sheets for inlet protection).

INSTALLATION/APPLICATION CRITERIA:
- Provide upgradient sediment controls, such as silt fence during construction of inlet.
- When construction of inlet is complete, erect straw bale barrier or silt fence surrounding perimeter of inlet. Follow instructions and guidelines on individual BMP information sheets for straw bale barrier and silt fence construction.

LIMITATIONS:
- Recommended maximum contributing drainage area of one acre.
- Limited to inlets located in open unpaved areas.
- Requires shallow slopes adjacent to inlet.

MAINTENANCE:
- Inspect inlet protection following storm event and at a minimum of once monthly.
- Remove accumulated sediment when it reaches 4-inches in depth.
- Repair or realign barrier/fence as needed.
- Look for bypassing or undercutting and recompact soil around barrier/fence as required.

OBJECTIVES
- ☐ Housekeeping Practices
- ☐ Contain Waste
- ☐ Minimize Disturbed Areas
- ☐ Stabilize Disturbed Areas
- ☐ Protect Slopes/Channels
- ☒ Control Site Perimeter
- ☒ Control Internal Erosion

ADAPTED FROM SALT LAKE COUNTY BMP FACTSHEET


TARGETED POLLUTANTS
- ▪ Sediment
- ☐ Nutrients
- ☐ Toxic Materials
- ☐ Oil & Grease
- ▪ Floatable Materials
- ☐ Other Waste

- ■ High Impact
- ☒ Medium Impact
- ☐ Low or Unknown Impact

MPLEMENTATION REQUIREMENTS
- ▪ Capital Costs
- ☐ O&M Costs
- ▪ Maintenance
- ☐ Training

■ High ☒ Medium ☐ Low

BMP: Portable Toilets — PT

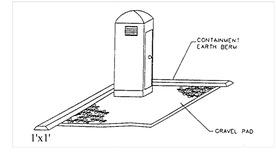

DESCRIPTION:
Temporary on-site sanitary facilities for construction personnel.

APPLICATION:
All sites with no permanent sanitary facilities or where permanent facility is too far from activities.

INSTALLATION/APPLICATION CRITERIA:
- Locate portable toilets in convenient locations throughout the site.
- Prepare level, gravel surface and provide clear access to the toilets for servicing and for on-site personnel.
- Construct earth berm perimeter (See Earth Berm Barrier Information Sheet), control for spill/protection leak.

LIMITATIONS:
No limitations.

MAINTENANCE:
- Portable toilets should be maintained in good working order by licensed service with daily observation for leak detection.
- Regular waste collection should be arranged with licensed service.
- All waste should be deposited in sanitary sewer system for treatment with appropriate agency approval.

OBJECTIVES
- ☒ Housekeeping Practices
- ☒ Contain Waste
- ☐ Minimize Disturbed Areas
- ☐ Stabilize Disturbed Areas
- ☐ Protect Slopes/Channels
- ☐ Control Site Perimeter
- ☐ Control Internal Erosion

ADAPTED FROM SALT LAKE COUNTY BMP FACTSHEET


TARGETED POLLUTANTS
- ▫ Sediment
- ▫ Nutrients
- ▫ Toxic Materials
- ▫ Oil & Grease
- ▫ Floatable Materials
- ▪ Other Waste

- ■ High Impact
- ☒ Medium Impact
- ☐ Low or Unknown Impact

IMPLEMENTATION REQUIREMENTS
- ▪ Capital Costs
- ▪ O&M Costs
- ▪ Maintenance
- ▫ Training

■ High ☒ Medium ☐ Low

BMP: Silt Fence — SF

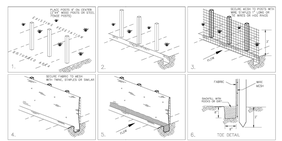

DESCRIPTION:
A temporary sediment barrier consisting of entrenched filter fabric stretched across and secured to supporting posts.

APPLICATION:
- Perimeter control: place barrier at downgradient limits of disturbance
- Sediment barrier: place barrier at toe of slope or soil stockpile
- Protection of existing waterways: place barrier near top of stream bank
- Inlet protection: place fence surrounding catchbasins

INSTALLATION/APPLICATION CRITERIA:
- Place posts 6 feet apart on center along contour (or use preassembled unit) and drive 2 feet minimum into ground. Excavate an anchor trench immediately upgradient of posts.
- Secure wire mesh (14 gage min. With 6 inch openings) to upslope side of posts. Attach with heavy duty 1 inch long wire staples, tie wires or hog rings.
- Cut fabric to required width, unroll along length of barrier and drape over barrier. Secure fabric to mesh with twine, staples, or similar, with trailing edge extending into anchor trench.
- Backfill trench over filter fabric to anchor.

LIMITATIONS:
- Recommended maximum drainage area of 0.5 acre per 100 feet of fence
- Recommended maximum upgradient slope length of 150 feet
- Recommended maximum uphill grade of 2:1 (50%)
- Recommended maximum flow rate of 0.5 cfs
- Ponding should not be allowed behind fence

MAINTENANCE:
- Inspect immediately after any rainfall and at least daily during prolonged rainfall.
- Look for runoff bypassing ends of barriers or undercutting barriers.
- Repair or replace damaged areas of the barrier and remove accumulated sediment.
- Reanchor fence as necessary to prevent shortcutting.
- Remove accumulated sediment when it reaches ½ the height of the fence.

OBJECTIVES
- ☐ Housekeeping Practices
- ☐ Contain Waste
- ☐ Minimize Disturbed Areas
- ☐ Stabilize Disturbed Areas
- ☒ Protect Slopes/Channels
- ☒ Control Site Perimeter
- ☒ Control Internal Erosion

ADAPTED FROM SALT LAKE COUNTY BMP FACTSHEET


TARGETED POLLUTANTS
- ▪ Sediment
- ☐ Nutrients
- ☐ Toxic Materials
- ☐ Oil & Grease
- ☐ Floatable Materials
- ☐ Other Waste

- ■ High Impact
- ☒ Medium Impact
- ☐ Low or Unknown Impact

IMPLEMENTATION REQUIREMENTS
- ▪ Capital Costs
- ▪ O&M Costs
- ▪ Maintenance
- ▫ Training

■ High ☒ Medium ☐ Low

BMP: Stabilized Construction Entrance — SCE

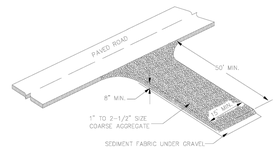

DESCRIPTION:
A stabilized pad of crushed stone located where construction traffic enters or leaves the site from or to paved surface.

APPLICATIONS:
At any point of ingress or egress at a construction site where adjacent traveled way is paved. Generally applies to sites over 2 acres unless special conditions exist.

INSTALLATION/APPLICATION CRITERIA:
- Clear and grub area and grade to provide maximum slope of 2%.
- Compact subgrade and place filter fabric if desired (recommended for entrances to remain for more than 3 months.
- Place coarse aggregate, 1 to 2-1/2 inches in size, to a minimum depth of 8 inches.

LIMITATIONS:
- Requires periodic top dressing with additional stones.
- Should be used in conjunction with street sweeping on adjacent public right-of-way.

MAINTENANCE:
- Inspect daily for loss of gravel or sediment buildup.
- Inspect adjacent roadway for sediment deposit and clean by sweeping or shoveling.
- Repair entrance and replace gravel as required to maintain control in good working condition.
- Expand stabilized area as required to accommodate traffic and prevent erosion at driveways.

OBJECTIVES
- ☒ Housekeeping Practices
- ☐ Contain Waste
- ☐ Minimize Disturbed Areas
- ☐ Stabilize Disturbed Areas
- ☐ Protect Slopes/Channels
- ☒ Control Site Perimeter
- ☐ Control Internal Erosion

ADAPTED FROM SALT LAKE COUNTY BMP FACTSHEET


TARGETED POLLUTANTS
- ■ Sediment
- ☐ Nutrients
- ☐ Toxic Materials
- ☐ Oil & Grease
- ☐ Floatable Materials
- ☐ Other Waste

- ■ High Impact
- ☒ Medium Impact
- ☐ Low or Unknown Impact

IMPLEMENTATION REQUIREMENTS
- ☒ Capital Costs
- ☒ O&M Costs
- ☒ Maintenance
- ☐ Training

■ High ☒ Medium ☐ Low

BMP: Waste Disposal — WD

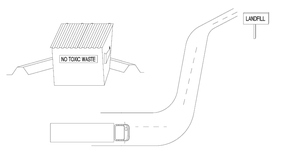

DESCRIPTION:
Controlled storage and disposal of solid waste generated by construction activities.

APPLICATION:
All construction sites.

INSTALLATION:
- Designate one or several waste collection areas with easy access for construction vehicles and personnel. Ensure no waterways or storm drainage inlets are located near the waste collection areas.
- Construct compacted earthen berm (See Earth Berm Barrier BMP Fact Sheet), or similar perimeter containment around collection area for impoundment in the case of spills and to trap any windblown trash.
- Use water tight containers with covers to remain closed when not in use. Provide separate containers for different waste types where appropriate and label clearly.
- Ensure all on-site personnel are aware of and utilize designated waste collection areas properly and for intended use only (e.g. all toxic, hazardous, or recyclable materials shall be properly disposed of separately from general construction waste).
- Arrange for periodic pickup, transfer and disposal of collected waste at an authorized disposal location. Include portable sanitary waste facilities in waste management activities.

LIMITATIONS:
- On-site personnel are responsible for correct disposal of waste.

MAINTENANCE:
- Discuss waste management procedures at progress meetings.
- Collect site trash daily and deposit in covered containers at designated collection areas.
- Check containers for leakage or inadequate covers and replace as needed.
- Randomly check disposed materials for any unauthorized waste (e.g. toxic materials).
- During daily site inspections check that waste is not being incorrectly disposed of on-site (e.g. burial, burning, surface discharge, discharge to storm drain).

OBJECTIVES
- ☒ Housekeeping Practices
- ☒ Contain Waste
- ☐ Minimize Disturbed Areas
- ☐ Stabilize Disturbed Areas
- ☐ Protect Slopes/Channels
- ☐ Control Site Perimeter
- ☐ Control Internal Erosion

ADAPTED FROM SALT LAKE COUNTY BMP FACTSHEET

TARGETED POLLUTANTS
- ▫ Sediment
- ▫ Nutrients
- ▪ Toxic Materials
- ▫ Oil & Grease
- ▫ Floatable Materials
- ▪ Other Waste

- ■ High Impact
- ☒ Medium Impact
- ☐ Low or Unknown Impact

IMPLEMENTATION REQUIREMENTS
- ▪ Capital Costs
- ▪ O&M Costs
- ▪ Maintenance
- ▪ Training

■ High ☒ Medium ☐ Low

PERIGEE CONSULTING
CIVIL • STRUCTURAL • SURVEY
9069 SOUTH 1300 WEST, SUITE 160
WEST JORDAN, UT 84088
801.628.6004 TEL 801.566.6011 FAX
WWW.PERIGEEDVN.COM

LICENSED PROFESSIONAL ENGINEER
No. 13937226
AUSTIN EARL WEAVER
19 NOV 2024
STATE OF UTAH

AMERICAN FORK CITY

CITY ENGINEER DATE

MARK	DESCRIPTION	DATE	APPR

DESIGNED BY:	AEW	DATE:	13 NOV 2024	REV:
DWN BY:	AEW	CKD BY:	TVW	SOLICITATION NO:
SUBMITTED BY:				CONTRACT NO: 01041
FILE NAME:	N:\01041 Holmes Gunther American Fork\Cadd\Plt\13 DT01			PLOT DATE: 11/14/2024 12:47:32 PM
SIZE:	ARCH D			PLOTTED BY:

ELLEN'S 2 SUBDIVISION
HOLMES HOMES
AMERICAN FORK STANDARD DETAILS

SHEET NUMBER
19
OF 20 SHEETS
DRAWING NAME
DT07

Blue Stakes of UTAH 811 bluestakes.org


11/14/2024 12:47:32 PM

CDS2015-4-C DESIGN NOTES

CDS2015-4-C RATED TREATMENT CAPACITY IS 0.7 CFS [19.8 L/s], OR PER LOCAL REGULATIONS. MAXIMUM HYDRAULIC INTERNAL BYPASS CAPACITY IS 10.0 CFS [283 L/s]. IF THE SITE CONDITIONS EXCEED 10.0 [283 L/s] CFS, AN UPSTREAM BYPASS STRUCTURE IS REQUIRED.


THE STANDARD CDS2015-4-C CONFIGURATION IS SHOWN. ALTERNATE CONFIGURATIONS ARE AVAILABLE AND ARE LISTED BELOW. SOME CONFIGURATIONS MAY BE COMBINED TO SUIT SITE REQUIREMENTS.

CONFIGURATION DESCRIPTION
GRATED INLET ONLY (NO INLET PIPE)
GRATED INLET WITH INLET PIPE OR PIPES
CURB INLET ONLY (NO INLET PIPE)
CURB INLET WITH INLET PIPE OR PIPES
SEPARATE OIL BAFFLE (SINGLE INLET PIPE REQUIRED FOR THIS CONFIGURATION)
SEDIMENT WEIR FOR NJDEP / NJCAT CONFORMING UNITS

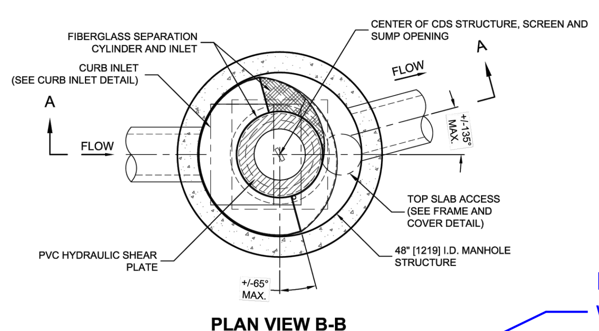

PLAN VIEW B-B
N.T.S.


How will this design work if curb cuts are required for access?

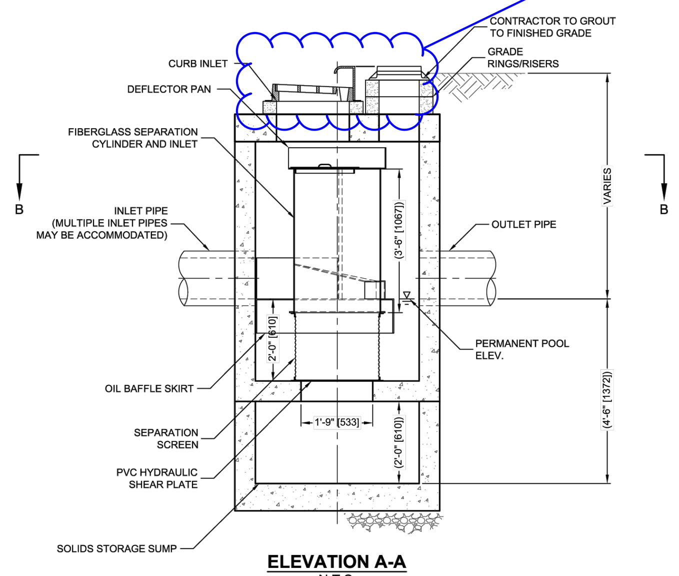


ELEVATION A-A
N.T.S.

I:\STORMWATER\COMMON\FS\22 CDS\40 STANDARD DRAWINGS\INLINE (CDS-C)\DWG\CDS2015-4-C-CURB INLET DTL.DWG 7/7/2014 1:54 PM

THIS PRODUCT MAY BE PROTECTED BY ONE OR MORE OF THE FOLLOWING U.S. PATENTS: 5,788,848; 6,641,720; 6,511,595; 6,581,783; RELATED FOREIGN PATENTS, OR OTHER PATENTS PENDING.

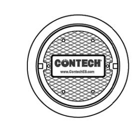

FRAME AND COVER
(DIAMETER VARIES)
N.T.S.

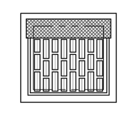

FRAME AND GRATE
N.T.S.

SITE SPECIFIC DATA REQUIREMENTS

STRUCTURE ID			
WATER QUALITY FLOW RATE (CFS OR L/s)			*
PEAK FLOW RATE (CFS OR L/s)			*
RETURN PERIOD OF PEAK FLOW (YRS)			*
SCREEN APERTURE (2400 OR 4700)			*
PIPE DATA:	I.E.	MATERIAL	DIAMETER
INLET PIPE 1	*	*	*
INLET PIPE 2	*	*	*
OUTLET PIPE	*	*	*
RIM ELEVATION			*
ANTI-FLOTATION BALLAST		WIDTH	HEIGHT
		*	*
NOTES/SPECIAL REQUIREMENTS:			
* PER ENGINEER OF RECORD			

GENERAL NOTES
1. CONTECH TO PROVIDE ALL MATERIALS UNLESS NOTED OTHERWISE.
2. DIMENSIONS MARKED WITH ( ) ARE REFERENCE DIMENSIONS. ACTUAL DIMENSIONS MAY VARY.
3. FOR FABRICATION DRAWINGS WITH DETAILED STRUCTURE DIMENSIONS AND WEIGHTS, PLEASE CONTACT YOUR CONTECH ENGINEERED SOLUTIONS LLC REPRESENTATIVE. www.ContechES.com
4. CDS WATER QUALITY STRUCTURE SHALL BE IN ACCORDANCE WITH ALL DESIGN DATA AND INFORMATION CONTAINED IN THIS DRAWING.
5. STRUCTURE SHALL MEET AASHTO HS20 AND CASTINGS SHALL MEET HS20 (AASHTO M 306) LOAD RATING, ASSUMING GROUNDWATER ELEVATION AT, OR BELOW, THE OUTLET PIPE INVERT ELEVATION. ENGINEER OF RECORD TO CONFIRM ACTUAL GROUNDWATER ELEVATION.
6. PVC HYDRAULIC SHEAR PLATE IS PLACED ON SHELF AT BOTTOM OF SCREEN CYLINDER. REMOVE AND REPLACE AS NECESSARY DURING MAINTENANCE CLEANING.


INSTALLATION NOTES
A. ANY SUB-BASE, BACKFILL DEPTH, AND/OR ANTI-FLOTATION PROVISIONS ARE SITE-SPECIFIC DESIGN CONSIDERATIONS AND SHALL BE SPECIFIED BY ENGINEER OF RECORD.
B. CONTRACTOR TO PROVIDE EQUIPMENT WITH SUFFICIENT LIFTING AND REACH CAPACITY TO LIFT AND SET THE CDS MANHOLE STRUCTURE (LIFTING CLUTCHES PROVIDED).
C. CONTRACTOR TO ADD JOINT SEALANT BETWEEN ALL STRUCTURE SECTIONS, AND ASSEMBLE STRUCTURE.
D. CONTRACTOR TO PROVIDE, INSTALL, AND GROUT PIPES. MATCH PIPE INVERTS WITH ELEVATIONS SHOWN.
E. CONTRACTOR TO TAKE APPROPRIATE MEASURES TO ASSURE UNIT IS WATER TIGHT, HOLDING WATER TO FLOWLINE INVERT MINIMUM. IT IS SUGGESTED THAT ALL JOINTS BELOW PIPE INVERTS ARE GROUTED.

CONTECH® ENGINEERED SOLUTIONS LLC
www.ContechES.com
9025 Centre Pointe Dr., Suite 400, West Chester, OH 45069
800-338-1122 513-645-7000 513-645-7993 FAX

CDS2015-4-C WITH CURB INLET
INLINE CDS
STANDARD DETAIL

7191Z/7191M/7191T COMBINATION

NOTE: COMPONENTS ARE SHIPPED LOOSE. NOT ASSEMBLED

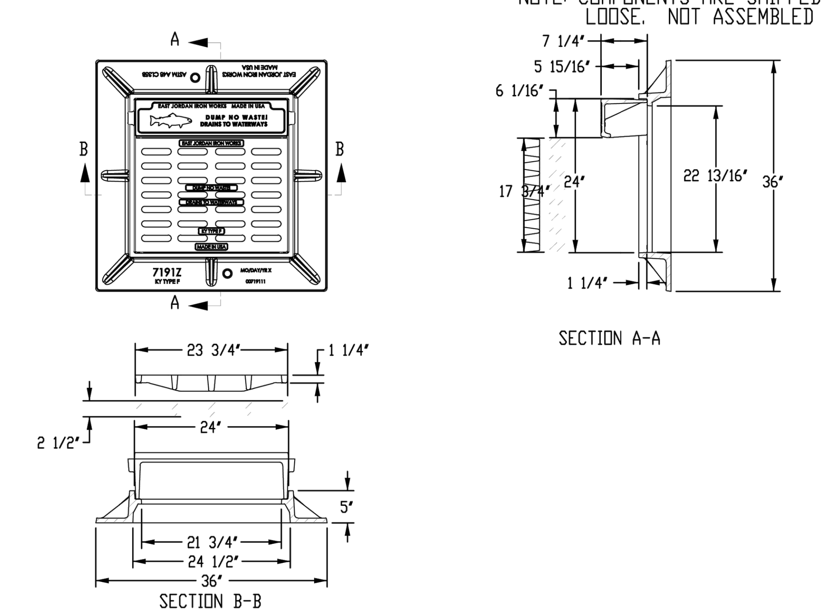

PRODUCT NUMBER
00719131C01

DESIGN FEATURES
MATERIALS
FRAME-GRAY IRON ASTM A48 CL35B
GRATE-GRAY IRON ASTM A48 CL35B
HOOD-GRAY IRON ASTM A48 CL35B

DESIGN LOAD
HEAVY DUTY
COATING
UNDIPPED
OPEN AREA
123 SQ INCHES
✓ DESIGNATES MACHINE SURFACE

REFERENCE INFORMATION
00719111
00719131
00719161
DRAWING DETAILS
ORIGINAL DRAWING: DEF 2/10/2010
REVISED BY:

Corporate Headquarters
301 Spring Street
PO Box 439
East Jordan, MI
49727-0439
800.874.4100
EJ GROUP

Call Today for More Information 800.626.4653 EJIW EAST JORDAN IRON WORKS EST.1883 WE COVER YOUR INFRASTRUCTURE® www.ejiw.com MADE IN THE USA

*Weights (lbs/kg) dimensions (inches/mm), and drawings provided for your guidance.
*We reserve the right to modify specifications without prior notice.
*Uncontrolled distribution.

CONFIDENTIAL: This drawing is the property of East Jordan Iron Works, Inc. and embodies confidential information, registered marks, trade secret information, and/or know how that is the property of East Jordan Iron Works, Inc. ©Copyright 2009 East Jordan Iron Works, Inc.


PROJECT SUMMARY

CALCULATION DETAILS
- LOADING = HS20/HS25
- APPROX. LINEAR FOOTAGE = 152 LF

STORAGE SUMMARY
- STORAGE VOLUME REQUIRED = 11,342 CF
- PIPE STORAGE VOLUME = 9,670 CF
- BACKFILL STORAGE VOLUME = 1,673 CF
- TOTAL STORAGE PROVIDED = 11,343 CF
- STONE VOID = 30%

PIPE DETAILS
- DIAMETER = 108"
- CORRUGATION = 5x1
- GAGE = 14
- COATING = "VARIES"
- WALL TYPE = PERFORATED
- BARREL SPACING = 36"

BACKFILL DETAILS
- WIDTH AT ENDS = 12"
- ABOVE PIPE = 0"
- WIDTH AT SIDES = 12"
- BELOW PIPE = 0"

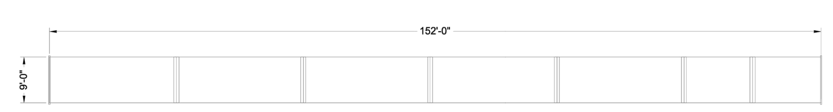

ASSEMBLY
SCALE: 1" = 20'

NOTES
- ALL RISER AND STUB DIMENSIONS ARE TO CENTERLINE. ALL ELEVATIONS, DIMENSIONS, AND LOCATIONS OF RISERS AND INLETS, SHALL BE VERIFIED BY THE ENGINEER OF RECORD PRIOR TO RELEASING FOR FABRICATION.
- ALL FITTINGS AND REINFORCEMENT COMPLY WITH ASTM A998.
- ALL RISERS AND STUBS ARE $2\frac{2}{3}$" x $\frac{1}{2}$" CORRUGATION AND 16 GAGE UNLESS OTHERWISE NOTED.
- RISERS TO BE FIELD TRIMMED TO GRADE.
- QUANTITY OF PIPE SHOWN DOES NOT PROVIDE EXTRA PIPE FOR CONNECTING THE SYSTEM TO EXISTING PIPE OR DRAINAGE STRUCTURES. OUR SYSTEM AS DETAILED PROVIDES NOMINAL INLET AND/OR OUTLET PIPE STUB FOR CONNECTION TO EXISTING DRAINAGE FACILITIES. IF ADDITIONAL PIPE IS NEEDED IT IS THE RESPONSIBILITY OF THE CONTRACTOR.
- BAND TYPE TO BE DETERMINED UPON FINAL DESIGN.
- THE PROJECT SUMMARY IS REFLECTIVE OF THE DYODS DESIGN, QUANTITIES ARE APPROX. AND SHOULD BE VERIFIED UPON FINAL DESIGN AND APPROVAL. FOR EXAMPLE, TOTAL EXCAVATION DOES NOT CONSIDER ALL VARIABLES SUCH AS SHORING AND ONLY ACCOUNTS FOR MATERIAL WITHIN THE ESTIMATED EXCAVATION FOOTPRINT.
- THESE DRAWINGS ARE FOR CONCEPTUAL PURPOSES AND DO NOT REFLECT ANY LOCAL PREFERENCES OR REGULATIONS. PLEASE CONTACT YOUR LOCAL CONTECH REP FOR MODIFICATIONS.

C:\EXPORTS\TEMPLATES\CMP_V10.DWG 10/18/2019 10:02 AM

The design and information shown on this drawing is provided as a service to the project owner, engineer and contractor by Contech Engineered Solutions LLC ("Contech"). Neither this drawing, nor any part thereof, may be used, reproduced or modified in any manner without the prior written consent of Contech. Failure to comply is done at the user's own risk and Contech expressly disclaims any liability or responsibility for such use.

If discrepancies between the supplied information upon which the drawing is based and actual field conditions are encountered as site work progresses, these discrepancies must be reported to Contech immediately for re-evaluation of the design. Contech accepts no liability for designs based on missing, incomplete or inaccurate information supplied by others.

DATE	REVISION DESCRIPTION	BY

CONTECH® ENGINEERED SOLUTIONS LLC
www.ContechES.com
9025 Centre Pointe Dr., Suite 400, West Chester, OH 45069
800-338-1122 513-645-7000 513-645-7993 FAX

CONTECH® CMP DETENTION SYSTEMS
CONTECH DYODS DRAWING

DYO51037 Gunther
Gunther
American Fork, UT
DETENTION SYSTEM

RETENTION


PROJECT No.: 35504	SEQ. No.: 51037	DATE: 11/12/2024
DESIGNED: DYO	DRAWN: DYO	
CHECKED: DYO	APPROVED: DYO	
SHEET NO.: 1		

It is unclear if this CMP is perforated? If not, how long will water remain in pipe after a 100-yr event for example?

TABLE 1:

DIAMETER, D	MIN. COVER	CORR. PROFILE
6"-10"	12"	1 1/2" x 1/4"
12"-48"	12"	2 2/3" x 1/2"
>48"-96"	12"	3" x 1", 5" x 1"
>96"	D/8	3" x 1", 5" x 1"

- STRUCTURAL BACKFILL MUST EXTEND TO LIMITS OF THE TABLE
- TOTAL HEIGHT OF COMPACTED COVER FOR CONVENTIONAL HIGHWAY LOADS IS MEASURED FROM TOP OF PIPE TO BOTTOM OF FLEXIBLE PAVEMENT OR TOP OF RIGID PAVEMENT.

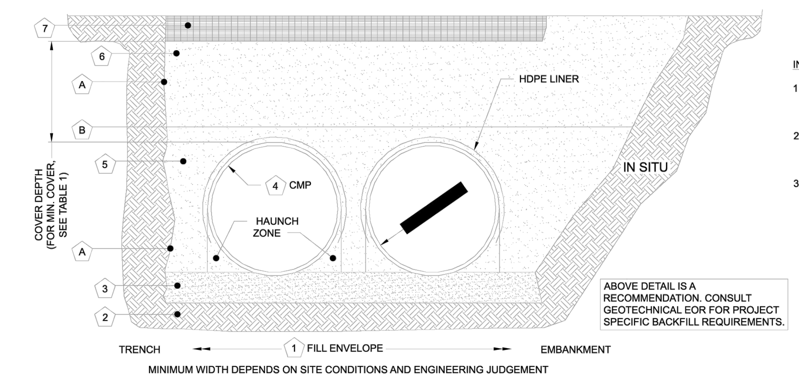

INSTALLATION NOTES
1. WHEN PLACING THE FIRST LIFTS OF BACKFILL IT IS IMPORTANT TO MAKE SURE THAT THE BACKFILL IS PROPERLY COMPACTED UNDER AND AROUND THE PIPE HAUNCHES.
2. OTHER ALTERNATE BACKFILL MATERIAL MAY BE ALLOWED DEPENDING ON SITE SPECIFIC CONDITIONS, AS APPROVED BY SITE ENGINEER.
3. AN HDPE MEMBRANE LINER WILL BE PLACED ON THE CROWN OF EACH PIPE TO PROVIDE AN IMPERMEABLE BARRIER AGAINST ENVIRONMENTAL CHANGES THAT MAY ADVERSELY AFFECT THE SYSTEM OVER TIME. PLEASE REFER TO THE CORRUGATED METAL PIPE DETENTION DESIGN GUIDE FOR ADDITIONAL TECHNICAL DETAILS.

TABLE 2: PERFORATED STANDARD

CMP RETENTION STANDARD BACKFILL SPECIFICATIONS

	MATERIAL LOCATION	MATERIAL SPECIFICATION	DESCRIPTION	
1	FILL ENVELOPE WIDTH	PER ENGINEER OF RECORD	MINIMUM TRENCH WIDTH MUST ALLOW ROOM FOR PROPER COMPACTION OF HAUNCH MATERIALS UNDER THE PIPE. THE SUGGESTED MINIMUM TRENCH WIDTH, OR EOR RECOMMENDATION: PIPE ≤ 12": D + 16" PIPE > 12": 1.5D + 12"	MINIMUM EMBANKMENT WIDTH (IN FEET) FOR INITIAL FILL ENVELOPE: PIPE < 24": 3.0D PIPE 24" - 144": D + 4'0" PIPE > 144": D + 10'0"
2	FOUNDATION	**AASHTO 26.5.2** - PER ENGINEER OF RECORD	PRIOR TO PLACING THE BEDDING, THE FOUNDATION MUST BE CONSTRUCTED TO A UNIFORM AND STABLE GRADE. IN THE EVENT THAT UNSUITABLE FOUNDATION MATERIALS ARE ENCOUNTERED DURING EXCAVATION, THEY SHALL BE REMOVED AND FOUNDATION BROUGHT BACK TO GRADE WITH A FILL MATERIAL APPROVED BY THE ENGINEER OF RECORD.	
3	BEDDING	**AASHTO M 43: 3, 357, 4, 467, 5, 56, 57**	ENGINEER OF RECORD TO DETERMINE IF BEDDING IS REQUIRED. PIPE MAY BE PLACED ON THE TRENCH BOTTOM OF A RELATIVELY LOOSE, NATIVE SUITABLE WELL GRADED GRANULAR MATERIAL THAT IS ROUGHLY SHAPED TO FIT THE BOTTOM OF THE PIPE, 2" MIN DEPTH. THE BEDDING MATERIAL MAY BE SUITABLE OPEN GRADED GRANULAR BEDDING CONFORMING TO AASHTO SOIL CLASSIFICATIONS A1, A2, OR A3 WITH MAXIMUM PARTICLE SIZE OF 3" PER AASHTO 26.3.8.1	
4			CORRUGATED METAL PIPE	
5	BACKFILL	FREE-DRAINING, ANGULAR, NATURALLY OCCURRING WASHED-STONE PER **AASHTO M 43: 3, 357, 4, 467, 5, 56, 57** OR APPROVED EQUAL *	HAUNCH ZONE MATERIAL SHALL BE HAND SHOVELED OR SHOVEL SLICED INTO PLACE TO ALLOW FOR PROPER COMPACTION WITHOUT SOFT SPOTS. BACKFILL SHALL BE PLACED IN 8" +/- LOOSE LIFTS AND COMPACTED TO 90% STANDARD PROCTOR PER AASHTO T 99. BACKFILL SHALL BE PLACED SUCH THAT THERE IS NO MORE THAN A TWO LIFT (16") DIFFERENTIAL BETWEEN ANY OF THE PIPES AT ANY TIME DURING THE BACKFILL PROCESS. THE BACKFILL SHOULD BE ADVANCED ALONG THE LENGTH OF THE SYSTEM TO AVOID DIFFERENTIAL LOADING. WHERE CONVENTIONAL COMPACTION TESTING IS NOT PRACTICAL, THE MATERIAL SHALL BE MECHANICALLY COMPACTED UNTIL NO FURTHER YIELDING OF MATERIAL IS OBSERVED UNDER THE COMPACTOR. **IN AREAS WITH HIGH WATER TABLE FLUCTUATIONS THAT INTERACT WITH THE PIPE ZONE, CONSIDER INSTALLING A GEOTEXTILE SEPARATION LAYER TO PREVENT SOIL MIGRATION.	
6	COVER MATERIAL	UP TO MIN. COVER - **AASHTO M 145: A-1, A-2, A-3** ABOVE MIN. COVER - PER ENGINEER OF RECORD	COVER MATERIAL MAY INCLUDE NON-BITUMINOUS, GRANULAR ROADBASE MATERIAL WITHIN MIN COVER LIMITS	
7	RIGID OR FLEXIBLE PAVEMENT (IF APPLICABLE)	PER ENGINEER OF RECORD	FLEXIBLE PAVEMENT SHOULD NOT BE COUNTED AS PART OF THE FILL HEIGHT OVER THE CMP. FINAL BACKFILL MATERIAL SELECTION AND COMPACTION REQUIREMENTS SHALL FOLLOW THE PROJECT PLANS AND SPECIFICATIONS PER THE ENGINEER OF RECORD.	
A	OPTIONAL SIDE GEOTEXTILE	NONE	GEOTEXTILE LAYER IS RECOMMENDED ON SIDES OF EXCAVATION TO PREVENT SOIL MIGRATION.	
B	GEOTEXTILE BETWEEN LAYERS	NONE	IF SOIL TYPES DIFFER AT ANY POINT ABOVE PIPE INVERT, A GEOTEXTILE LAYER IS RECOMMENDED TO BE PLACED BETWEEN THE LAYERS TO PREVENT SOIL MIGRATION.	

NOTES:
- FOR MULTIPLE BARREL INSTALLATIONS, THE RECOMMENDED STANDARD SPACING BETWEEN PARALLEL PIPE RUNS SHALL BE THE PIPE DIAMETER /2 BUT NO LESS THAN 12" FOR DIAMETERS <72". FOR 72" AND LARGER DIAMETERS, THE MINIMUM SPACING IS 36". CONTACT YOUR CONTECH REPRESENTATIVE FOR NONSTANDARD SPACING.
- * APPROVED REGIONAL EQUIVALENTS FOR SECTION 5 INCLUDE CA-7, MIDOT 6AA, 6A, OR 5G, PROVIDED THEY MEET THE PARTICLE SIZES INDICATED.

MANUFACTURER RECOMMENDED BACKFILL
NOT TO SCALE

C:\USERS\JEREMY.JOHNSON\DOCUMENTS\DYO\CMP_V10.DWG 10/18/2019 10:02 AM

The design and information shown on this drawing is provided as a service to the project owner, engineer and contractor by Contech Engineered Solutions LLC ("Contech"). Neither this drawing, nor any part thereof, may be used, reproduced or modified in any manner without the prior written consent of Contech. Failure to comply is done at the user's own risk and Contech expressly disclaims any liability or responsibility for such use.

If discrepancies between the supplied information upon which the drawing is based and actual field conditions are encountered as site work progresses, these discrepancies must be reported to Contech immediately for re-evaluation of the design. Contech accepts no liability for designs based on missing, incomplete or inaccurate information supplied by others.

DATE	REVISION DESCRIPTION	BY


CONTECH® ENGINEERED SOLUTIONS LLC
www.ContechES.com
9025 Centre Pointe Dr., Suite 400, West Chester, OH 45069
800-338-1122 513-645-7000 513-645-7993 FAX

CONTECH® CMP DETENTION SYSTEMS
CONTECH DYODS DRAWING

DYO51037 Gunther
Gunther
American Fork, UT
DETENTION SYSTEM

RETENTION

PROJECT No.: 35504	SEQ. No.: 51037	DATE: 9/26/2024
DESIGNED: DYO	DRAWN: DYO	
CHECKED: DYO	APPROVED: DYO	
SHEET NO.: 1		

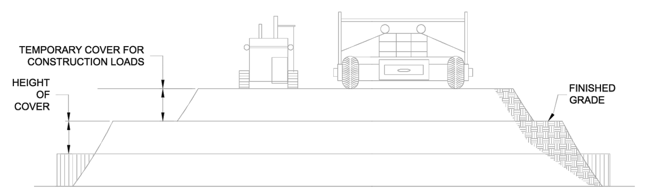

CONSTRUCTION LOADS

FOR TEMPORARY CONSTRUCTION VEHICLE LOADS, AN EXTRA AMOUNT OF COMPACTED COVER MAY BE REQUIRED OVER THE TOP OF THE PIPE. THE HEIGHT-OF-COVER SHALL MEET THE MINIMUM REQUIREMENTS SHOWN IN THE TABLE BELOW. THE USE OF HEAVY CONSTRUCTION EQUIPMENT NECESSITATES GREATER PROTECTION FOR THE PIPE THAN FINISHED GRADE COVER MINIMUMS FOR NORMAL HIGHWAY TRAFFIC.

PIPE SPAN, INCHES	AXLE LOADS (kips)			
	18-50	50-75	75-110	110-150
	MINIMUM COVER (FT)			
12-42	2.0	2.5	3.0	3.0
48-72	3.0	3.0	3.5	4.0
78-120	3.0	3.5	4.0	4.0
126-144	3.5	4.0	4.5	4.5

*MINIMUM COVER MAY VARY, DEPENDING ON LOCAL CONDITIONS. THE CONTRACTOR MUST PROVIDE THE ADDITIONAL COVER REQUIRED TO AVOID DAMAGE TO THE PIPE. MINIMUM COVER IS MEASURED FROM THE TOP OF THE PIPE TO THE TOP OF THE MAINTAINED CONSTRUCTION ROADWAY SURFACE.

CONSTRUCTION LOADING DIAGRAM
SCALE: N.T.S.

SPECIFICATION FOR DESIGNED DETENTION SYSTEM:

SCOPE
THIS SPECIFICATION COVERS THE MANUFACTURE AND INSTALLATION OF THE DESIGNED DETENTION SYSTEM DETAILED IN THE PROJECT PLANS.

MATERIAL
THE MATERIAL SHALL CONFORM TO THE APPLICABLE REQUIREMENTS LISTED BELOW:

ALUMINIZED TYPE 2 STEEL COILS SHALL CONFORM TO THE REQUIREMENTS OF AASHTO M-274 OR ASTM A-92.

THE GALVANIZED STEEL COILS SHALL CONFORM TO THE REQUIREMENTS OF AASHTO M-218 OR ASTM A-929.

THE POLYMER COATED STEEL COILS SHALL CONFORM TO THE REQUIREMENTS OF AASHTO M-246 OR ASTM A-742.

THE ALUMINUM COILS SHALL CONFORM TO THE APPLICABLE OF AASHTO M-197 OR ASTM B-744.

CONSTRUCTION LOADS
CONSTRUCTION LOADS MAY BE HIGHER THAN FINAL LOADS. FOLLOW THE MANUFACTURER'S OR NCSPA GUIDELINES.

PIPE
THE PIPE SHALL BE MANUFACTURED IN ACCORDANCE TO THE APPLICABLE REQUIREMENTS LISTED BELOW:

ALUMINIZED TYPE 2: AASHTO M-36 OR ASTM A-760

GALVANIZED: AASHTO M-36 OR ASTM A-760

APPLICABLE POLYMER COATED: AASHTO M-245 OR ASTM A-762


ALUMINUM: AASHTO M-196 OR ASTM B-745

HANDLING AND ASSEMBLY
SHALL BE IN ACCORDANCE WITH NCSPS'S (NATIONAL CORRUGATED STEEL PIPE ASSOCIATION) FOR ALUMINIZED TYPE 2, GALVANIZED OR POLYMER COATED STEEL. SHALL BE IN ACCORDANCE WITH THE MANUFACTURER'S RECOMMENDATIONS FOR ALUMINUM PIPE.

INSTALLATION
SHALL BE IN ACCORDANCE WITH AASHTO STANDARD SPECIFICATIONS FOR HIGHWAY BRIDGES, SECTION 26, DIVISION II DIVISION II OR ASTM A-798 (FOR ALUMINIZED TYPE 2, GALVANIZED OR POLYMER COATED STEEL) OR ASTM B-788 (FOR ALUMINUM PIPE) AND IN CONFORMANCE WITH THE PROJECT PLANS AND SPECIFICATIONS. IF THERE ARE ANY INCONSISTENCIES OR CONFLICTS THE CONTRACTOR SHOULD DISCUSS AND RESOLVE WITH THE SITE ENGINEER.

IT IS ALWAYS THE RESPONSIBILITY OF THE CONTRACTOR TO FOLLOW OSHA GUIDELINES FOR SAFE PRACTICES.

NOTE:
THESE DRAWINGS ARE FOR CONCEPTUAL PURPOSES AND DO NOT REFLECT ANY LOCAL PREFERENCES OR REGULATIONS. PLEASE CONTACT YOUR LOCAL CONTECH REP FOR MODIFICATIONS.

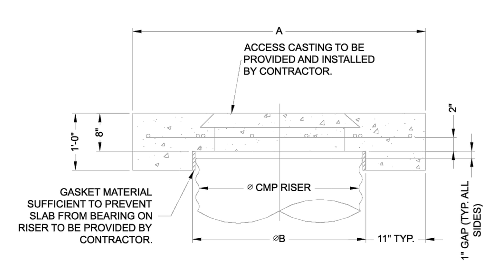


SECTION VIEW


REINFORCING TABLE

⌀ CMP RISER	A	⌀ B	REINFORCING	**BEARING PRESSURE (PSF)
24"	⌀ 4' 4'X4'	26"	#5 @ 12" OCEW #5 @ 12" OCEW	2,410 1,780
30"	⌀ 4'-6" 4'-6" X 4'-6"	32"	#5 @ 12" OCEW #5 @ 12" OCEW	2,120 1,530
36"	⌀ 5' 5' X 5'	38"	#5 @ 10" OCEW #5 @ 10" OCEW	1,890 1,350
42"	⌀ 5'-6" 5'-6" X 5'-6"	44"	#5 @ 10" OCEW #5 @ 9" OCEW	1,720 1,210
48"	⌀ 6' 6' X 6'	50"	#5 @ 9" OCEW #5 @ 8" OCEW	1,600 1,100

** ASSUMED SOIL BEARING CAPACITY

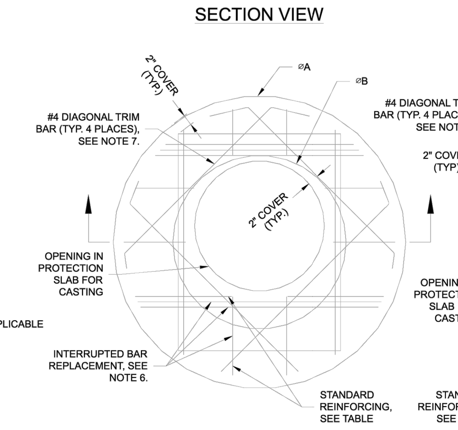

ROUND OPTION PLAN VIEW

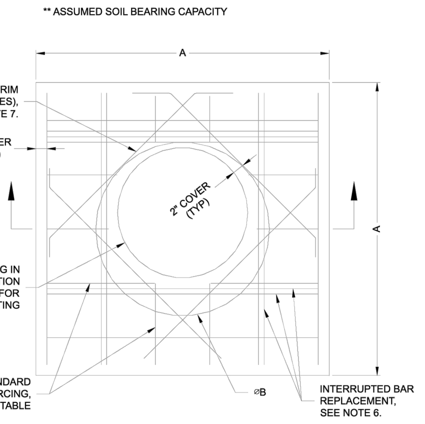

SQUARE OPTION PLAN VIEW

NOTES:
1. DESIGN IN ACCORDANCE WITH AASHTO, 17th EDITION.
2. DESIGN LOAD HS25.
3. EARTH COVER = 1' MAX.
4. CONCRETE STRENGTH = 3,500 psi
5. REINFORCING STEEL = ASTM A615, GRADE 60.
6. PROVIDE ADDITIONAL REINFORCING AROUND OPENINGS EQUAL TO THE BARS INTERRUPTED, HALF EACH SIDE. ADDITIONAL BARS TO BE IN THE SAME PLANE.
7. TRIM OPENING WITH DIAGONAL #4 BARS, EXTEND BARS A MINIMUM OF 12" BEYOND OPENING, BEND BARS AS REQUIRED TO MAINTAIN BAR COVER.
8. PROTECTION SLAB AND ALL MATERIALS TO BE PROVIDED AND INSTALLED BY CONTRACTOR.
9. DETAIL DESIGN BY DELTA ENGINEERING, BINGHAMTON, NY.

MANHOLE CAP DETAIL
SCALE: N.T.S.

C:\USERS\JEREMY.JOHNSON\DOCUMENTS\DYO\CMP_V10.DWG 10/18/2019 10:02 AM

The design and information shown on this drawing is provided as a service to the project owner, engineer and contractor by Contech Engineered Solutions LLC ("Contech"). Neither this drawing, nor any part thereof, may be used, reproduced or modified in any manner without the prior written consent of Contech. Failure to comply is done at the user's own risk and Contech expressly disclaims any liability or responsibility for such use.

If discrepancies between the supplied information upon which the drawing is based and actual field conditions are encountered as site work progresses, these discrepancies must be reported to Contech immediately for re-evaluation of the design. Contech accepts no liability for designs based on missing, incomplete or inaccurate information supplied by others.

DATE	REVISION DESCRIPTION	BY

CONTECH® ENGINEERED SOLUTIONS LLC
www.ContechES.com
9025 Centre Pointe Dr., Suite 400, West Chester, OH 45069
800-338-1122 513-645-7000 513-645-7993 FAX

CONTECH® CMP DETENTION SYSTEMS
CONTECH DYODS DRAWING

DYO51037 Gunther
Gunther
American Fork, UT
DETENTION SYSTEM

RETENTION

PROJECT No.: 35504	SEQ. No.: 51037	DATE: 9/26/2024
DESIGNED: DYO	DRAWN: DYO	
CHECKED: DYO	APPROVED: DYO	
SHEET NO.: 1		


CMP DETENTION INSTALLATION GUIDE

PROPER INSTALLATION OF A FLEXIBLE UNDERGROUND DETENTION SYSTEM WILL ENSURE LONG-TERM PERFORMANCE. THE CONFIGURATION OF THESE SYSTEMS OFTEN REQUIRES SPECIAL CONSTRUCTION PRACTICES THAT DIFFER FROM CONVENTIONAL FLEXIBLE PIPE CONSTRUCTION. CONTECH ENGINEERED SOLUTIONS STRONGLY SUGGESTS SCHEDULING A PRE-CONSTRUCTION MEETING WITH YOUR LOCAL SALES ENGINEER TO DETERMINE IF ADDITIONAL MEASURES, NOT COVERED IN THIS GUIDE, ARE APPROPRIATE FOR YOUR SITE.

FOUNDATION

CONSTRUCT A FOUNDATION THAT CAN SUPPORT THE DESIGN LOADING APPLIED BY THE PIPE AND ADJACENT BACKFILL WEIGHT AS WELL AS MAINTAIN ITS INTEGRITY DURING CONSTRUCTION.

IF SOFT OR UNSUITABLE SOILS ARE ENCOUNTERED, REMOVE THE POOR SOILS DOWN TO A SUITABLE DEPTH AND THEN BUILD UP TO THE APPROPRIATE ELEVATION WITH A COMPETENT BACKFILL MATERIAL. THE STRUCTURAL FILL MATERIAL GRADATION SHOULD NOT ALLOW THE MIGRATION OF FINES, WHICH CAN CAUSE SETTLEMENT OF THE DETENTION SYSTEM OR PAVEMENT ABOVE. IF THE STRUCTURAL FILL MATERIAL IS NOT COMPATIBLE WITH THE UNDERLYING SOILS AN ENGINEERING FABRIC SHOULD BE USED AS A SEPARATOR. IN SOME CASES, USING A STIFF REINFORCING GEOGRID REDUCES OVER EXCAVATION AND REPLACEMENT FILL QUANTITIES.

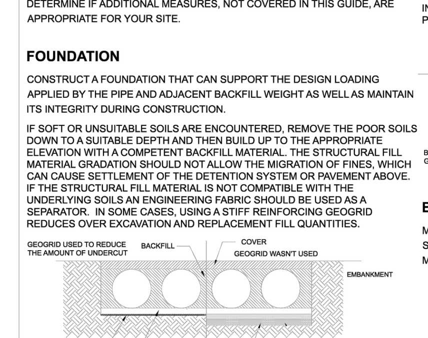


GRADE THE FOUNDATION SUBGRADE TO A UNIFORM OR SLIGHTLY SLOPING GRADE. IF THE SUBGRADE IS CLAY OR RELATIVELY NON-POROUS AND THE CONSTRUCTION SEQUENCE WILL LAST FOR AN EXTENDED PERIOD OF TIME, IT IS BEST TO SLOPE THE GRADE TO ONE END OF THE SYSTEM. THIS WILL ALLOW EXCESS WATER TO DRAIN QUICKLY, PREVENTING SATURATION OF THE SUBGRADE.

GEOMEMBRANE BARRIER

A SITE'S RESISTIVITY MAY CHANGE OVER TIME WHEN VARIOUS TYPES OF SALTING AGENTS ARE USED, SUCH AS ROAD SALTS FOR DEICING AGENTS. IF SALTING AGENTS ARE USED ON OR NEAR THE PROJECT SITE, A GEOMEMBRANE BARRIER IS RECOMMENDED WITH THE SYSTEM. THE GEOMEMBRANE LINER IS INTENDED TO HELP PROTECT THE SYSTEM FROM THE POTENTIAL ADVERSE EFFECTS THAT MAY RESULT FROM THE USE OF SUCH AGENTS INCLUDING PREMATURE CORROSION AND REDUCED ACTUAL SERVICE LIFE.


THE PROJECT'S ENGINEER OF RECORD IS TO EVALUATE WHETHER SALTING AGENTS WILL BE USED ON OR NEAR THE PROJECT SITE, AND USE HIS/HER BEST JUDGEMENT TO DETERMINE IF ANY ADDITIONAL PROTECTIVE MEASURES ARE REQUIRED. BELOW IS A TYPICAL DETAIL SHOWING THE PLACEMENT OF A GEOMEMBRANE BARRIER FOR PROJECTS WHERE SALTING AGENTS ARE USED ON OR NEAR THE PROJECT SITE.

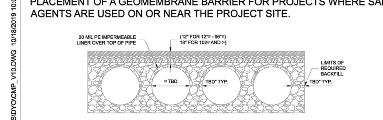

IN-SITU TRENCH WALL


IF EXCAVATION IS REQUIRED, THE TRENCH WALL NEEDS TO BE CAPABLE OF SUPPORTING THE LOAD THAT THE PIPE SHEDS AS THE SYSTEM IS LOADED. IF SOILS ARE NOT CAPABLE OF SUPPORTING THESE LOADS, THE PIPE CAN DEFLECT. PERFORM A SIMPLE SOIL PRESSURE CHECK USING THE APPLIED LOADS TO DETERMINE THE LIMITS OF EXCAVATION BEYOND THE SPRING LINE OF THE OUTER MOST PIPES.

IN MOST CASES THE REQUIREMENTS FOR A SAFE WORK ENVIRONMENT AND PROPER BACKFILL PLACEMENT AND COMPACTION TAKE CARE OF THIS CONCERN.

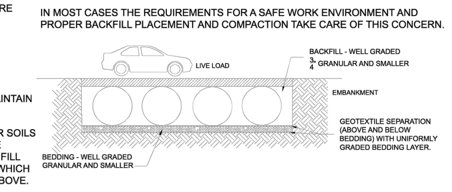


BACKFILL PLACEMENT

MATERIAL SHALL BE WORKED INTO THE PIPE HAUNCHES BY MEANS OF SHOVEL-SLICING, RODDING, AIR TAMPER, VIBRATORY ROD, OR OTHER EFFECTIVE METHODS.

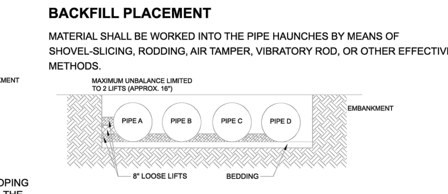


IF AASHTO T99 PROCEDURES ARE DETERMINED INFEASIBLE BY THE GEOTECHNICAL ENGINEER OF RECORD, COMPACTION IS CONSIDERED ADEQUATE WHEN NO FURTHER YIELDING OF THE MATERIAL IS OBSERVED UNDER THE COMPACTOR, OR UNDER FOOT, AND THE GEOTECHNICAL ENGINEER OF RECORD (OR REPRESENTATIVE THEREOF) IS SATISFIED WITH THE LEVEL OF COMPACTION.

FOR LARGE SYSTEMS, CONVEYOR SYSTEMS, BACKHOES WITH LONG REACHES OR DRAGLINES WITH STONE BUCKETS MAY BE USED TO PLACE BACKFILL. ONCE MINIMUM COVER FOR CONSTRUCTION LOADING ACROSS THE ENTIRE WIDTH OF THE SYSTEM IS REACHED, ADVANCE THE EQUIPMENT TO THE END OF THE RECENTLY PLACED FILL, AND BEGIN THE SEQUENCE AGAIN UNTIL THE SYSTEM IS COMPLETELY BACKFILLED. THIS TYPE OF CONSTRUCTION SEQUENCE PROVIDES ROOM FOR STOCKPILED BACKFILL DIRECTLY BEHIND THE BACKHOE, AS WELL AS THE MOVEMENT OF CONSTRUCTION TRAFFIC. MATERIAL STOCKPILES ON TOP OF THE BACKFILLED DETENTION SYSTEM SHOULD BE LIMITED TO 8- TO 10-FEET HIGH AND MUST PROVIDE BALANCED LOADING ACROSS ALL BARRELS. TO DETERMINE THE PROPER COVER OVER THE PIPES TO ALLOW THE MOVEMENT OF CONSTRUCTION EQUIPMENT SEE TABLE 1, OR CONTACT YOUR LOCAL CONTECH SALES ENGINEER.

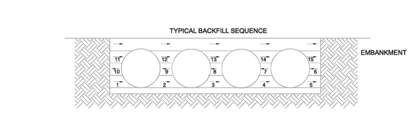

WHEN FLOWABLE FILL IS USED, YOU MUST PREVENT PIPE FLOATATION. TYPICALLY, SMALL LIFTS ARE PLACED BETWEEN THE PIPES AND THEN ALLOWED TO SET-UP PRIOR TO THE PLACEMENT OF THE NEXT LIFT. THE ALLOWABLE THICKNESS OF THE CLSM LIFT IS A FUNCTION OF A PROPER BALANCE BETWEEN THE UPLIFT FORCE OF THE CLSM, THE OPPOSING WEIGHT OF THE PIPE, AND THE EFFECT OF OTHER RESTRAINING MEASURES. THE PIPE CAN CARRY LIMITED FLUID PRESSURE WITHOUT PIPE DISTORTION OR DISPLACEMENT, WHICH ALSO AFFECTS THE CLSM LIFT THICKNESS. YOUR LOCAL CONTECH SALES ENGINEER CAN HELP DETERMINE THE PROPER LIFT THICKNESS.

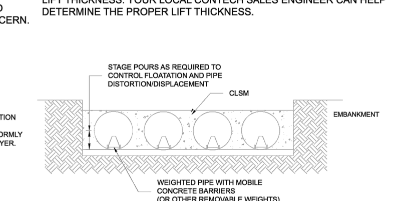


CONSTRUCTION LOADING

TYPICALLY, THE MINIMUM COVER SPECIFIED FOR A PROJECT ASSUMES H-20 LIVE LOAD. BECAUSE CONSTRUCTION LOADS OFTEN EXCEED DESIGN LIVE LOADS, INCREASED TEMPORARY MINIMUM COVER REQUIREMENTS ARE NECESSARY. SINCE CONSTRUCTION EQUIPMENT VARIES FROM JOB TO JOB, IT IS BEST TO ADDRESS EQUIPMENT SPECIFIC MINIMUM COVER REQUIREMENTS WITH YOUR LOCAL CONTECH SALES ENGINEER DURING YOUR PRE-CONSTRUCTION MEETING.

ADDITIONAL CONSIDERATIONS

BECAUSE MOST SYSTEMS ARE CONSTRUCTED BELOW-GRADE, RAINFALL CAN RAPIDLY FILL THE EXCAVATION; POTENTIALLY CAUSING FLOATATION AND MOVEMENT OF THE PREVIOUSLY PLACED PIPES. TO HELP MITIGATE POTENTIAL PROBLEMS, IT IS BEST TO START THE INSTALLATION AT THE DOWNSTREAM END WITH THE OUTLET ALREADY CONSTRUCTED TO ALLOW A ROUTE FOR THE WATER TO ESCAPE. TEMPORARY DIVERSION MEASURES MAY BE REQUIRED FOR HIGH FLOWS DUE TO THE RESTRICTED NATURE OF THE OUTLET PIPE.

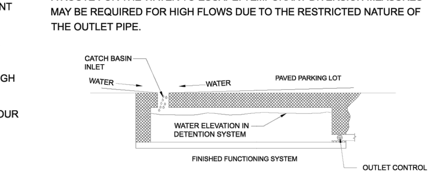

CMP DETENTION SYSTEM INSPECTION AND MAINTENANCE

UNDERGROUND STORMWATER DETENTION AND INFILTRATION SYSTEMS MUST BE INSPECTED AND MAINTAINED AT REGULAR INTERVALS FOR PURPOSES OF PERFORMANCE AND LONGEVITY.

INSPECTION

INSPECTION IS THE KEY TO EFFECTIVE MAINTENANCE OF CMP DETENTION SYSTEMS AND IS EASILY PERFORMED. CONTECH RECOMMENDS ONGOING, ANNUAL INSPECTIONS. SITES WITH HIGH TRASH LOAD OR SMALL OUTLET CONTROL ORIFICES MAY NEED MORE FREQUENT INSPECTIONS. THE RATE AT WHICH THE SYSTEM COLLECTS POLLUTANTS WILL DEPEND MORE ON SITE SPECIFIC ACTIVITIES RATHER THAN THE SIZE OR CONFIGURATION OF THE SYSTEM.

INSPECTIONS SHOULD BE PERFORMED MORE OFTEN IN EQUIPMENT WASHDOWN AREAS, IN CLIMATES WHERE SANDING AND/OR SALTING OPERATIONS TAKE PLACE, AND IN OTHER VARIOUS INSTANCES IN WHICH ONE WOULD EXPECT HIGHER ACCUMULATIONS OF SEDIMENT OR ABRASIVE/ CORROSIVE CONDITIONS. A RECORD OF EACH INSPECTION IS TO BE MAINTAINED FOR THE LIFE OF THE SYSTEM

MAINTENANCE

CMP DETENTION SYSTEMS SHOULD BE CLEANED WHEN AN INSPECTION REVEALS ACCUMULATED SEDIMENT OR TRASH IS CLOGGING THE DISCHARGE ORIFICE.

ACCUMULATED SEDIMENT AND TRASH CAN TYPICALLY BE EVACUATED THROUGH THE MANHOLE OVER THE OUTLET ORIFICE. IF MAINTENANCE IS NOT PERFORMED AS RECOMMENDED, SEDIMENT AND TRASH MAY ACCUMULATE IN FRONT OF THE OUTLET ORIFICE. MANHOLE COVERS SHOULD BE SECURELY SEATED FOLLOWING CLEANING ACTIVITIES. CONTECH SUGGESTS THAT ALL SYSTEMS BE DESIGNED WITH AN ACCESS/INSPECTION MANHOLE SITUATED AT OR NEAR THE INLET AND THE OUTLET ORIFICE. SHOULD IT BE NECESSARY TO GET INSIDE THE SYSTEM TO PERFORM MAINTENANCE ACTIVITIES, ALL APPROPRIATE PRECAUTIONS REGARDING CONFINED SPACE ENTRY AND OSHA REGULATIONS SHOULD BE FOLLOWED.

How to maintain if there is no outlet orifice?

ANNUAL INSPECTIONS ARE BEST PRACTICE FOR ALL UNDERGROUND SYSTEMS. DURING THIS INSPECTION, IF EVIDENCE OF SALTING/DE-ICING AGENTS IS OBSERVED WITHIN THE SYSTEM, IT IS BEST PRACTICE FOR THE SYSTEM TO BE RINSED, INCLUDING ABOVE THE SPRING LINE SOON AFTER THE SPRING THAW AS PART OF THE MAINTENANCE PROGRAM FOR THE SYSTEM.

MAINTAINING AN UNDERGROUND DETENTION OR INFILTRATION SYSTEM IS EASIEST WHEN THERE IS NO FLOW ENTERING THE SYSTEM. FOR THIS REASON, IT IS A GOOD IDEA TO SCHEDULE THE CLEANOUT DURING DRY WEATHER.

THE FOREGOING INSPECTION AND MAINTENANCE EFFORTS HELP ENSURE UNDERGROUND PIPE SYSTEMS USED FOR STORMWATER STORAGE CONTINUE TO FUNCTION AS INTENDED BY IDENTIFYING RECOMMENDED REGULAR INSPECTION AND MAINTENANCE PRACTICES. INSPECTION AND MAINTENANCE RELATED TO THE STRUCTURAL INTEGRITY OF THE PIPE OR THE SOUNDNESS OF PIPE JOINT CONNECTIONS IS BEYOND THE SCOPE OF THIS GUIDE.

C:\USERS\JEREMY.JOHNSON\DOCUMENTS\DYO\CMP_V10.DWG 10/18/2019 10:02 AM

The design and information shown on this drawing is provided as a service to the project owner, engineer and contractor by Contech Engineered Solutions LLC ("Contech"). Neither this drawing, nor any part thereof, may be used, reproduced or modified in any manner without the prior written consent of Contech. Failure to comply is done at the user's own risk and Contech expressly disclaims any liability or responsibility for such use.

If discrepancies between the supplied information upon which the drawing is based and actual field conditions are encountered as site work progresses, these discrepancies must be reported to Contech immediately for re-evaluation of the design. Contech accepts no liability for designs based on missing, incomplete or inaccurate information supplied by others.

DATE	REVISION DESCRIPTION	BY

CONTECH® ENGINEERED SOLUTIONS LLC
www.ContechES.com
9025 Centre Pointe Dr., Suite 400, West Chester, OH 45069
800-338-1122 513-645-7000 513-645-7993 FAX

CONTECH® CMP DETENTION SYSTEMS
CONTECH DYODS DRAWING

DYO51037 Gunther
Gunther
American Fork, UT
DETENTION SYSTEM

RETENTION

PROJECT No.: 35504	SEQ. No.: 51037	DATE: 9/26/2024
DESIGNED: DYO	DRAWN: DYO	
CHECKED: DYO	APPROVED: DYO	
SHEET NO.: 1		

PERIGEE CONSULTING
CIVIL • STRUCTURAL • SURVEY
9089 SOUTH 1300 WEST, SUITE 160
WEST JORDAN, UT 84088
801.628.6004 TEL 801.590.6611 FAX
WWW.PERIGEECIVIL.COM

LICENSED PROFESSIONAL ENGINEER
No. 13937226
AUSTIN EARL WEAVER
13 NOV 2024
STATE OF UTAH

AMERICAN FORK CITY

CITY ENGINEER DATE

MARK	DESCRIPTION	DATE	APPR.

DESIGNED BY: AEW
DWN BY: AEW
CKD BY: TVW
SUBMITTED BY:
DATE: 13 NOV 2024
SOLICITATION NO:
CONTRACT NO: 01041
REV:
FILE NAME: N:\01041 Holmes Gunther American Fork\Cadd\IP\13 DT01
PLOTTED BY:
PLOT DATE: 11/14/2024 12:47:36 PM
SIZE: ANSI D

ELLEN'S 2 SUBDIVISION
HOLMES HOMES
CONTECH DETAILS

Blue Stakes of UTAH 811
Bluestakes.org

SHEET NUMBER
20
OF 20 SHEETS

DRAWING NAME
DT08

AS-PROVIDED DESCRIPTION

Parcel 1: [14-018-0188]
Beginning at a point that lies North 1045.310 feet and East 150.390 feet from the West Quarter Corner of Section 18, Township 5 South, Range 2 East, Salt Lake Base and Meridian and running thence South 89°44'26" East 340.800 feet to a point on an existing fence line; thence along said existing fence line the following (2) courses: 1) South 00°32'17" East 35.301 feet; 2) South 00°09'57" West 54.701 feet to a point on the Southerly Line of Parcel No. 14:018:0154 as described in a Special Warranty Deed recorded as Entry No. 17293:2015 in the Utah County Recorders Office; thence along said Parcel No. 14:018:0154 North 89°57'00" East 0.848 feet; thence South 00°00'26" East 70.035 feet to a point on the North Line of Lot 16 of Temple Haven Plat A subdivision; thence along said North Line and North Line extended South 86°32'53" West 0.661 feet; thence South 00°19'07" West 18.951 feet; thence South 89°59'34" West 399.452 feet; thence North 89°23'25" East 60.310 feet; thence North 00°36'31" West 179.980 feet to the point of beginning.

Less and excepting:
Beginning at the Southeast Corner of Lot 1, Plat "A" Amended, Ellen Subdivision, said point being North 00°24'54" West 953.84 feet and East 16.73 feet and North 89°23'25" East 141.53 feet from the West Quarter Corner of Section 18, Township 5 South, Range 2 East, Salt Lake Base and Meridian and running; thence North 00°36'35" West along the Easterly line of said Lot 1, 90.00 feet to the Northeast corner said Lot 1; thence South 89°44'00" East 60.00 feet; thence South 33°20'56" West 107.400 feet to the point of beginning.


Parcel 2: [14-018-0190]
Beginning at a point that lies North 863.830 feet and East 10.910 feet from the West Quarter Corner of Section 18, Township 5 South, Range 2 East, Salt Lake Base and Meridian and running thence North 89°23'25" East 80.940 feet; thence East 399.606 feet; thence South 00°19'07" West 139.099 feet to an existing fence line; thence along said existing fence line North 86°16'34" East 1.431 feet; thence South 209.066 feet; thence West 476.950 feet; thence North 00°42'00" West 347.230 feet to the point of beginning.

SURVEYORS COMMENTS

1. THE CERTIFYING SURVEYOR HAS NOT MADE AN INDEPENDENT TITLE SEARCH AND HAS RELIED SOLELY ON SUPPLIED DOCUMENTATION SHOWN IN A PRELIMINARY TITLE REPORT PROVIDED BY FIRST AMERICAN TITLE INSURANCE COMPANY, FILE NO. 336468, 7TH AMENDED, COMMITMENT DATE SEPTEMBER 10, 2024, AND SPECIFICALLY DISCLAIMS ANY ITEMS NOT SHOWN WHICH MAY OR MAY NOT BE OF PUBLIC RECORD THAT MIGHT AFFECT THE PROPERTY SHOWN ON THIS SURVEY.
2. ADDRESS:
   900 East, American Fork, UT 84003
3. SUBJECT PROPERTY HAS NO OBSERVABLE EVIDENCE OF RECENT CONSTRUCTION. NO EVIDENCE OF RECENT STREET OR SIDEWALK CONSTRUCTION OR REPAIRS WERE OBSERVED IN THE PROCESS OF CONDUCTING THE FIELDWORK. IMPROVEMENTS SHOWN REPRESENT SITE CONDITIONS AT TIME OF SURVEY, BUT MAY BE SUBJECT TO CHANGE.
4. SUBJECT PROPERTY HAS NO OBSERVABLE EVIDENCE OF CEMETERIES OR BURIAL GROUNDS.
5. THE SURVEYOR RELIED ON A COMMITMENT FOR TITLE INSURANCE, FIRST AMERICAN TITLE INSURANCE COMPANY, FILE NO. 336468, 7TH AMENDED, COMMITMENT DATE SEPTEMBER 10, 2024, AND DID NOT RESEARCH CHAIN OF TITLE OR SENIOR RIGHTS.
6. THE SURVEYOR MADE A PRUDENT ATTEMPT TO DISCLOSE ALL RECORD EASEMENTS SHOWN ON SAID COMMITMENT FOR TITLE INSURANCE AS WELL AS LOCATING VISIBLE UTILITY STRUCTURES AND OTHER STRUCTURES BUT DOES NOT WARRANT THEM TO BE ALL INCLUSIVE.
7. A PORTION OF THE PROPERTY HAS ACCESS TO 900 EAST STREET AND 490 NORTH STREET (PUBLIC STREETS).
8. NEAREST INTERSECTING STREETS SHOWN ON PLANS
9. TAX PARCEL NUMBER: 14:018:0131 & 14:018:0132
10. JOB NO. 01010

ALTA / NSPS LAND TITLE SURVEY
PREPARED FOR
Holmes Homes, Inc.

BEING A PORTION OF THE NORTHWEST QUARTER OF SECTION 18,
TOWNSHIP 5 SOUTH, RANGE 2 EAST,
SALT LAKE BASE & MERIDIAN

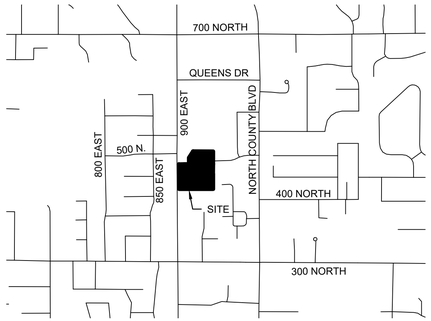

VICINITY MAP

AREA

PARCEL 1: 1.344 ACRES MORE OR LESS.
PARCEL 2: 3.824 ACRES MORE OR LESS.

ZONING

NOT PROVIDED BY TITLE COMMITMENT

BASIS OF BEARING

NORTH 0°25'21" WEST 2670.001' - BEING THE WEST LINE OF THE NORTHWEST QUARTER OF SECTION 18, TOWNSHIP 5 SOUTH, RANGE 2 EAST, SALT LAKE BASE & MERIDIAN

FLOOD INSURANCE DATA

FLOOD ZONE DESIGNATION "X" PER F.E.M.A. FLOOD INSURANCE RATE MAP, MAP NUMBER 49049C0169F, DATE JUNE 19, 2020 (NOT PRINTED).

ZONE "X" - AREA OF MINIMAL FLOOD HAZARD

(THE ABOVE STATEMENT IS FOR INFORMATION ONLY AND THE SURVEYOR ASSUMES NO LIABILITY FOR THE CORRECTNESS OF THE CITED MAP OR THE LOCATION OF THE FLOOD ZONE BOUNDARY. IN ADDITION, THE ABOVE STATEMENT DOES NOT REPRESENT THE SURVEYOR'S OPINION OF THE PROBABILITY OF FLOODING.)

PARKING STALLS

NO PARKING STALLS OBSERVED ON SITE AT TIME OF SURVEY

NARRATIVE:

1. THE PURPOSE OF THIS SURVEY IS TO PROVIDE AN ALTA/NSPS SURVEY TO SHOW ALL IMPROVEMENTS AND STRUCTURES RELATIVE TO BOUNDARY LINES.

SURVEYOR'S CERTIFICATE

TO: Holmes Homes, Inc., a Utah corporation
First American Title Insurance Company

THIS IS TO CERTIFY THAT THIS MAP OR PLAT AND THE SURVEY ON WHICH IT IS BASED WERE MADE IN ACCORDANCE WITH THE 2021 MINIMUM STANDARD DETAIL REQUIREMENTS FOR ALTA/NSPS LAND TITLE SURVEYS, JOINTLY ESTABLISHED AND ADOPTED BY ALTA AND NSPS, AND INCLUDES ITEMS 2, 3, 4, 7(a), 8, 9, 13 & 14 OF TABLE A THEREOF. THE FIELD WORK WAS COMPLETED ON NOVEMBER 12, 2024.



ERIC D. ROBINS P.L.S. 5152671
STATE OF UTAH
PERIGEE CONSULTING
9089 SOUTH 1300 WEST SUITE 160
WEST JORDAN, UTAH 84088

SCHEDULE "B" ITEMS

1. Any facts, rights, interests, or claims which are not shown by the Public Records but which could be ascertained by an inspection of the land or which may be asserted by persons in possession, or claiming to be in possession, thereof.
2. Easements, liens, encumbrances, or claims thereof, which are not shown by the Public Records.
3. Discrepancies, conflicts in boundary lines, shortage in area, encroachments, or any other facts which a correct survey of the land would disclose, and which are not shown by the Public Records.
4. Any lien, or right to a lien, imposed by the law for services, labor, or material heretofore or hereafter furnished, which lien, or right to a lien, is not shown by the Public Record.
5. (a) Unpatented mining claims; (b) reservations or exceptions in patents or in Acts authorizing the issuance thereof; (c) Indian treaty or aboriginal rights, including, but not limited to, easements or equitable servitudes; or, (d) water rights, claims or title to water, whether or not the matters excepted under (a), (b), (c), or (d) are shown by the Public Records.
6. Taxes or assessments which are not now payable or which are not shown as existing liens by the records of any taxing authority that levies taxes or assessments on real property or by the Public Records; proceedings by a public agency which may result in taxes or assessments, or notices of such proceedings, whether or not shown by the records of such agency or by the Public Records.
7. Any service, installation, connection, maintenance or construction charges for sewer, water electricity, or garbage collection or disposal or other utilities unless shown as an existing lien by the Public Records.
8. Any defect, lien, encumbrance, adverse claim, or other matter that appears for the first time in the Public Records or is created, attaches, or is disclosed between the Commitment Date and the date on which all of the Schedule B, Part I—Requirements are met.
9. Tax parcel number for tax year 2025 will be 14-018-0188.

   Taxes for the year 2024 are now a lien not yet due and payable. Taxes for the year 2023 have been paid in the amount of $4,732.62. Property I.D. No. 14-018-0131. (Parcel 1)
10. Tax parcel number for tax year 2025 will be 14-018-0190.

    Taxes for the year 2024 are now a lien not yet due and payable. Taxes for the year 2023 have been paid in the amount of $12,871.87. Property I.D. No. 14-018-0132. (Parcel 2)
11. Said property is located within the boundaries of American Fork, Utah County, Central Utah Water Conservancy District, and NUCW District, and is subject to the charges and assessments levied thereunder.
12. Rights of Way, Easements, Ditches, Canals or any other adverse matters which may be disclosed by Inspection or Survey of said Property.
13. An Easement including its terms, covenants and provisions as disclosed by instrument;
    To: Utah Power & Light Company
    Purpose: a perpetual easement and right of way for the erection and continued maintenance, repair, alterations, and replacement of the electric transmission, distribution and telephone circuits of the Grantee, and no guys and 2 poles, with the necessary guys, stubs, cross-arms and other attachments thereon, or affixed thereto, for the support of said circuits, to be erected and maintained upon and across the premises
    Recorded: May 25, 1929 as Entry No. 4308 in Book 271 at Page 207 of Public Records.
    Affects: See document for full particulars (Parcel 2)
14. An Easement including its terms, covenants and provisions as disclosed by instrument;
    To: Utah Power & Light Company
    Purpose: a perpetual easement and right of way for the construction, operation, maintenance, repair, alteration, enlargement, inspection, relocation and replacement of underground electric transmission and distribution lines, communications circuits, fiber optic cables and associated facilities, with the necessary transformers, transformer pads, pull boxes, service pedestals, control buildings and other facilities related thereto, on, over, under and across
    Recorded: March 8, 1989 as Entry No. 5904 in Book 2581 at Page 860 of Public Records.
    Affects: See document for full particulars (Parcel 2)
15. Any rights, interest, or claims which may exist or arise by reason of the fact(s) referenced on a survey plat designated dated May 22, 2024, prepared by Perigee Consulting.
16. A Boundary Line Agreement, including its terms, covenants and provisions
    By and Between: Dean Gunther and Deana Gunther, as Trustees of the Gunther Family Trust U/A/D The 6th Day of December 1993
    And: Michael A Summers and Melinda A Summers
    Recorded: July 22, 2024 as Entry No. 48434:2024_ in of Public Records.
17. A Boundary Line Agreement, including its terms, covenants and provisions
    By and Between: Dean Gunther and Deana Gunther, as Trustees of the Gunther Family Trust U/A/D The 6th Day of December 1993
    And: Cory C. Banks and Lindsey Banks
    Recorded: July 22, 2042 as Entry No. 48435:2024 of Public Records.
18. A Boundary Line Agreement, including its terms, covenants and provisions
    By and Between: Dean Gunther and Deana Gunther, as Trustees of the Gunther Family Trust U/A/D The 6th Day of December 1993
    And: Cory C. Banks and Lindsey Banks
    Recorded: July 22, 2024 as Entry No. 48436:2024 of Public Records.
19. Materials or labor liens created or authorized by law of which no notice is of record. Including, but not limited to, the State Construction Registry.
20. Any invalidity or defect in the title of the vestees in the event that the trust referred to in the vesting portion of Schedule A is invalid or fails to grant sufficient powers to the trustee(s) or in the event there is a lack of compliance with the terms and provisions of the trust instrument.
21. If title is to be insured in the trustee(s) of a trust, (or if their act is to be insured), this Company will require a copy of the trust instrument creating such trust, and all amendments thereto, together with a written verification by all present trustees that the copy is the true and correct copy of the trust, as it may have been amended, that it is in full force and effect and that it has not been revoked or terminated.

SCHEDULE "B" NOTES

ITEMS 1-12:	INFORMATION / BLANKET
ITEM 13:	AFFECTS PARCEL 2 - PLOTTED, SHOWN ON SHEET 2
ITEM 14:	AFFECTS PARCEL 2 - PLOTTED, SHOWN ON SHEET 2
ITEM 15:	AFFECTS, BLANKET - PLOTTED, SHOWN ON SHEET 2
ITEM 16:	AFFECTS EAST LINE OF PARCEL 1 - PLOTTED, SHOWN ON SHEET 2
ITEM 17:	AFFECTS EAST LINE OF PARCEL 1 - PLOTTED, SHOWN ON SHEET 2
ITEM 18:	AFFECTS EAST LINE OF PARCEL 2 - PLOTTED, SHOWN ON SHEET 2
ITEM 19:	AFFECTS PER TITLE REPORT - NOT PLOTTED
ITEM 20:	AFFECTS PER TITLE REPORT - NOT PLOTTED
ITEM 21:	AFFECTS PER TITLE REPORT - NOT PLOTTED

PERIGEE CONSULTING
CIVIL • STRUCTURAL • SURVEY
9089 SOUTH 1300 WEST, SUITE 160 WEST JORDAN, UT 84088
801.628.6004 TEL 801.590.6611 FAX WWW.PERIGEECIVIL.COM

CITY ENGINEER DATE

MARK	DESCRIPTION	DATE	APPR.

DESIGNED BY:	MB
DWN BY:	
CKD BY:	
SUBMITTED BY:	
FILE NAME:	
SIZE:	ANSI D
DATE:	
SOLICITATION NO:	
CONTRACT NO:	
PLOTTED BY:	
PLOT DATE:	
REV:	


ALTA / NSPS LAND TITLE SURVEY PREPARED FOR HOLMES HOMES, INC.

SHEET NUMBER
1 OF 2

DRAWING NAME
COVER

ALTA / NSPS LAND TITLE SURVEY
PREPARED FOR
Holmes Homes, Inc.

BEING A PORTION OF THE NORTHWEST QUARTER OF SECTION 18,
TOWNSHIP 5 SOUTH, RANGE 2 EAST,
SALT LAKE BASE & MERIDIAN

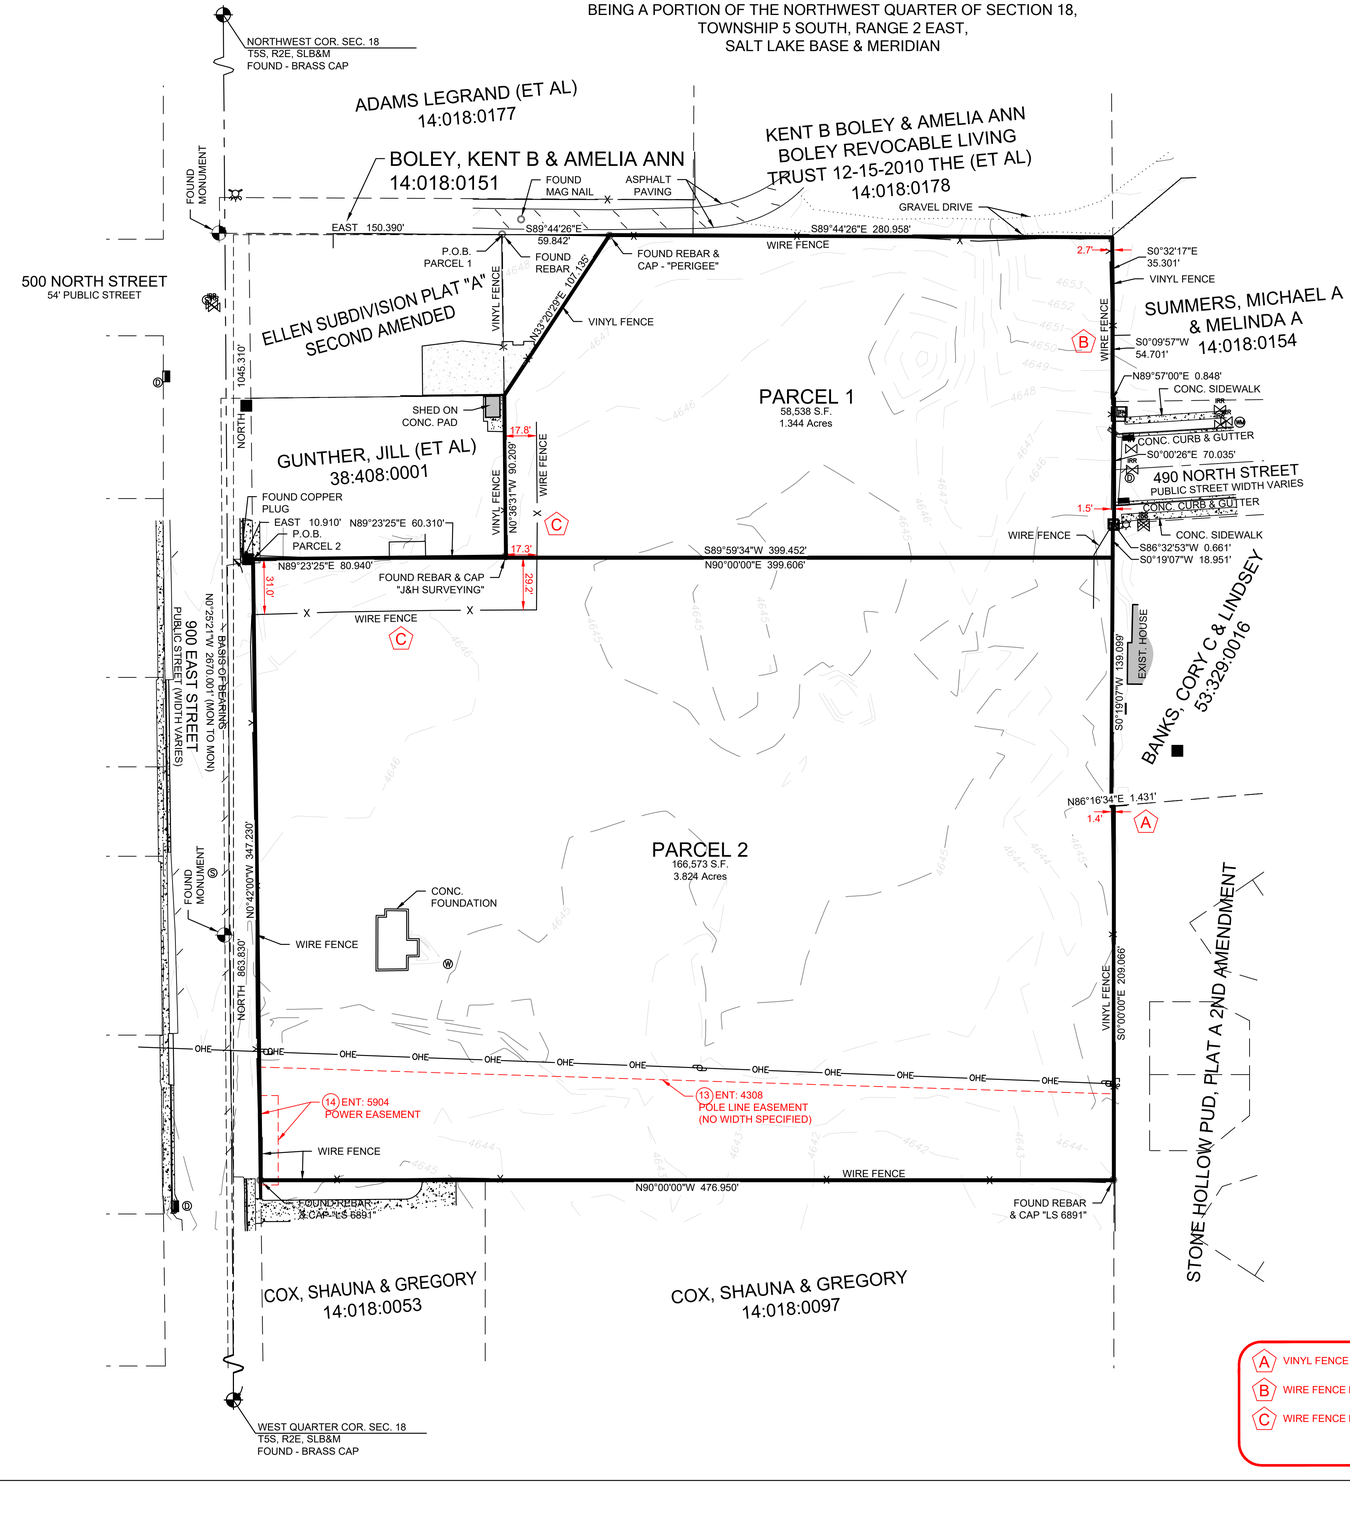

SYMBOL LEGEND	
	STREET LIGHT
TEL	TELEPHONE BOX
WV	WATER VALVE
WM	WATER METER
D	STORM DRAIN MANHOLE
	MONUMENT AS MARKED
	SURVEY MARKER
ELEC	ELECTRICAL BOX
	STORM DRAIN CURB INLET
	STORM DRAIN INLET
IRR	IRRIGATION VALVE
S	SEWER MANHOLE
W	WELL

POSSIBLE ENCROACHMENTS

- A — VINYL FENCE LIES OVER BOUNDARY LINE BY UP TO 1.4 FEET
- B — WIRE FENCE LIES OVER BOUNDARY LINE BY UP TO 2.7 FEET
- C — WIRE FENCE LIES OVER BOUNDARY LINE BY UP TO 31.0 FEET

GRAPHIC SCALE

-40 0 20 40 80

(IN FEET)
1 Inch = 40 ft.

PERIGEE CONSULTING
CIVIL • STRUCTURAL • SURVEY
9089 SOUTH 1300 WEST, SUITE 160 WEST JORDAN, UT 84088
801.628.6004 TEL 801.590.6611 FAX WWW.PERIGEECIVIL.COM

CITY ENGINEER DATE

MARK	DESCRIPTION	DATE	APPR.

REV:	DATE:	SOLICITATION NO.	CONTRACT NO.	PLOT DATE:
DESIGNED BY: MB	CKD BY:	SUBMITTED BY:	FILE NAME:	PLOTTED BY:
DWN BY:			SIZE: ANSI D	

ALTA / NSPS LAND TITLE SURVEY PREPARED FOR HOLMES HOMES, INC.

SHEET NUMBER
2 OF 2

DRAWING NAME
ALTA

American Fork City Development Review Committee	
EC/LID Reviewed tmezenen 11/27/2024	Planning and Zoning Reviewed tvanekelenburg 11/20/2024
	Fire Department Reviewed M. Sacco 11/18/2024
	Engineering Division Reviewed rburkhill 11/20/2024
	Water/PI Division Reviewed jbrems 11/26/2024
Sewer/Storm Drain Division Reviewed ascott 11/27/2024	Streets Division Reviewed ehyde 11/26/2024

Address comments

Re-Submittal Acknowledgment Statement
The applicant is responsible for reviewing all documents to ensure all comments have been addressed.

_____ [Applicant Initial] I understand that a Review Cycle is not complete unless and until the applicant replies to all of the required modifications and requests for additional information noted on the previous submittal.

_____ [Applicant Initial] I hereby acknowledge that this re-submittal addresses all required modifications and requests for additional information noted on the previous submittal.

_____ [Applicant Initial] This is the _____ [Ex: 1st] complete re-submittal of the subdivision constituting the start of the _____ [Same Number] Review Cycle.

Next Step

Proceed to the Development Review Committee 12.02.2024

DRC Plan Review Meetings

These meetings are available with staff on Tuesdays from 9:00 AM-12:00 PM in 30 minute appointments.

Meetings can be scheduled with Melissa White at mwhite@americanfork.gov or through 801-854-5932

Planning Comments/Recommendations
1. Adjust all lots as called out in the initial review for R1-9000 zoning lot requirements.
2. Please add building envelopes for all lots. As there are irregular lots in this sub, we need to be able to see that the front lot width requirement is met at the front setback for all lots.
3. Please add perimeter fencing for the project.
4. Please show lot frontage that the direction of the front elevation of the home is aligned with the width requirement of the lots, starting with lots 1, 3, 7, 12, and 14.
5. Please revise lot 8 to show min width and depth requirements are met at the front setback.


ELLEN'S 2 SUBDIVISION

SUBDIVISION

BEING A PORTION OF THE NORTHWEST QUARTER OF SECTION 18, TOWNSHIP 5 SOUTH, RANGE 2 EAST, SALT LAKE BASE & MERIDIAN

After reviewing lot 8, it was determined that due to the boundary line offset shown that the lot is substandard for lot width at the front setback. Please revise.

Drainage system also impacts lot 2

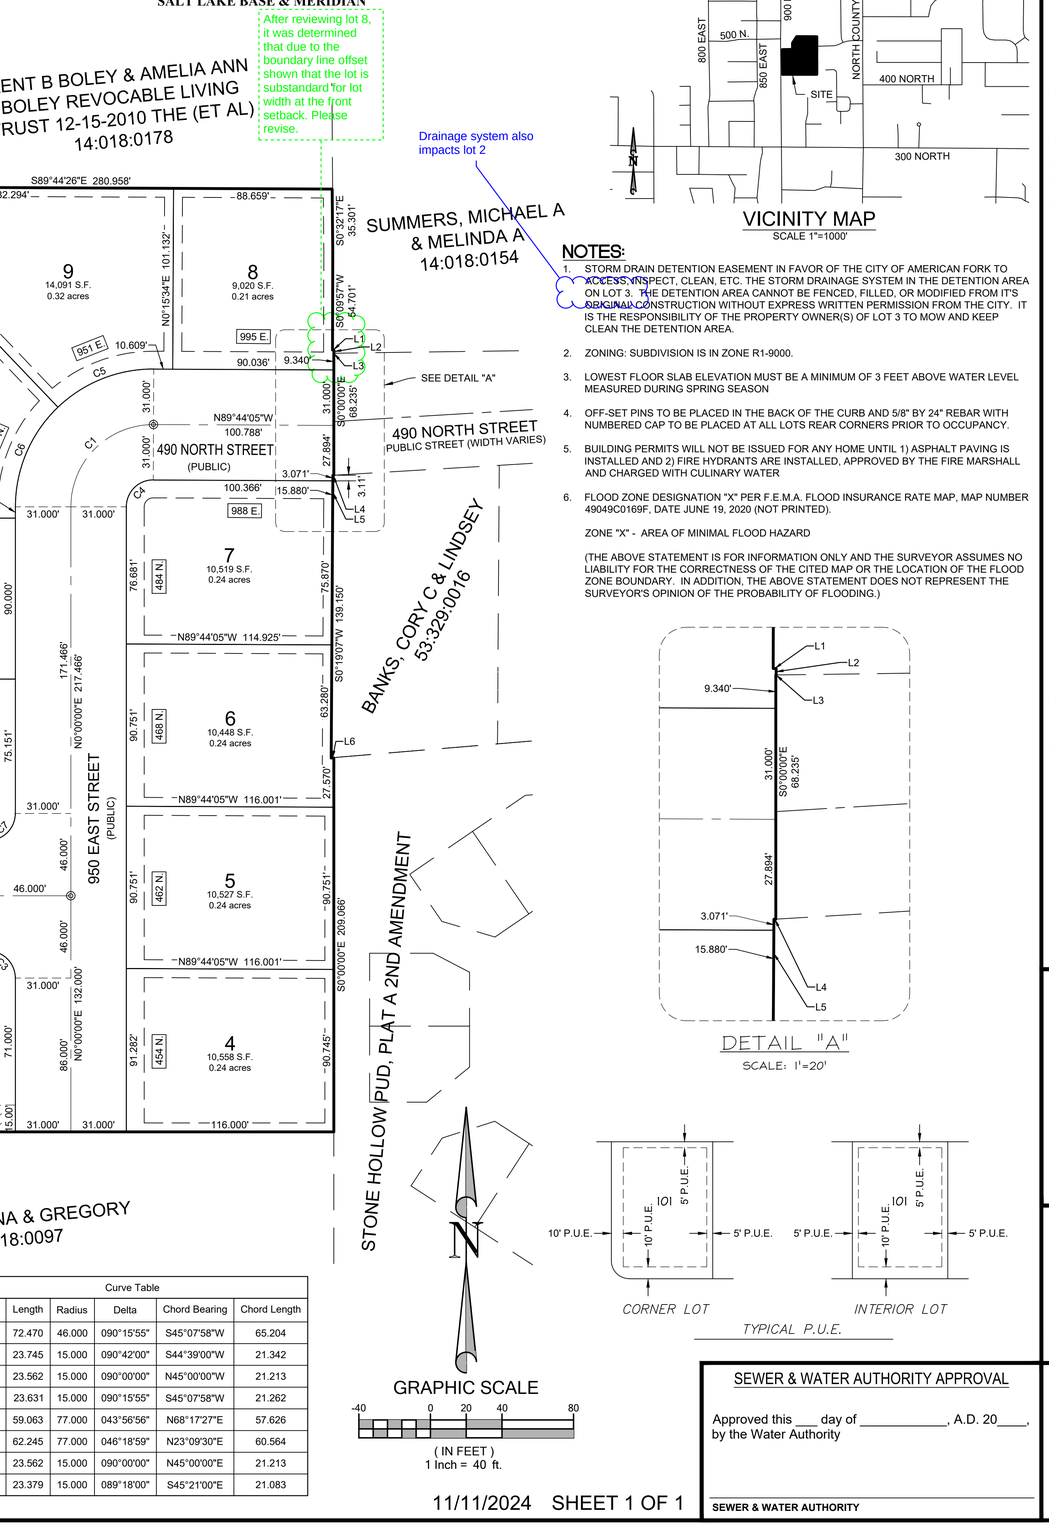

VICINITY MAP
SCALE 1"=1000'

NOTES:

1. STORM DRAIN DETENTION EASEMENT IN FAVOR OF THE CITY OF AMERICAN FORK TO ACCESS, INSPECT, CLEAN, ETC. THE STORM DRAINAGE SYSTEM IN THE DETENTION AREA ON LOT 3. THE DETENTION AREA CANNOT BE FENCED, FILLED, OR MODIFIED FROM IT'S ORIGINAL CONSTRUCTION WITHOUT EXPRESS WRITTEN PERMISSION FROM THE CITY. IT IS THE RESPONSIBILITY OF THE PROPERTY OWNER(S) OF LOT 3 TO MOW AND KEEP CLEAN THE DETENTION AREA.
2. ZONING: SUBDIVISION IS IN ZONE R1-9000.
3. LOWEST FLOOR SLAB ELEVATION MUST BE A MINIMUM OF 3 FEET ABOVE WATER LEVEL MEASURED DURING SPRING SEASON
4. OFF-SET PINS TO BE PLACED IN THE BACK OF THE CURB AND 5/8" BY 24" REBAR WITH NUMBERED CAP TO BE PLACED AT ALL LOTS REAR CORNERS PRIOR TO OCCUPANCY.
5. BUILDING PERMITS WILL NOT BE ISSUED FOR ANY HOME UNTIL 1) ASPHALT PAVING IS INSTALLED AND 2) FIRE HYDRANTS ARE INSTALLED, APPROVED BY THE FIRE MARSHALL AND CHARGED WITH CULINARY WATER
6. FLOOD ZONE DESIGNATION "X" PER F.E.M.A. FLOOD INSURANCE RATE MAP, MAP NUMBER 49049C0169F, DATE JUNE 19, 2020 (NOT PRINTED).

   ZONE "X" - AREA OF MINIMAL FLOOD HAZARD

   (THE ABOVE STATEMENT IS FOR INFORMATION ONLY AND THE SURVEYOR ASSUMES NO LIABILITY FOR THE CORRECTNESS OF THE CITED MAP OR THE LOCATION OF THE FLOOD ZONE BOUNDARY. IN ADDITION, THE ABOVE STATEMENT DOES NOT REPRESENT THE SURVEYOR'S OPINION OF THE PROBABILITY OF FLOODING.)

DETAIL "A"
SCALE: 1"=20'

TYPICAL P.U.E.

GRAPHIC SCALE
-40 0 20 40 80
(IN FEET)
1 Inch = 40 ft.

SURVEYOR'S CERTIFICATE

I, Eric D. Robins, do hereby certify that I am a Professional Land Surveyor, and that I hold License No. 5152671 in accordance with the Professional Engineers and Land Surveyors Licensing Act found in Title 58, Chapter 22 of the Utah Code. I further certify by authority of the owners, I have made a survey of the tract of land shown on this plat and described below, and have subdivided said tract of land into lots, and easements and the same has been correctly surveyed and staked on the ground as shown on this plat and that this plat is true and correct

BOUNDARY DESCRIPTION

A parcel of land situated in the Northwest Quarter of Section 18, Township 5 South, Range 2 East, Salt Lake Base and Meridian, said parcel being more particularly described as follows:

Beginning at a point that lies North 00°25'21" West 516.635 feet along the Section Line and East 18.965 feet from the West Quarter Corner of Section 18, Township 5 South, Range 2 East, Salt Lake Base and Meridian and running thence North 00°42'00" West 347.229 feet to the South Line of the Ellen Subdivision Plat "B"; thence along said Ellen Subdivision Plat "B" the following (2) courses: 1) North 89°22'58" East 141.283 feet; 2) North 00°37'02" West 90.000 feet; thence North 33°20'29" East 107.370 feet; thence South 89°44'26" East 280.958 feet to a point on a Boundary Line Agreement recorded as Entry No. 48434:2024 in the Office of the Utah County Recorder; thence along said Boundary Line Agreement the following (2) courses: 1) South 00°32'17" East 35.301 feet; 2) South 00°09'57" West 54.701 feet to the South Line of the Resultant Summers Lot as described in said Boundary Line Agreement; thence along said Resultant Summers Lot North 89°57'00" East 0.848 feet; thence South 00°00'26" East 1.806 feet to the North Line of Temple Haven Plat "A" subdivision; thence along said Temple Haven Plat "A" the following (2) courses: 1) South 89°13'29" West 0.103 feet; 2) South 68.235 feet to a point on a Boundary Line Agreement recorded as Entry No. 48435:2024 in the Office of the Utah County Recorder; thence along said Boundary Line Agreement the following (2) courses: 1) South 86°32'53" West 0.550 feet; 2) South 00°19'07" West 18.951 feet to a point on a Boundary Line Agreement recorded as Entry No. 48436:2024 in the Office of the Utah County Recorder; thence along said Boundary Line Agreement the following (2) courses: 1) South 00°19'07" West 139.150 feet; 2) North 86°16'34" East 1.431 feet to the West Line of Stone Hollow P.U.D. Plat "A" 2nd Amendment; thence along said Stone Hollow P.U.D. Plat "A" 2nd Amendment South 209.066 feet; thence West 476.950 feet to the point of beginning.

Property contains 5.168 acres, 225,125 square feet, 15 Lots

Eric D. Robins
Professional Land Surveyor
Utah Certificate No. 5152671

11/11/24
Date

OWNER'S DEDICATION

We, all of the undersigned owners of all the property described in the Surveyor's Certificate hereon and shown on this map, have caused the same to be subdivided into lots, blocks, streets and easements and do hereby dedicate the streets and other public areas as indicated hereon for perpetual use of the public, the public utility easements to all providers, public or private, and the irrigation easements to all lot owners, and their successors and assigns in perpetuity, In witness whereof ___ have hereunto set ___this _____ day of _____, A.D. 20____.

PRINTED NAME/TITLE _____ SIGNATURE _____

PRINTED NAME/TITLE _____ SIGNATURE _____

ACKNOWLEDGMENT

STATE OF UTAH } S.S.
County of Utah

On this day of _____, 20___, personally appeared before me the signers of the foregoing dedication who duly acknowledge to me that they did execute the same.

I certify under PENALTY OF PERJURY under the laws of the State of Utah that the foregoing paragraph is true and correct.

WITNESS my hand and official seal.

Notary Public Full Name: _____

Commission Number: _____

My commission expires: _____

A Notary Public Commissioned In Utah

ACCEPTANCE BY ADMINISTRATIVE APPROVAL AUTHORITY

The Administrative Approval Authority of American Fork, County of Utah, approves this subdivision and hereby accepts the dedication of all streets and easements for the perpetual use of the public this _____day of _____, A.D. 20____,

Development Services Director

Public Works Director

Fire Chief

ELLEN'S 2 SUBDIVISION

SUBDIVISION

BEING A PORTION OF THE NORTHWEST QUARTER OF SECTION 18, TOWNSHIP 5 SOUTH, RANGE 2 EAST, SALT LAKE BASE & MERIDIAN

DEVELOPER

Holmes Homes
126 Sego Lily Drive, Suite 250
Sandy, Utah 84070
(801) 572-6363

PERIGEE CONSULTING
CIVIL • STRUCTURAL • SURVEY
9089 SOUTH 1300 WEST, SUITE 160 WEST JORDAN, UT 84088
801.628.6004 TEL 801.590.6611 FAX WWW.PERIGEECIVIL.COM

LEGEND

- FOUND UTAH COUNTY SECTION CORNER
- PROPOSED STREET MONUMENT
- BOUNDARY LINE
- ADJACENT PROPERTY LINE
- SECTION LINE
- TIE LINE
- EASEMENT LINE

Line Table		
Line #	Length	Direction
L1	0.848	N89°57'00"E
L2	1.806	S00°00'26"E
L3	0.103	S89°13'29"W
L4	0.550	S86°32'53"W
L5	18.951	S00°19'07"W
L6	1.431	N86°16'34"E

Curve Table					
Curve #	Length	Radius	Delta	Chord Bearing	Chord Length
C1	72.470	46.000	090°15'55"	S45°07'58"W	65.204
C2	23.745	15.000	090°42'00"	S44°39'00"W	21.342
C3	23.562	15.000	090°00'00"	N45°00'00"W	21.213
C4	23.631	15.000	090°15'55"	S45°07'58"W	21.262
C5	59.063	77.000	043°56'56"	N68°17'27"E	57.626
C6	62.245	77.000	046°18'59"	N23°09'30"E	60.564
C7	23.562	15.000	090°00'00"	N45°00'00"E	21.213
C8	23.379	15.000	089°18'00"	S45°21'00"E	21.083

SEWER & WATER AUTHORITY APPROVAL

Approved this ___ day of _____, A.D. 20____, by the Water Authority

SEWER & WATER AUTHORITY

SURVEYORS SEAL	NOTARY SEAL	CITY ENGINEER SEAL	CLERK-RECORDER SEAL
PROFESSIONAL LAND SURVEYOR No. 5152671 ERIC D. ROBINS STATE OF UTAH			

11/11/2024 SHEET 1 OF 1