KEY NOTES ELEVATION GENERAL NOTES:

A. COORDINATE WINDOW HEIGHTS WITH WINDOW TYPE ELEVATIONS AND EXTERIOR ELEVATIONS.
B. MECHANICAL CONTRACTOR TO COMBINE FACE PLATES FOR DRYER VENT AND EXHAUST ON EXTERIOR OF BUILDING.
C. PROVIDE MOVEMENT JOINTS IN THE THIN BRICK VENEER SYSTEM AS DIRECTED PER THE BRICK INDUSTRY ASSOCIATION TECHNICAL NOTES 28C ON BRICK CONSTRUCTION.
D. SHEET METAL FLASHING AND TRIM COLOR TO MATCH THE COLOR OF THE MATERIAL/FINISH THAT THE FLASHING AND TRIM RESTS UPON.
E. FIBER CEMENT TRIM SHOWN AS BASIS-OF-DESIGN. CONTRACTOR TO ADD TRIM AS NECESSARY. PROVIDE ARCHITECT WITH ELEVATIONS OF ANY ADDED TRIM IN FIBER CEMENT SUBMITTAL.
F. PROVIDE CORNER AND PERIMETER TRIM FOR ALUMINUM PLANK SIDING SYSTEM PER MANUFACTURER.

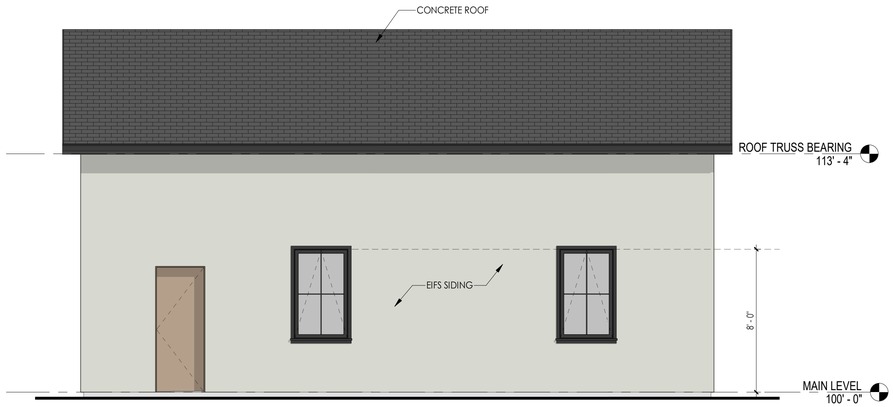

2 A203B GARAGE WEST ELEVATION
1/4" = 1'-0"

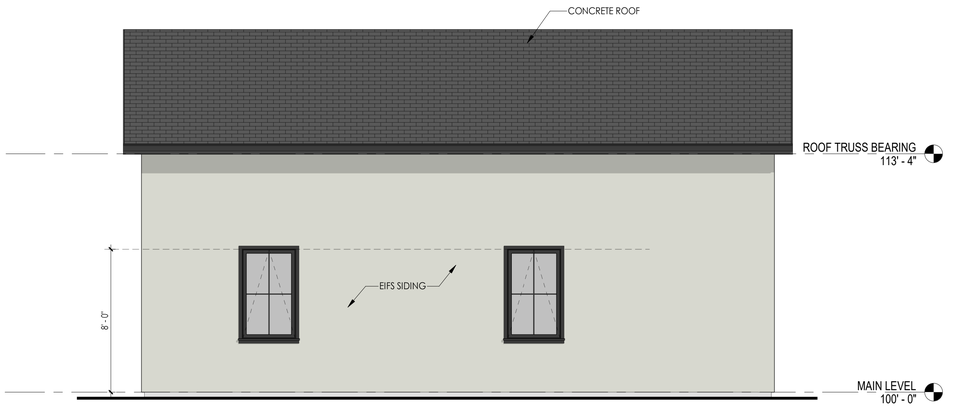

4 A203B GARAGE EAST ELEVATION
1/4" = 1'-0"

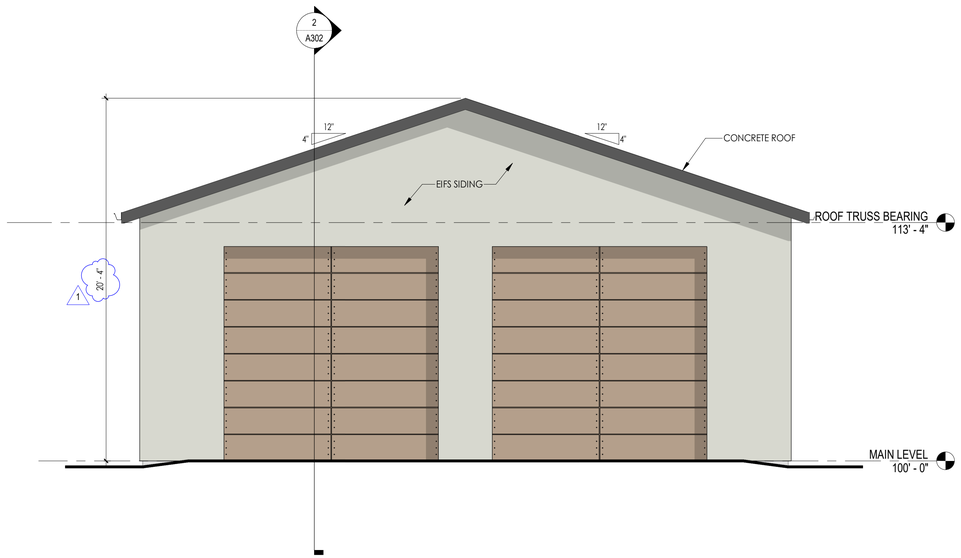

1 A203B GARAGE NORTH ELEVATION
1/4" = 1'-0"

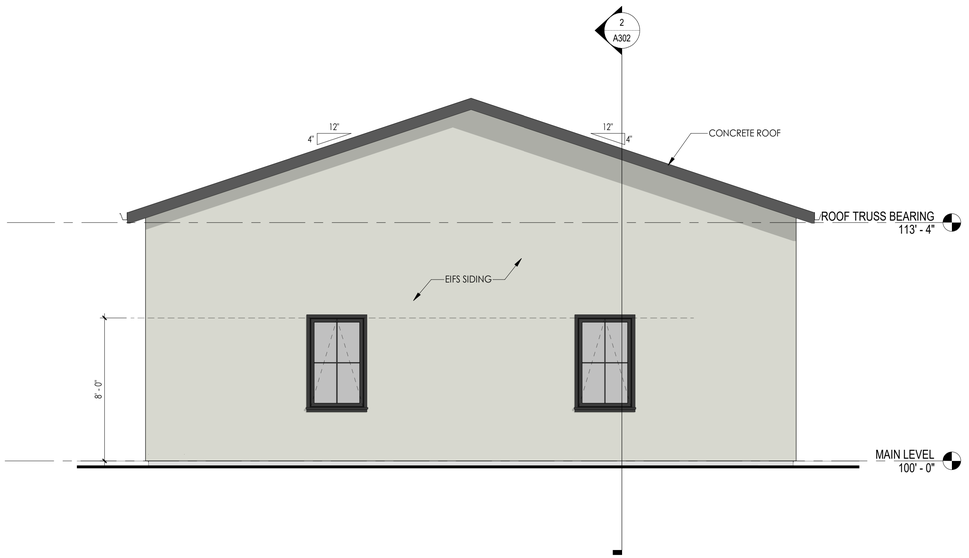

3 A203B GARAGE SOUTH ELEVATION
1/4" = 1'-0"

No.	Description	Date
1	PLAN REVIEW COMMENTS	12.02.2025

RICHINS RESIDENCE

184 S ASH CREEK DR
TOQUERVILLE, UTAH 84774

Project Number	01
Date	11.07.2025
Drawn By	CS
Checked By	Checker
	PLAN REVIEW SET

GARAGE EXTERIOR ELEVATIONS

A203B

12/2/2025 11:27:34 AM